



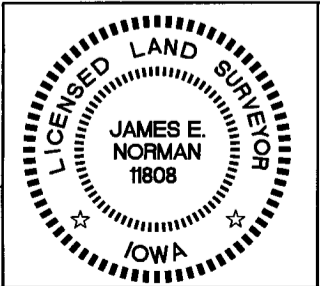

INDX ✓
ANNO ✓
SCAN
CHEK

LISA SMITH, COUNTY RECORDER
MADISON COUNTY IOWA

PREPARED BY: JAMES E. NORMAN-500 EAST TAYLOR-CRESTON, IA 50801-(641)-782-4004

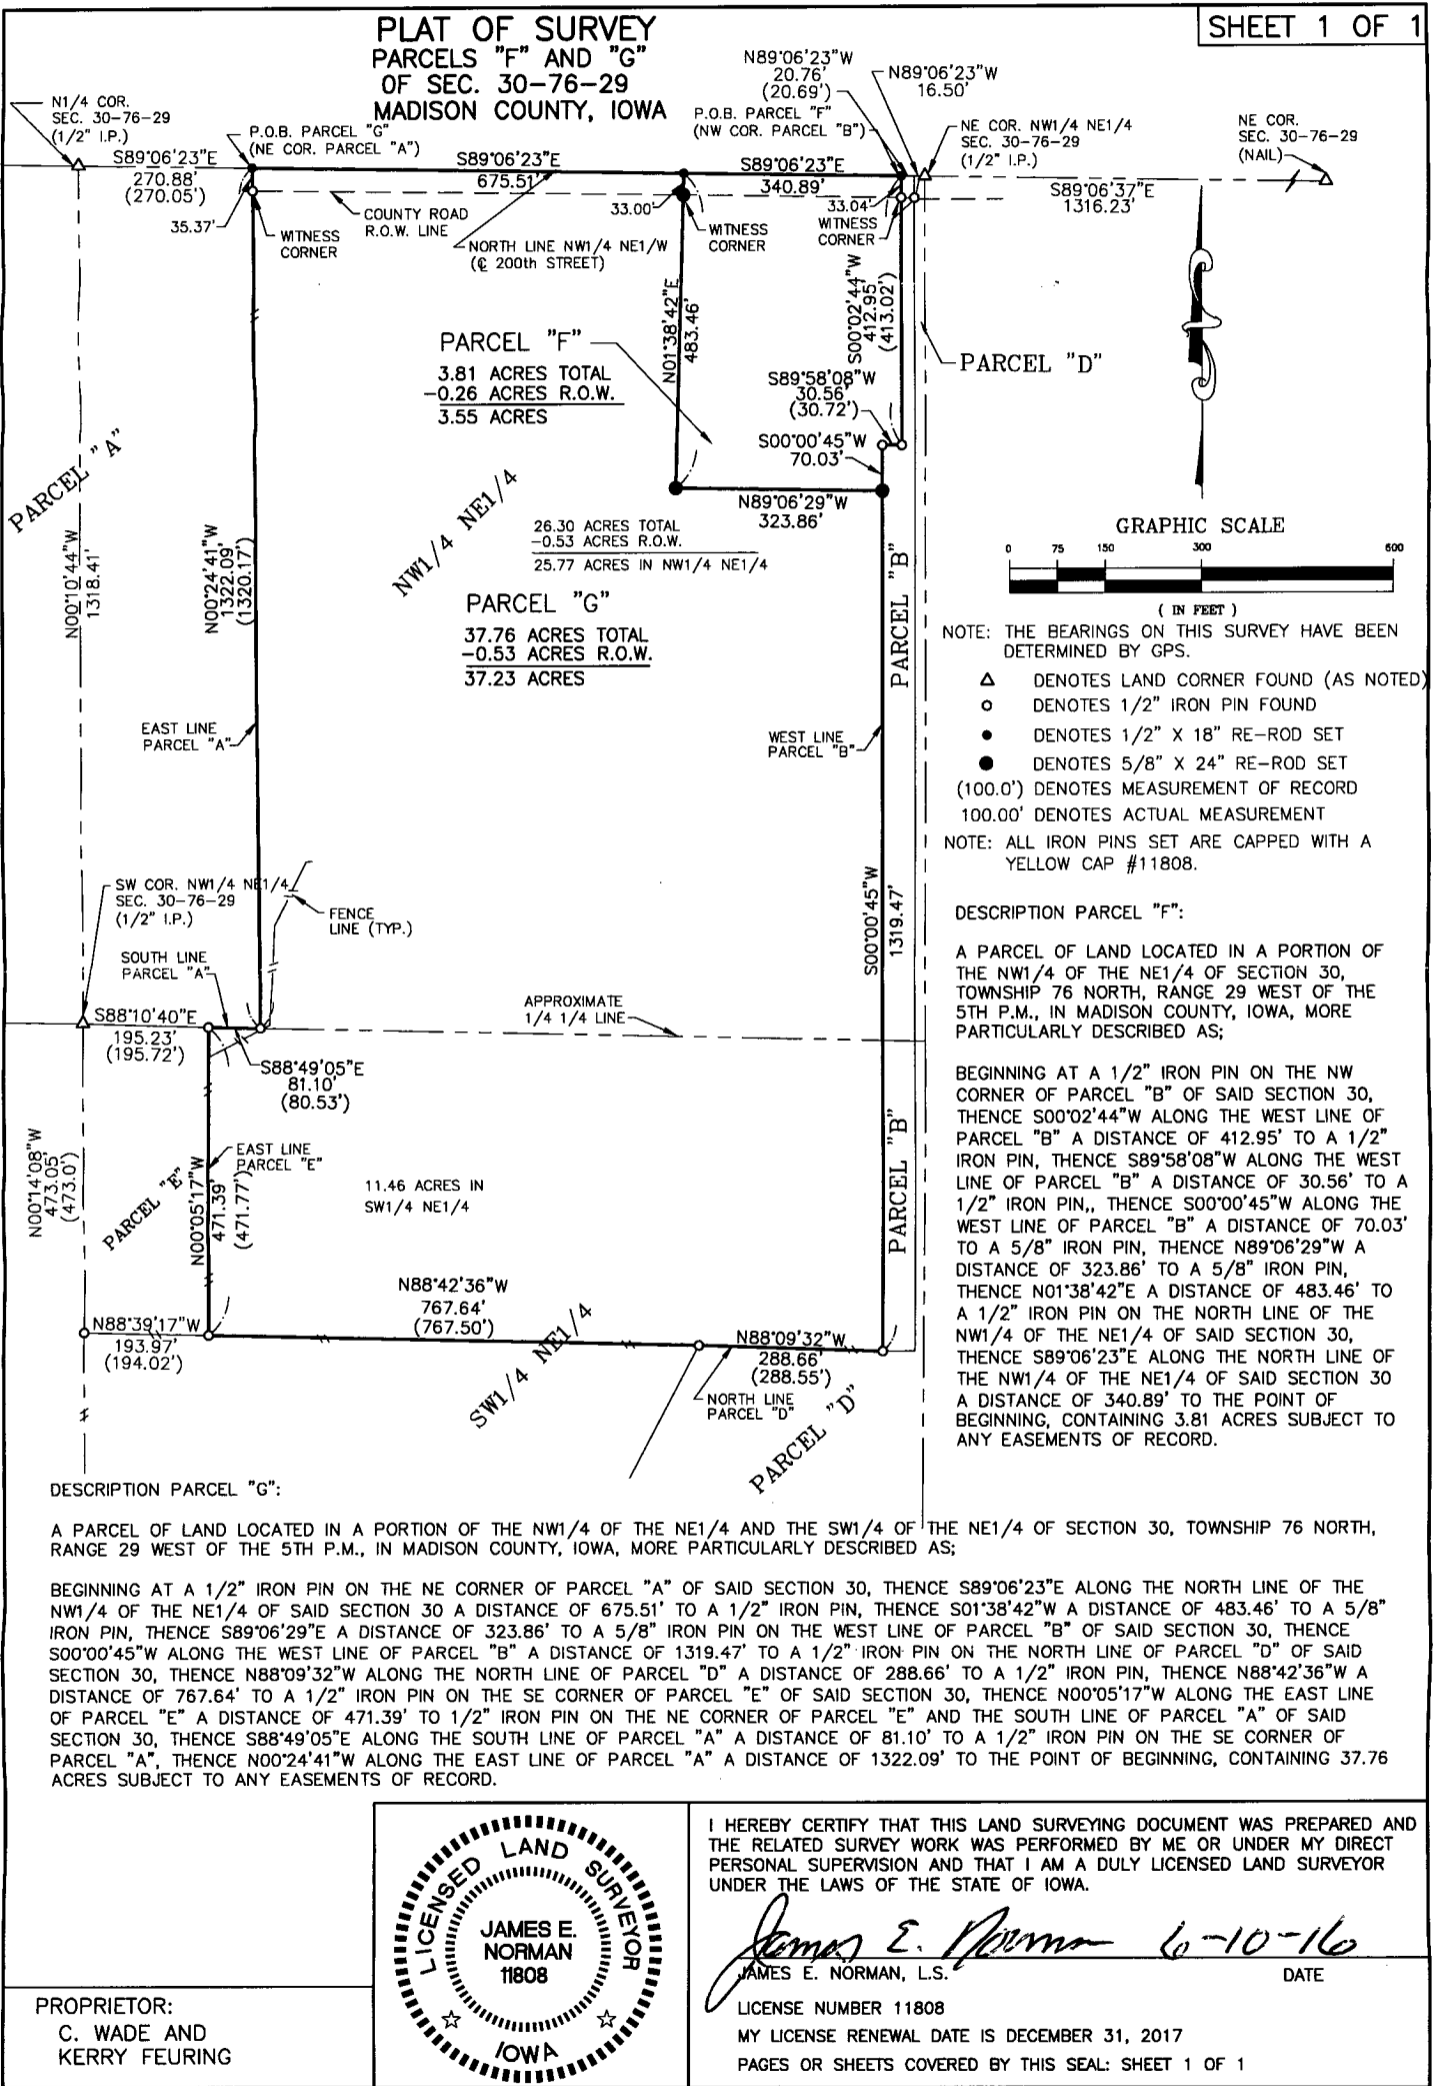

I HEREBY CERTIFY THAT THIS LAND SURVEYING DOCUMENT WAS PREPARED AND THE RELATED SURVEY WORK WAS PERFORMED BY ME OR UNDER MY DIRECT PERSONAL SUPERVISION AND THAT I AM A DULY LICENSED LAND SURVEYOR UNDER THE LAWS OF THE STATE OF IOWA.

James E. Norman 6-10-16
JAMES E. NORMAN, L.S. DATE

PROPRIETOR:
C. WADE AND
KERRY FEURING

LICENSE NUMBER 11808
MY LICENSE RENEWAL DATE IS DECEMBER 31, 2017
PAGES OR SHEETS COVERED BY THIS SEAL: SHEET 1 OF 1

SURVEY FOR: FARMERS NATIONAL
ATTN: JON PETERSON
4949 PLEASANT SUITE 203
WEST DES MOINES, IOWA 50266
PROJ. NO. 16-1995 DATE: 6-7-16

**Mid-State Surveying
and Consulting, Inc.**
500 EAST TAYLOR
CRESTON, IOWA 50801
641-782-4004