



Document 2016 GW1955

Book 2016 Page 1955 Type 43 001 Pages 8  
Date 7/08/2016 Time 1:54:50PM  
Rec Amt \$.00

INDX  
ANNO  
SCAN

LISA SMITH, COUNTY RECORDER  
MADISON COUNTY IOWA

CHEK

**REAL ESTATE TRANSFER - GROUNDWATER HAZARD STATEMENT  
TO BE COMPLETED BY TRANSFEROR**

**TRANSFEROR:**

Name Timothy Kadlec

Address 3036 - 133rd Court, Van Meter, Iowa 50261

Number and Street or RR

City, Town or P.O.

State

Zip

**TRANSFeree:**

Name Daniel Linnett

Address 3036 - 133rd Court, Van Meter, Iowa 50261

Number and Street or RR

City, Town or P.O.

State

Zip

Address of Property Transferred:

3036 - 133rd Court, Van Meter, Iowa 50261

Number and Street or RR

City, Town or P.O.

State

Zip

Legal Description of Property: (Attach if necessary) See 1 in Addendum

**1. Wells (check one)**

There are no known wells situated on this property.

There is a well or wells situated on this property. The type(s), location(s) and legal status are stated below or set forth on an attached separate sheet, as necessary.

**2. Solid Waste Disposal (check one)**

There is no known solid waste disposal site on this property.

There is a solid waste disposal site on this property and information related thereto is provided in Attachment #1, attached to this document.

**3. Hazardous Wastes (check one)**

There is no known hazardous waste on this property.

There is hazardous waste on this property and information related thereto is provided in Attachment #1, attached to this document.

**4. Underground Storage Tanks (check one)**

There are no known underground storage tanks on this property. (Note exclusions such as small farm and residential motor fuel tanks, most heating oil tanks, cisterns and septic tanks, in instructions.)

There is an underground storage tank on this property. The type(s), size(s) and any known substance(s) contained are listed below or on an attached separate sheet, as necessary.

**5. Private Burial Site (check one)**

- There are no known private burial sites on this property.
- There is a private burial site on this property. The location(s) of the site(s) and known identifying information of the decedent(s) is stated below or on an attached separate sheet, as necessary.

**6. Private Sewage Disposal System (check one)**

- All buildings on this property are served by a public or semi-public sewage disposal system.
- This transaction does not involve the transfer of any building which has or is required by law to have a sewage disposal system.
- There is a building served by private sewage disposal system on this property or a building without any lawful sewage disposal system. A certified inspector's report is attached which documents the condition of the private sewage disposal system and whether any modifications are required to conform to standards adopted by the Department of Natural Resources. A certified inspection report must be accompanied by this form when recording.
- There is a building served by private sewage disposal system on this property. Weather or other temporary physical conditions prevent the certified inspection of the private sewage disposal system from being conducted. The buyer has executed a binding acknowledgment with the county board of health to conduct a certified inspection of the private sewage disposal system at the earliest practicable time and to be responsible for any required modifications to the private sewage disposal system as identified by the certified inspection. A copy of the binding acknowledgment is attached to this form.
- There is a building served by private sewage disposal system on this property. The buyer has executed a binding acknowledgment with the county board of health to install a new private sewage disposal system on this property within an agreed upon time period. A copy of the binding acknowledgment is provided with this form.
- There is a building served by private sewage disposal system on this property. The building to which the sewage disposal system is connected will be demolished without being occupied. The buyer has executed a binding acknowledgment with the county board of health to demolish the building within an agreed upon time period. A copy of the binding acknowledgment is provided with this form. [Exemption #9]
- This property is exempt from the private sewage disposal inspection requirements pursuant to the following exemption [Note: for exemption #9 use prior check box]: \_\_\_\_\_
- The private sewage disposal system has been installed within the past two years pursuant to permit number \_\_\_\_\_

**Information required by statements checked above should be provided here or on separate sheets attached hereto:**

Underground storage tank is an LP Gas tank  
(1000 gallon)

---



---



---

**I HEREBY DECLARE THAT I HAVE REVIEWED THE INSTRUCTIONS FOR THIS FORM AND THAT THE INFORMATION STATED ABOVE IS TRUE AND CORRECT.**

Signature:  Telephone No.: 319-560-6544  
(Transferor or Agent)

**GROUNDWATER HAZARD STATEMENT**

**ATTACHMENT #1**

**NOTICE OF WASTE DISPOSAL SITE**

**a. Solid Waste Disposal (check one)**

- There is a solid waste disposal site on this property, but no notice has been received from the Department of Natural Resources that the site is deemed to be potentially hazardous.
- There is a solid waste disposal site on this property which has been deemed to be potentially hazardous by the Department of Natural Resources. The location(s) of the site(s) is stated below or on an attached separate sheet, as necessary.

**b.. Hazardous Wastes (check one)**

- There is hazardous waste on this property and it is being managed in accordance with Department of Natural Resources rules.
- There is hazardous waste on this property and the appropriate response or remediation actions, or the need therefore, have not yet been determined.

Further descriptive information:

---

---

---

---

---

---


---

---

---

---

**I HEREBY DECLARE THAT I HAVE REVIEWED THE INSTRUCTIONS FOR THIS FORM AND THAT THE INFORMATION STATED ABOVE IS TRUE AND CORRECT.**

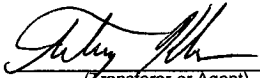Signature:  Telephone No.: 319-560-6544  
(Transferor or Agent)



# Time of Transfer Inspection Report

### Property Information

Current Owner: Lu Ann Kadlec

Buyer: Daniel & Edith Zinnett Realtor: Adam Tanssen

Mailing Address: \_\_\_\_\_

Site Address/County: 3036 133rd Ct. Van Meter, IA 50261

Legal Description As Abstract

No. of bedrooms: 4 Last occupied: currently Records available:  Y  N

Permit/ installation date: 7-6-09 Separation distances (ok/no?):  (ok)  (no?)

### Septic System Information

Septic tank(s): Size: 2000 gal Material: Concrete/Poly Condition: good

Tank pumped?  Y  N Date: 5/4/15 Licensed pumper: Forest Septic

Septic/Trash/Processing tank: Size: \_\_\_\_\_ Material: \_\_\_\_\_ Condition: \_\_\_\_\_

Tank pumped?  Y  N Date: \_\_\_\_\_ Licensed pumper: \_\_\_\_\_

Aerobic treatment unit (ATU) mfg \_\_\_\_\_ Size \_\_\_\_\_

Tank pumped?  Y  N Date: \_\_\_\_\_ Licensed pumper: \_\_\_\_\_

Maintenance contract?  Y  N Expiration date: \_\_\_\_\_ Service provider: \_\_\_\_\_

Condition: \_\_\_\_\_

Pump tanks/vaults: Type: Concrete/Poly Size: 1000 gal Condition: good

Distribution system: Distribution box \_\_\_\_\_ Outlets used \_\_\_\_\_ Condition: \_\_\_\_\_

Header pipe(s): \_\_\_\_\_ No. of lines: \_\_\_\_\_ Pressure dosed? \_\_\_\_\_

### Secondary Treatment:

Length of absorption fields: \_\_\_\_\_ Determined by: \_\_\_\_\_

Condition of fields: good / dry Determined by: Hydraulic Test and Probing

Type of trench material: pvc / rock

Size of sand filter: 150' x 15' Determined by: drawing

Vent pipes above grade?  Y  N Discharge pipe located?  Y  N

Effluent sample taken \_\_\_\_\_ Results: \_\_\_\_\_

Media Filters: Type: \_\_\_\_\_

Maintenance contract?  Y  N Expiration date: \_\_\_\_\_ Service provider: \_\_\_\_\_

Condition: \_\_\_\_\_

NPDES General Permit No. 4: Required?  Y  N Permitted?  Y  N NOI provided: \_\_\_\_\_



# Time of Transfer Inspection Report

Other components:

Alarms:  Y  N Working:  Y  N Disinfection:  Y  N Working:  Y  N

Control Box: \_\_\_\_\_ Timers: \_\_\_\_\_ Inspection Ports: \_\_\_\_\_

Other components: \_\_\_\_\_

Overall condition of the private sewage disposal system:

Report system status: good condition

Explain (attach additional pages as needed): \_\_\_\_\_

Comments: \_\_\_\_\_

Site status at conclusion of Time of Transfer inspection:

- Verify that controls are set on the appropriate mode.
- Power is on to all components.
- Revisit all components to verify lids are secure.
- Gather all tools for removal from the site.
- Verify that no sewage is on the ground surface.

Using this worksheet, write a narrative report of the inspection results and attach a site sketch.

**This report indicates the condition of the private sewage disposal system at the time of the inspection. It does not guarantee that it will continue to function satisfactorily.**

Signature of Certified Inspector: *Tyler Forest* Date: 6/23/16  
Name (print): Tyler Forest Certificate #: 10041

Address: PO Box 219, Indianola, IA 50125

Phone #: 515-202-4897

Provide a copy of this report, the narrative report and sketch to the seller/agent, buyer/agent or the person ordering the inspection, the county sanitarian/environmental health office and to:

Iowa DNR  
Private Sewage Disposal Program  
502 E 9<sup>th</sup> St  
Des Moines IA 50319

DNR Time of Transfer Report System Status

Address: 3036 133<sup>rd</sup> Ct. Date: 6-23-16  
Vanmeter Ia. 50261 Technician Tyler Forest

All waste water from house drains to septic system.  Yes  No

Remarks: \_\_\_\_\_

The tank is a  Poly  Concrete 2000 gallon tank. In good condition.  Yes  No

Remarks: \_\_\_\_\_

The distribution box is in good condition.  Yes  No  None

Remarks: \_\_\_\_\_

The laterals are in good condition.  Yes  No  None


Remarks: The secondary treatment is an  
A+ Grade mound system. There is a  
1000 gal. Pump Pit, The Pump Pit,  
Pump & all components were in good  
working condition.  
The A+ Grade probed dry &  
took water well and was in good working  
condition.

This is not a guarantee!

- This certifies that the septic system was in good working condition at the time of the inspection.
- This certifies the condition of the septic system at the time of the inspection.

Permit # 007-09  
Inspection 7/6/09  
3036 133<sup>rd</sup> Ct

North  
↑

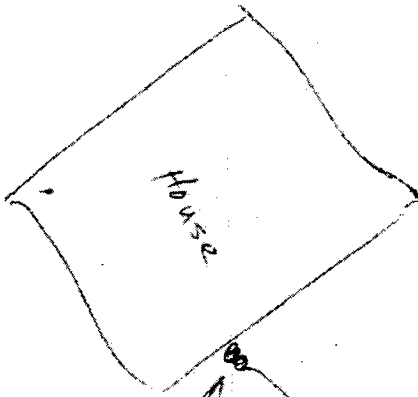

Drip line clean out

92'


clean out

37'

septic tank



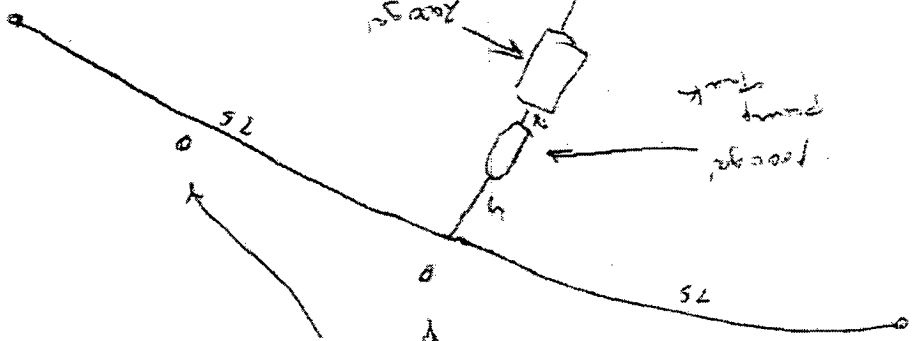

Observation holes

At Grade Manhole  
Squirt High 6ft  
Power Flo. 0.4 HP Pump  
SFI ALARM

## Addendum

1. Lot 26B of the Replat of Lots 20, 26, and 28 of Woodland Valley Estates Plat No. 2 Subdivision located in the South Half of the Northwest Quarter (S ½ NW ¼) of Section 21, Township 77 North, Range 26, West of the 5th P.M., Madison County, Iowa, together with an undivided interest in all common areas as set forth in the Declaration of Association for Woodland Valley Estates Subdivision filed in Book 2004, Page 6107 and in the Declaration of Association for Woodland Valley Estates Plat No. 2 Subdivision filed in Book 2006, Page 2763 of the Madison County Recorder's Office, and any supplements and amendments thereto