	INDEX	LEGEND	
COUNTY: M	adison		
SECTION:	TOWNSHIP:	RANGE:	
ALIQUOT P	ART:		
PARCEL DI	ESIGNATION:		
CITY: Win	erset		
SUBDIVISI	ON NAME: Danf	orth's Addition	
BLOCK: 3	LOT(S): 3		
SITE ADDR	ESS: 710 Bento	n E Street	
PROPRIETO	R: Timothy &	Nancy Baker	
REQUESTE	BY: Timothy	Baker	

Book 2016 Page 2925 Type 06 026 Pages 1 Date 10/03/2016 Time 12:00:48PM

Rec Amt \$7.00

INDX ANNO **SCAN**

LISA SMITH, COUNTY RECORDER MADISON COUNTY 10WA


CHEK

THIS SPACE RESERVED FOR REC ORDER'S OFFICE USE ONLY


PREPARED BY & RETURN TO: ABACI CONSULTING INC, 101 NE CIRCLE DR., GRIMES, IA 50111, PH.(515)986-5048

BOUNDARY RETRACEMENT **SURVEY**

Legal Description Lot 3 in Block 3 in Danforth's Additon to City of Winterset, Madison County, Iowa.

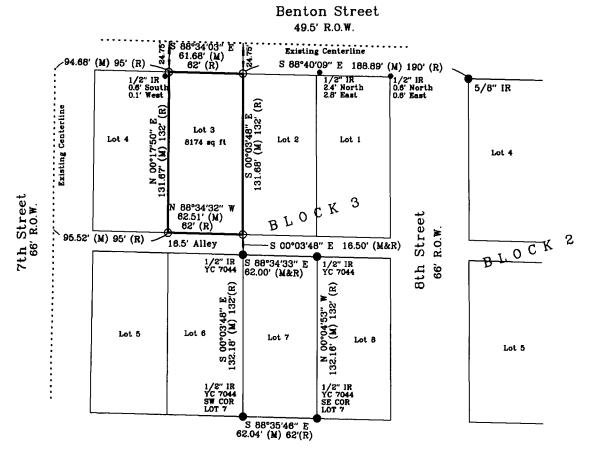

Buchanan Street 66' R.O.W.

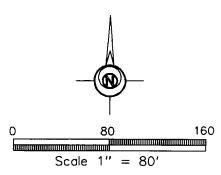

DATE OF SURVEY FIELDWORK: 9/21/16 DRAWING DATE: 9/27/16 REVISION DATE: I HEREBY CERTIFY THAT THIS SURVEYING DOCUMENT WAS PREPARED AND THE RELATED WORK WAS PERFORMED BY ME OR UNDER MY DIRECT PERSONAL SUPERVISION, AND THAT I AM A DULY LICENSED PROFESSIONAL LAND SURVEYOR UNDER THE LAWS OF THE STATE OF IOWA. VINCENT E. PIAGENTINI, IOWA LIC. NO 15982 MY LICENSE RENEWAL DATE IS DECEMBER 31, 2016. ADDITIONAL PAGES CERTIFIED (NONE UNLESS INDICATED HERE)

DRAFTER: VP PROJECT NO: 16559 SYMBOLS LEGEND: RECORDED DISTANCE
MEASURED DISTANCE
CORNER MONUMENT FOUND*
SET 1/2" IR YC 15982
UNLESS NOTED
SECTION CORNER FOUND
SECTION CORNER SET
1/2" IR YC 15982
UNLESS NOTED
POINT OF BEGINNING
POINT OF COMMENCEMENT Ŏ \triangle

POC

ALL CAPS ARE YELLOW PLASTIC UNLESS OTHERWISE INDICATED.

PROJECT NO: