



Document 2016 3933

Book 2016 Page 3933 Type 06 026 Pages 1
Date 12/20/2016 Time 11:58:21AM
Rec Amt \$7.00

INDX
ANNO
SCAN
CHEK

LISA SMITH, COUNTY RECORDER
MADISON COUNTY IOWA

INDEX LEGEND

COUNTY: Madison
PARCEL DESIGNATION:
SECTION: TOWNSHIP: RANGE:
ALIQUOT PART:
SUBDIVISION NAME: H & K Subdivision
BLOCK: LOT(S): 7
SITE ADDRESS: 345 McKinley Street
CITY: Truro
PROPRIETOR: Richard Bassett
REQUESTED BY: Richard Bassett


ABACI CONSULTING, INC.
CIVIL ENGINEERING - LAND SURVEYING
101 NE CIRCLE DR., GRIMES, IOWA 50111, PH. (515)986-5048

THIS SPACE RESERVED FOR RECORDER'S OFFICE USE ONLY

PREPARED BY & RETURN TO: ABACI CONSULTING INC, 101 NE CIRCLE DR., GRIMES, IA 50111, PH.(515)986-5048

BOUNDARY RETRACEMENT SURVEY

Turner Street

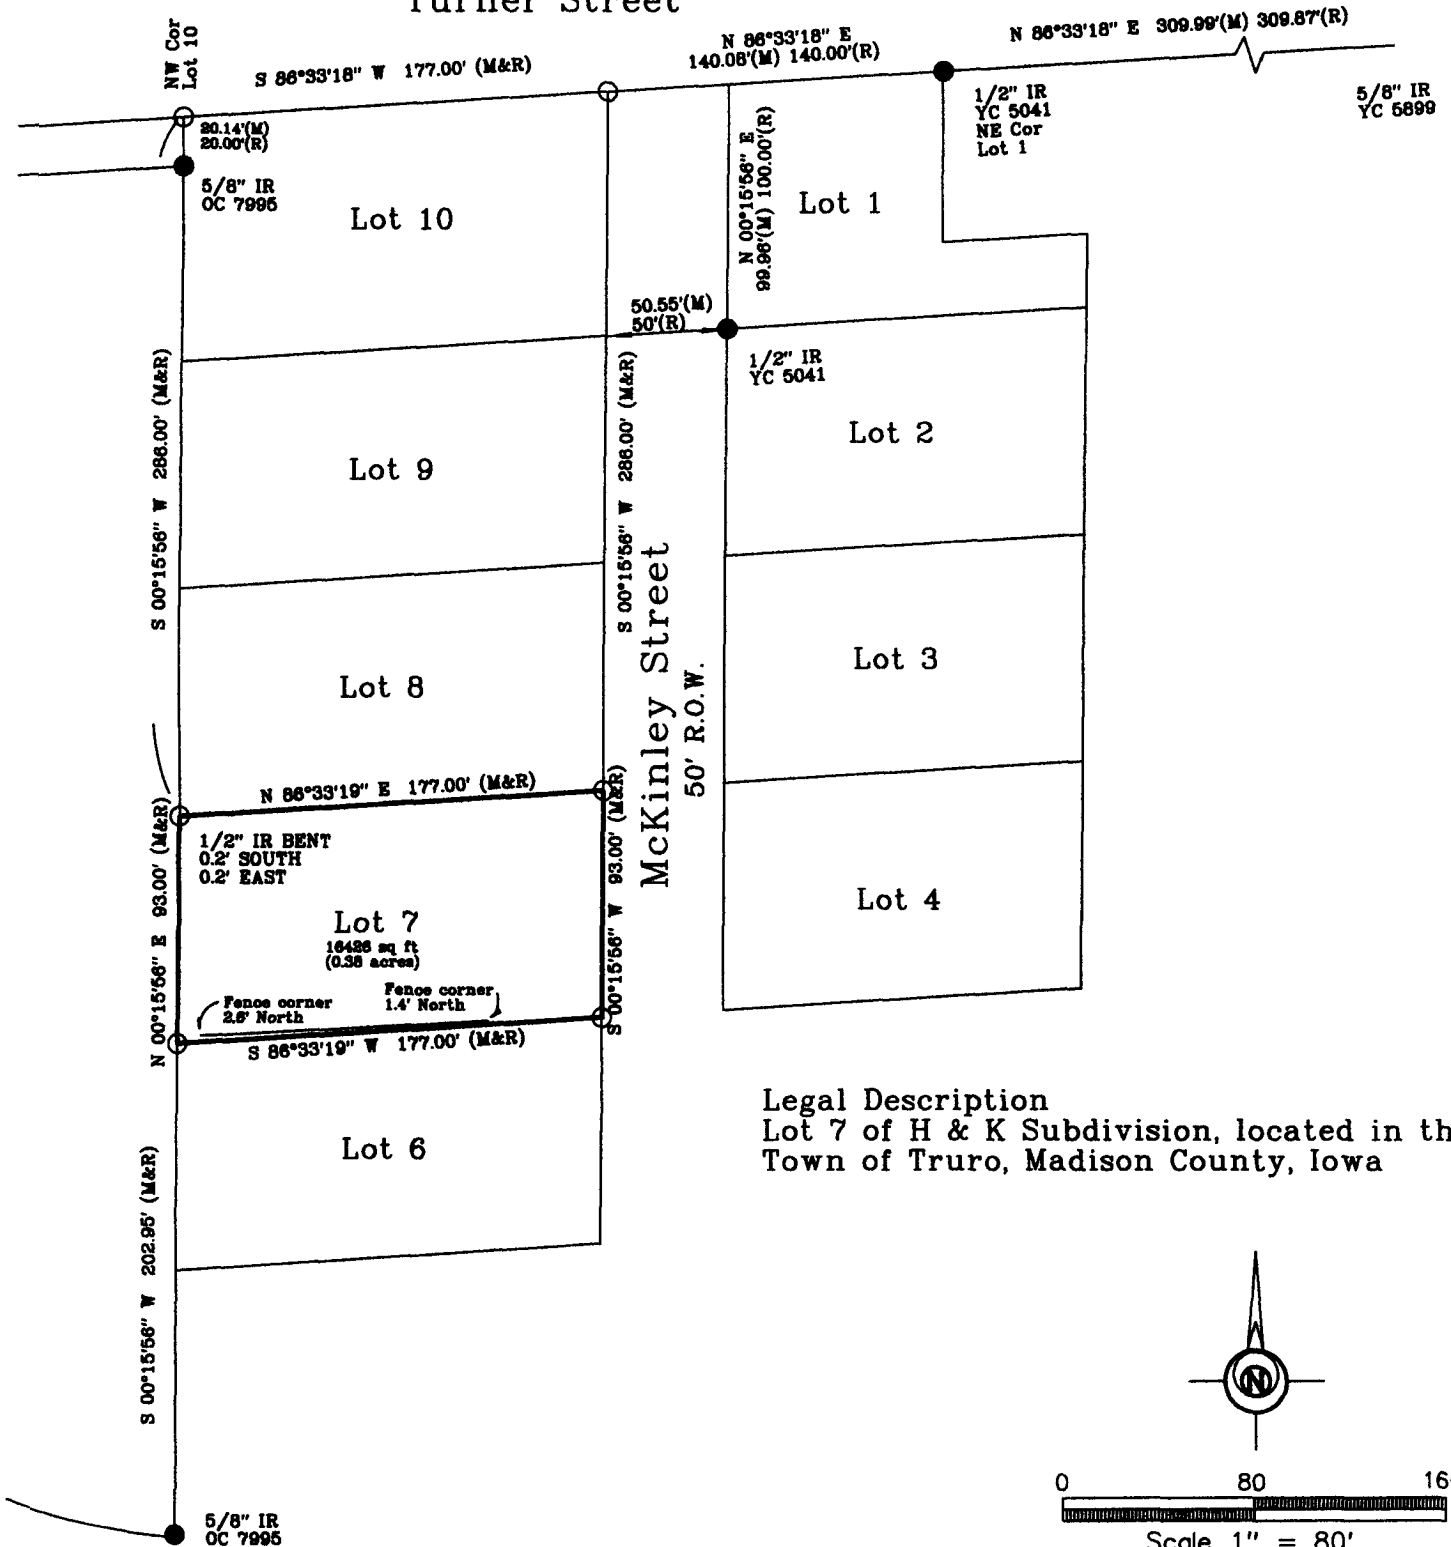

Legal Description
Lot 7 of H & K Subdivision, located in the
Town of Truro, Madison County, Iowa

DATE OF SURVEY FIELDWORK: 11/23/16 DRAWING DATE: 12/18/16 DRAFTER: VP REVISION DATE: PROJECT NO: 16667

I HEREBY CERTIFY THAT THIS SURVEYING DOCUMENT WAS PREPARED AND THE RELATED WORK WAS PERFORMED BY ME OR UNDER MY DIRECT PERSONAL SUPERVISION, AND THAT I AM A DULY LICENSED PROFESSIONAL LAND SURVEYOR UNDER THE LAWS OF THE STATE OF IOWA.

Vincent E. Piagentini 12/20/16
VINCENT E. PIAGENTINI, IOWA LIC. NO 15982 DATE

MY LICENSE RENEWAL DATE IS DECEMBER 31, 2016.

ADDITIONAL PAGES CERTIFIED (NONE UNLESS INDICATED HERE)

SYMBOLS LEGEND:

- | | | | |
|----|-----------|-----|--|
| IR | IRON ROD | R | RECORDED DISTANCE |
| IP | IRON PIPE | M | MEASURED DISTANCE |
| | | C | CALCULATED DISTANCE |
| | | ● | CORNER MONUMENT FOUND |
| | | ○ | SET 1/2" IR YC 15982 UNLESS NOTED |
| | | ▲ | SECTION CORNER FOUND |
| | | △ | SECTION CORNER SET 1/2" IR YC 15982 UNLESS NOTED |
| | | POB | POINT OF BEGINNING |
| | | POC | POINT OF COMMENCEMENT |
| | | YC | YELLOW CAP |
| | | OC | ORANGE CAP |

