



Document 2016 3930

Book 2016 Page 3930 Type 06 026 Pages 1
Date 12/20/2016 Time 11:56:46AM
Rec Amt \$7.00

INDX
ANNO
SCAN
CHEK

LISA SMITH, COUNTY RECORDER
MADISON COUNTY IOWA

INDEX LEGEND


COUNTY: Madison
PARCEL DESIGNATION:
SECTION: TOWNSHIP: RANGE:
ALIQUOT PART:
SUBDIVISION NAME: H & K Subdivision
BLOCK: LOT(S): 10
SITE ADDRESS: 375 McKinley Street
CITY: Truro
PROPRIETOR: Greg Anthony
REQUESTED BY: Greg Anthony

ABACI CONSULTING, INC.
CIVIL ENGINEERING - LAND SURVEYING
101 NE CIRCLE DR., GRIMES, IOWA 50111, PH. (515)986-5048

THIS SPACE RESERVED FOR RECORDER'S OFFICE USE ONLY

PREPARED BY & RETURN TO: ABACI CONSULTING INC, 101 NE CIRCLE DR., GRIMES, IA 50111, PH.(515)986-5048

BOUNDARY RETRACEMENT SURVEY

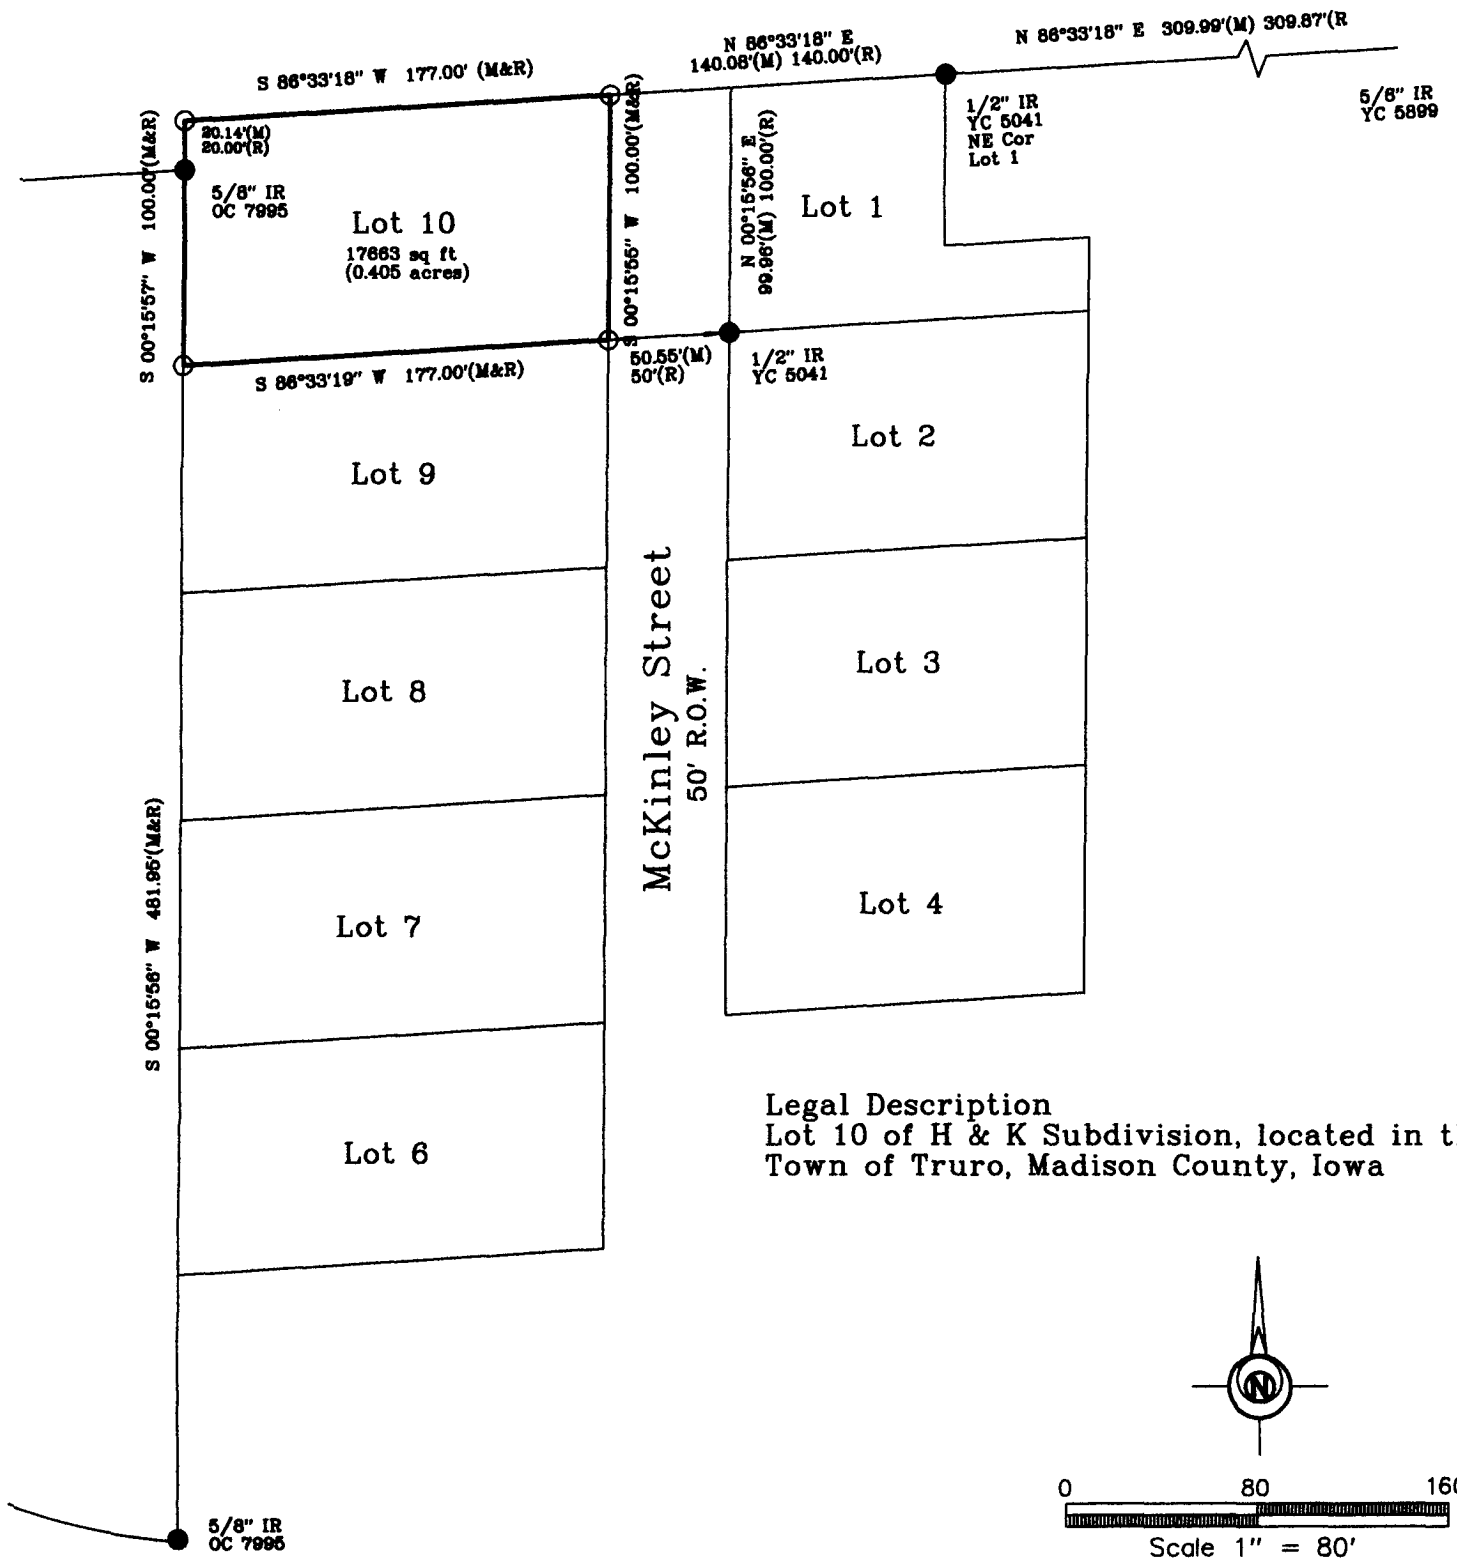

Legal Description
Lot 10 of H & K Subdivision, located in the
Town of Truro, Madison County, Iowa

DATE OF SURVEY FIELDWORK: 11/23/16 DRAWING DATE: 12/18/16 DRAFTER: VP REVISION DATE: PROJECT NO: 16677

I HEREBY CERTIFY THAT THIS SURVEYING DOCUMENT WAS PREPARED AND THE RELATED WORK WAS PERFORMED BY ME OR UNDER MY DIRECT PERSONAL SUPERVISION, AND THAT I AM A DULY LICENSED PROFESSIONAL LAND SURVEYOR UNDER THE LAWS OF THE STATE OF IOWA.

Vincent E. Piagentini 12/20/16
VINCENT E. PIAGENTINI, IOWA LIC. NO 15982 DATE

MY LICENSE RENEWAL DATE IS DECEMBER 31, 2016.

ADDITIONAL PAGES CERTIFIED (NONE UNLESS INDICATED HERE)

SYMBOLS		LEGEND:
IR	IRON ROD	R RECORDED DISTANCE
IP	IRON PIPE	M MEASURED DISTANCE
●		C CALCULATED DISTANCE
○		CORNER MONUMENT FOUND
○		SET 1/2" IR YC 15982
		UNLESS NOTED
▲		SECTION CORNER FOUND
△		SECTION CORNER SET
		1/2" IR YC 15982
		UNLESS NOTED
POB	POINT OF BEGINNING	
POC	POINT OF COMMENCEMENT	
YC	YELLOW CAP	
OC	ORANGE CAP	

