



Document 2016 4028

Book 2016 Page 4028 Type 06 043 Pages 1
Date 12/29/2016 Time 10:09:11AM
Rec Amt \$7.00

INDX
ANNO
SCAN
CHEK

LISA SMITH, COUNTY RECORDER
MADISON COUNTY IOWA

PREPARED BY & RETURN TO ERIN GRIFFIN, SNYDER & ASSOCIATES, INC. 2727 SW SNYDER ROAD, ANKENY, IOWA 50023 (515) 964-2020

UNITED STATES PUBLIC LAND SURVEY CORNER CERTIFICATE OF

Land Survey Monuments situated in Section 3, Township 77N, Range 26W, of the Fifth Principal Meridian, MADISON, County, Iowa.
Previously recorded in N/A in County Recorder's Office.
(book, page, document number, ect.)

(Show reason for preparing this certificate, the evidence and detailed procedures used in establishing the corner positions and monumentation found or placed.)


Monument Description and Remarks:

SOUTHWEST CORNER NE1/4 SW1/4 SECTION 3-77-26


NO PREVIOUS RECORD OF MONUMENTATION WAS FOUND. VISUAL SEARCH OF THE AREA AND METAL DETECTOR, FOUND NOTHING. ESTABLISHED LOCATION OF THE MONUMENT BY INTERSECTING THE 1/4 1/4 CORNERS. SET 1/2" REBAR YELLOW PLASTIC CAP #19710. THIS CERTIFICATE IS BEING FILED BECAUSE THERE IS NO CERTIFICATE FOR THE CORNER ON FILE.

Plan-View

(Show a minimum of three reference ties to durable physical objects, relevant monuments and physical conditions that will enable recovery of the corner.)

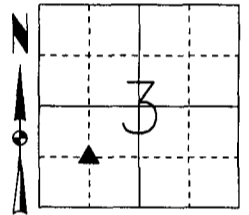

SOUTHWEST CORNER NE1/4 SW1/4
SET 1/2" REBAR
YELLOW PLASTIC CAP #19710

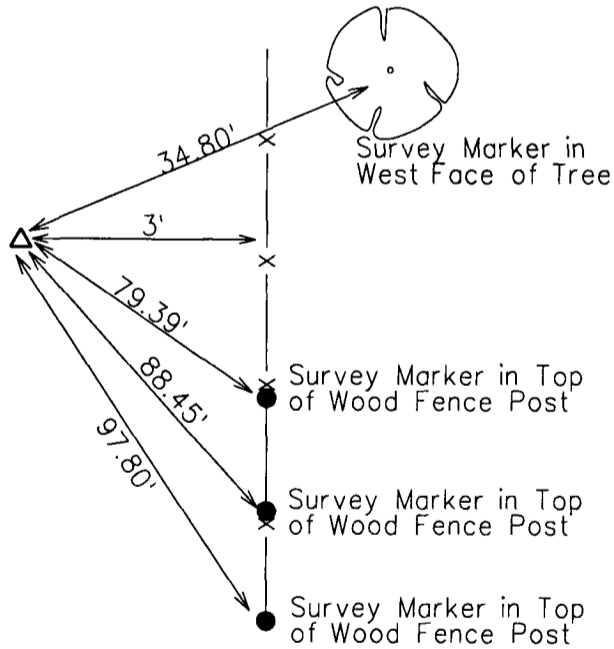


EDG
12/22/2016

NOTE: ALL DISTANCES MEASURED HORIZONTAL UNLESS OTHERWISE NOTED.

S&A #C5

I:\Survey\Section_Corners\S&A_Section_Certificate\TWP_RNG_SEC_PROJECT_MUN\77-26-3_SW_Cor_NE_SW_1160576.dgn

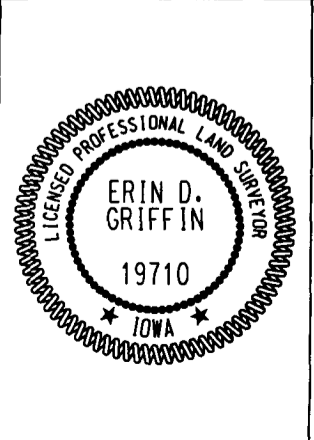

I hereby certify that this land surveying document was prepared and the related survey work was performed by me or under my direct personal supervision and that I am a duly licensed Professional Land Surveyor under the laws of the State of Iowa.

Erin D. Griffin 12/22/16
Erin D. Griffin, PLS Date

License Number 19710

My License Renewal Date is December 31, 2017

Pages or sheets covered by this seal:

SHEET 1 OF 1

List Corners to be Indexed

Corners	Section	Twp	Range
SW CORNER NE1/4 SW1/4	3	77	26

TECH: EDG/SLG

PN: 77-26-10 116.0576

DATE: 12/20/16