



Document 2017 1462
 Book 2017 Page 1462 Type 06 043 Pages 1
 Date 5/10/2017 Time 10:38:09AM
 Rec Amt \$7.00

INDX
 ANNO
 SCAN
 CHEK

LISA SMITH, COUNTY RECORDER
 MADISON COUNTY IOWA



IOWA DEPARTMENT OF TRANSPORTATION 2210 E. 7TH ATLANTIC, IOWA 50022 712-243-2009

UNITED STATES PUBLIC LAND SURVEY CORNER CERTIFICATE

Section 31 Township 76N Range 27W County MADISON



Certificate Prepared For: RE-REFERENCING SECTION CORNERS ALONG PRIMARY ROAD IA. 92.

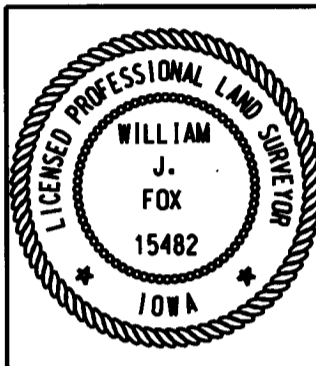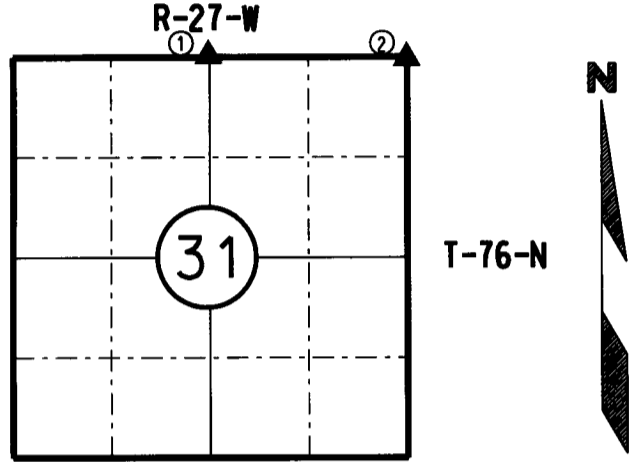

I hereby certify that this land surveying document was prepared by me and the related survey work was performed by me or under my direct supervision and that I am a duly licensed Professional Land Surveyor under the laws of the State of Iowa.



William J. Fox 4-26-17
 WILLIAM J. FOX Date

License number 15482
 Pages covered by this seal 1
 My License Renewal date is December 31, 2017

MADISON COUNTY

MONUMENT DESCRIPTION AND REMARKS:

- (1) Found Iowa D.O.T. brass plug in asphalt pavement of Iowa 92. Verified by using existing D.O.T. ties.
- (2) Found Iowa D.O.T. brass plug in asphalt pavement. Verified by using existing D.O.T. ties from construction as-builts plans and acquisition plats.

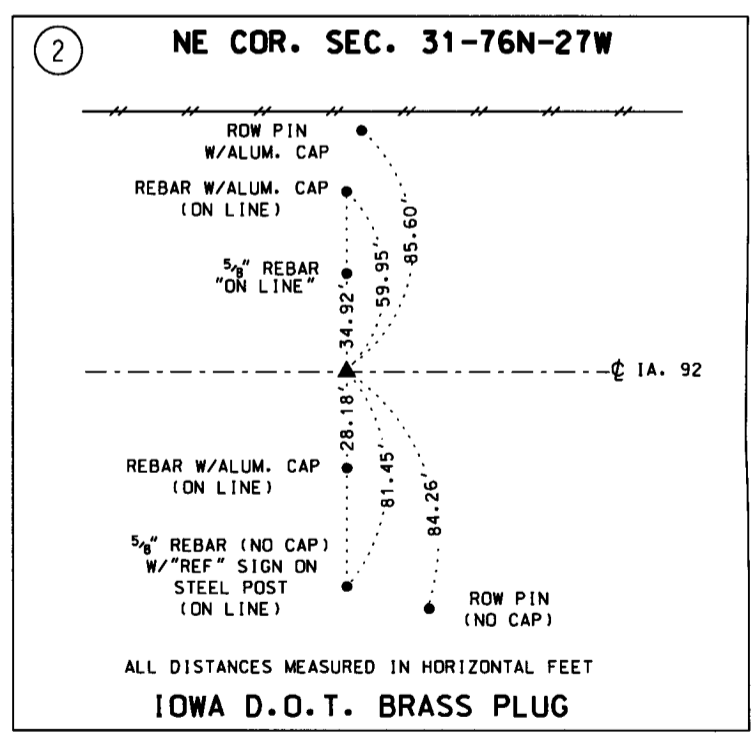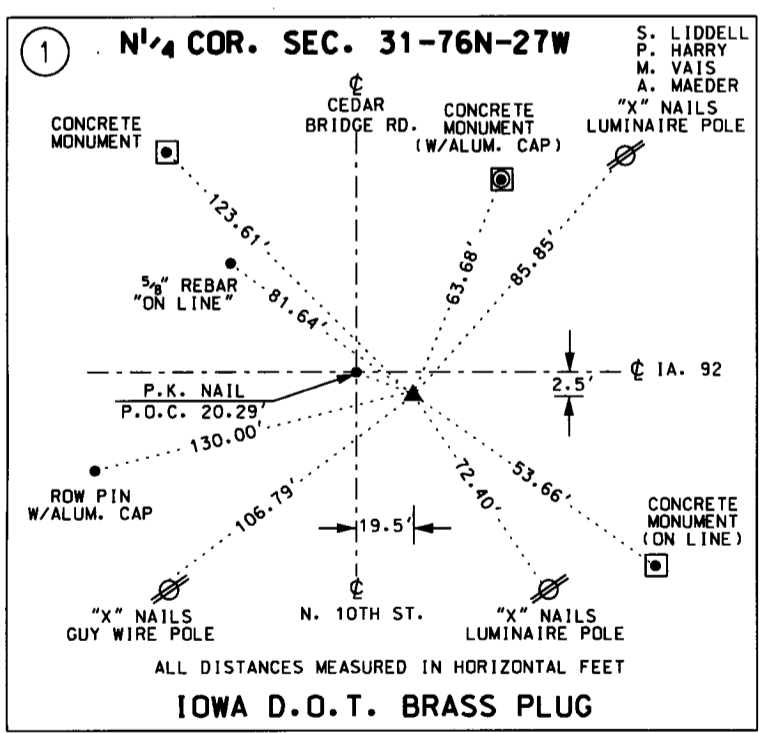

LIST CORNERS TO BE INDEXED:			
CORNERS	SECTION	TWP.	RANGE
N ¹ / ₄ COR.	31	76N	27W
NE COR.	31	76N	27W