



Document 2017 1470

Book 2017 Page 1470 Type 06 043 Pages 1
Date 5/10/2017 Time 10:38:17AM
Rec Amt \$7.00

INDX
ANNO
SCAN
CHEK

LISA SMITH, COUNTY RECORDER
MADISON COUNTY IOWA


IOWA DEPARTMENT OF TRANSPORTATION 2210 E. 7TH ATLANTIC, IOWA 50022 712-243-2009

UNITED STATES PUBLIC LAND SURVEY CORNER CERTIFICATE

Section 34 Township 76N Range 26W County MADISON



Certificate Prepared For: RE-REFERENCING SECTION CORNERS ALONG
PRIMARY ROAD IA. 92.

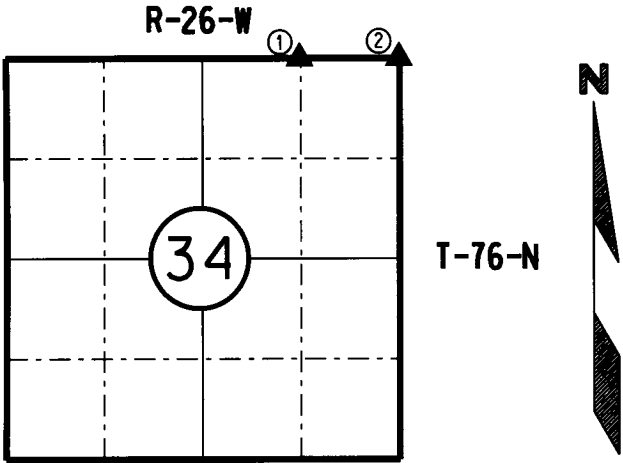

I hereby certify that this land surveying document was prepared by me and the related survey work was performed by me or under my direct supervision and that I am a duly licensed Professional Land Surveyor under the laws of the State of Iowa.



William J. Fox 4-26-17
WILLIAM J. FOX Date

License number 15482
Pages covered by this seal 1
My License Renewal date is December 31, 2017

MADISON
COUNTY

MONUMENT DESCRIPTION AND REMARKS:

- (1) Found rebar with yellow plastic cap number 6808 0.1' deep. Verified by using existing D.O.T. ties.
- (2) Found 3" diameter Iowa D.O.T. aluminum cap 0.8' deep. Verified by using existing D.O.T. ties from construction as-builts and acquisition plats.

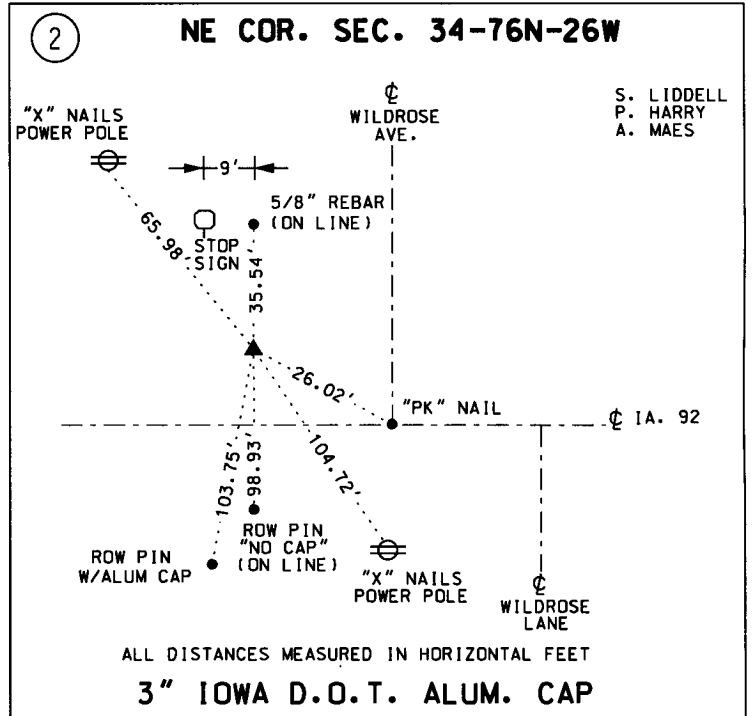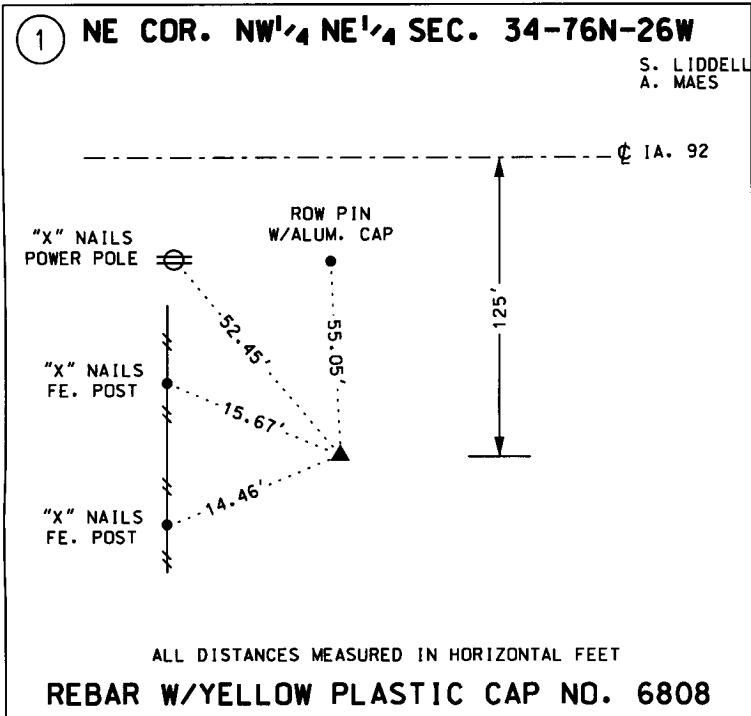

LIST CORNERS TO BE INDEXED:			
CORNERS	SECTION	TWP.	RANGE
NE COR.	34	76N	26W
NW NE			
NE COR.	34	76N	26W