



Document 2017 GW1698

Book 2017 Page 1698 Type 43 001 Pages 5
Date 6/01/2017 Time 2:46:05PM
Rec Amt \$.00

INDX
ANNO
SCAN
CHEK

LISA SMITH, COUNTY RECORDER
MADISON COUNTY IOWA

**REAL ESTATE TRANSFER - GROUNDWATER HAZARD STATEMENT
TO BE COMPLETED BY TRANSFEROR**

TRANSFEROR:

Name Alfred R. Lenz, Sr.
Address 812 North 8th Avenue, Winterset, IA 50273
Number and Street or RR City, Town or P.O. State Zip

TRANSFeree:

Name Ryan Meyer and Molly Meyer
Address 3022 SW 25th Court, Ankeny, IA 50023
Number and Street or RR City, Town or P.O. State Zip

Address of Property Transferred:
2411 Millstream Avenue, Winterset, IA 50273
Number and Street or RR City, Town or P.O. State Zip

Legal Description of Property: (Attach if necessary) Lot Three (3) of Hilltop Pines Subdivision located in the Southeast Quarter (SE 1/4) of the Southeast Quarter (SE 1/4) of Section Seven (7) and in the North Half (N 1/2) of the Northeast Quarter (NE 1/4) of Section Eighteen (18), Township Seventy-five (75) North, Range Twenty-seven (27) West of the 5th P.M., Madison County, Iowa.

1. Wells (check one)

- There are no known wells situated on this property.
- There is a well or wells situated on this property. The type(s), location(s) and legal status are stated below or set forth on an attached separate sheet, as necessary.

2. Solid Waste Disposal (check one)

- There is no known solid waste disposal site on this property.
- There is a solid waste disposal site on this property and information related thereto is provided in Attachment #1, attached to this document.

3. Hazardous Wastes (check one)

- There is no known hazardous waste on this property.
- There is hazardous waste on this property and information related thereto is provided in Attachment #1, attached to this document.

4. Underground Storage Tanks (check one)

- There are no known underground storage tanks on this property. (Note exclusions such as small farm and residential motor fuel tanks, most heating oil tanks, cisterns and septic tanks, in instructions.)
- There is an underground storage tank on this property. The type(s), size(s) and any known substance(s) contained are listed below or on an attached separate sheet, as necessary.


5. Private Burial Site (check one)

- There are no known private burial sites on this property.
- There is a private burial site on this property. The location(s) of the site(s) and known identifying information of the decedent(s) is stated below or on an attached separate sheet, as necessary.

6. Private Sewage Disposal System (check one)

- All buildings on this property are served by a public or semi-public sewage disposal system.
- This transaction does not involve the transfer of any building which has or is required by law to have a sewage disposal system.
- There is a building served by private sewage disposal system on this property or a building without any lawful sewage disposal system. A certified inspector's report is attached which documents the condition of the private sewage disposal system and whether any modifications are required to conform to standards adopted by the Department of Natural Resources. A certified inspection report must be accompanied by this form when recording.
- There is a building served by private sewage disposal system on this property. Weather or other temporary physical conditions prevent the certified inspection of the private sewage disposal system from being conducted. The buyer has executed a binding acknowledgment with the county board of health to conduct a certified inspection of the private sewage disposal system at the earliest practicable time and to be responsible for any required modifications to the private sewage disposal system as identified by the certified inspection. A copy of the binding acknowledgment is attached to this form.
- There is a building served by private sewage disposal system on this property. The buyer has executed a binding acknowledgment with the county board of health to install a new private sewage disposal system on this property within an agreed upon time period. A copy of the binding acknowledgment is provided with this form.
- There is a building served by private sewage disposal system on this property. The building to which the sewage disposal system is connected will be demolished without being occupied. The buyer has executed a binding acknowledgment with the county board of health to demolish the building within an agreed upon time period. A copy of the binding acknowledgment is provided with this form. [Exemption #9]
- This property is exempt from the private sewage disposal inspection requirements pursuant to the following exemption [Note: for exemption #9 use prior check box]: _____.
- The private sewage disposal system has been installed within the past two years pursuant to permit number _____.

Information required by statements checked above should be provided here or on separate sheets attached hereto:

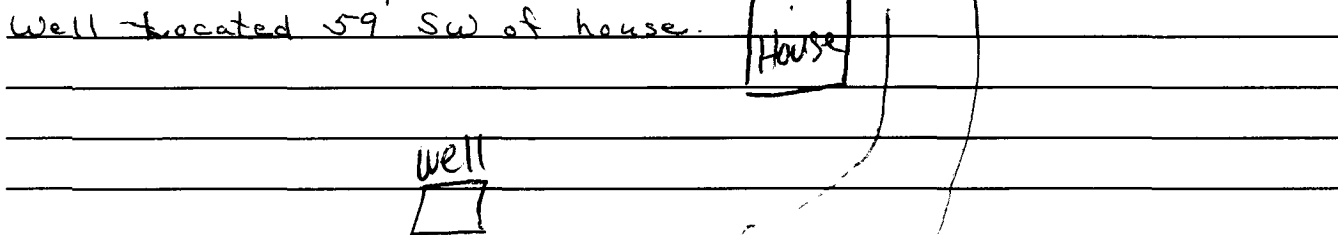

I HEREBY DECLARE THAT I HAVE REVIEWED THE INSTRUCTIONS FOR THIS FORM AND THAT THE INFORMATION STATED ABOVE IS TRUE AND CORRECT.

Signature: Robert R. Long Telephone No.: (515) 689-8222
(Transferor or Agent)



Time of Transfer Inspection Report

Property Information

Current Owner: _____

Buyer: _____

Realtor: Jennifer Storer

Mailing Address: _____

Site Address/County: 2411 Millstream Avenue Winterset IA 50273

Legal Description _____

No. of bedrooms: 3

Last occupied: November 2016

Records available: Yes

Permit/ installation date: 4-20-07

Separation distances (ok/no?): OK

Septic System Information

Septic tank(s):

Size: 1500 gal

Material: Concrete

Condition: good

Tank pumped? Y N

Date: 5-10-17

Licensed pumper: ST-237

Septic/Trash/Processing tank: Size: _____

Material: _____

Condition: _____

Tank pumped? Y N

Date: _____

Licensed pumper: _____

Aerobic treatment unit (ATU) mfg _____

Size _____

Tank pumped? Y N

Date: _____

Licensed pumper: _____

Maintenance contract? Y N

Expiration date: _____

Service provider: _____

Condition: _____

Pump tanks/vaults: Type: _____

Size: _____

Condition: _____

Distribution system: Distribution box Yes Plastic

Outlets used _____

Condition: _____

Header pipe(s): _____

No. of lines: _____

Pressure dosed? _____

Secondary Treatment:

Length of absorption fields: 4 @ 94'

Determined by: Probe, map

Condition of fields: good dry

Determined by: Probe, hydraulic test

Type of trench material: Chambers

Size of sand filter: _____

Determined by: _____

Vent pipes above grade? Y N

Discharge pipe located? Y N

Effluent sample taken _____

Results: _____

Media Filters: Type: _____

Maintenance contract? Y N

Expiration date: _____

Service provider: _____

Condition: _____

NPDES General Permit No. 4: Required? Y N

Permitted? Y N

NOI provided: _____



Time of Transfer Inspection Report

Other components:

Alarms: Y N Working: Y N Disinfection: Y N Working: Y N

Control Box: _____ Timers: _____ Inspection Ports: _____

Other components: _____

Overall condition of the private sewage disposal system: Good

Report system status: System looked good and was working properly on day of inspection.

Explain (attach additional pages as needed): Secondary treatment was dry and all components looked good on day of inspection.

Comments: System was working properly when inspected.

Site status at conclusion of Time of Transfer inspection:

- Verify that controls are set on the appropriate mode.
- Power is on to all components.
- Revisit all components to verify lids are secure.
- Gather all tools for removal from the site.
- Verify that no sewage is on the ground surface.

Using this worksheet, write a narrative report of the inspection results and attach a site sketch.

This report indicates the condition of the private sewage disposal system at the time of the inspection. It does not guarantee that it will continue to function satisfactorily.

Signature of Certified Inspector: Joe Bedwell Date: 5-10-17


Name (print): Joe Bedwell Certificate #: 109741

Address: 1600 West Euclid Avenue #2 Indianola IA, 50125

Phone #: 515-681-5885

Provide a copy of this report, the narrative report and sketch to the seller/agent, buyer/agent or the person ordering the inspection, the county sanitarian/environmental health office and to:

Iowa DNR
Private Sewage Disposal Program
502 E 9th St
Des Moines IA 50319

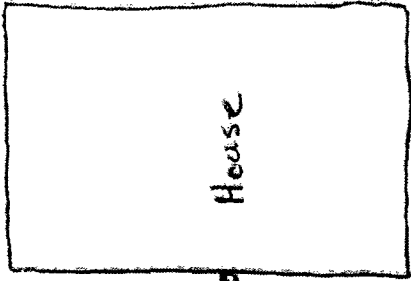

Clean out

4"

35'



4"

1500 gal
Septic Tank

4"

12'

Dist. Box

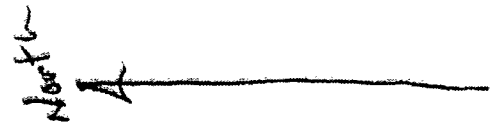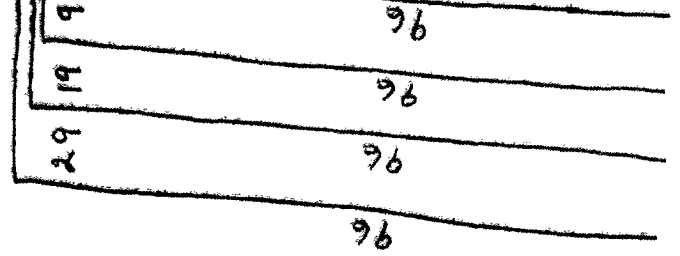

JB

5-10-17