



Document 2017 1865

Book 2017 Page 1865 Type 03 012 Pages 4
Date 6/16/2017 Time 8:00:59AM
Rec Amt \$22.00

INDX
ANNO
SCAN

LISA SMITH, COUNTY RECORDER
MADISON COUNTY IOWA

CHEK

Misc - Cemetery Ownership
Type of Document

PREPARER INFORMATION: (name, address, phone number)

Pat Lynch
3229 155th St
Cumming, Ia. 50061

TAXPAYER INFORMATION: (name and mailing address)

RETURN DOCUMENT TO: (name and mailing address)

Mary Beth Craven
7804 College Dr.
Windsor Heights, Ia 50324

GRANTOR: (name)

Lee Township Tr
Alice Kiernan
John Kiernan

GRANTEE: (name)

See page 2
Mary Beth Craven

LEGAL DESCRIPTION: (if applicable)

See page:

Document or instrument of associated documents previously recorded:
(if applicable)


Sunday, June 11, 2017 11:33 AM

Mary Beth,


Ownership of the 5 open graves in your parents 20ft by 20ft lot has been transferred to you. Before we can transfer the 5 remaining open graves in John A Thompsons 20ft by 20ft lot the cemetery board will need a signed letter of agreement from all remaining siblings, nieces and nephews of John A Thompson. The 3 remaining open graves in your grandparents (James and Elizabeth) 20ft by 20ft lot will also require a signed letter of agreement from all remaining grandchildren. When your brother Tom passed I recorded the agreement that he and his wife would both be cremated and buried in lot 9.

Pat

John Kiernan 20' x 20' lot

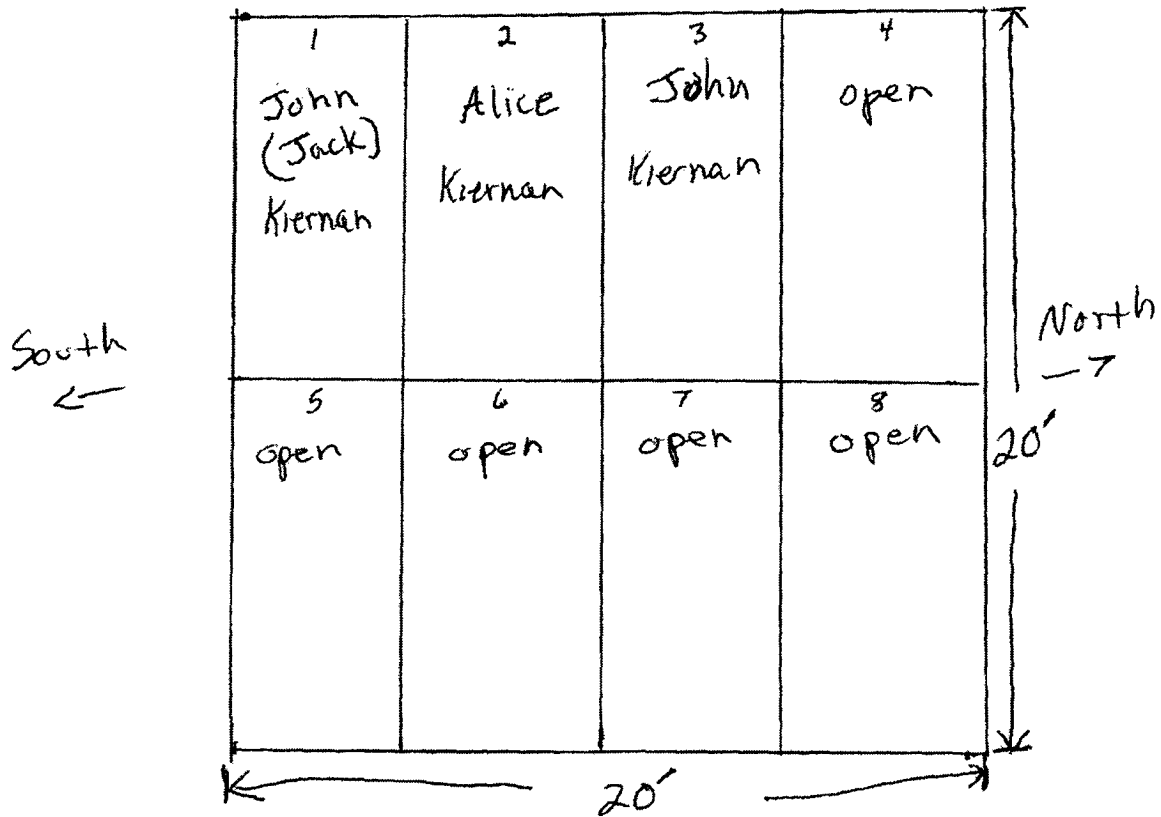

James Kiernan 20' x 20' lot

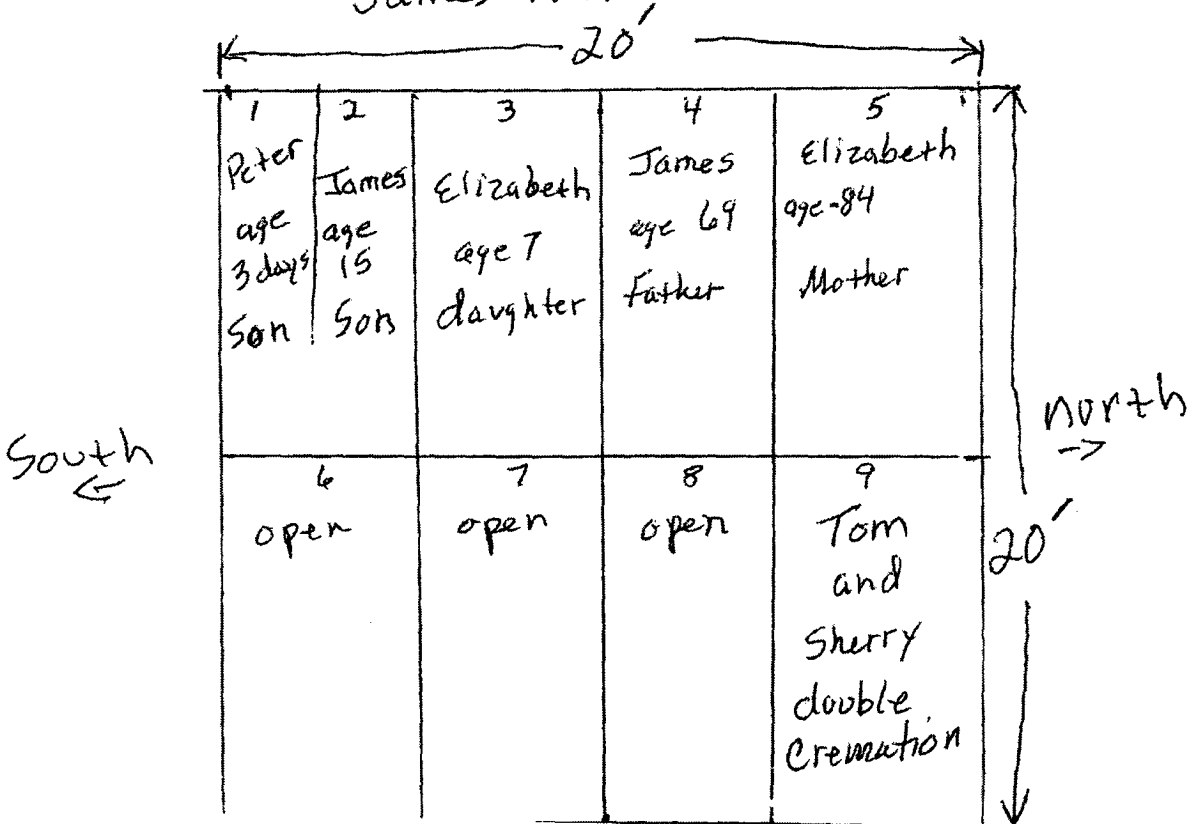

John A Thompson 20' x 20' Lot

