



Document 2017 GW2289

Book 2017 Page 2289 Type 43 001 Pages 7
Date 7/26/2017 Time 9:31:03AM
Rec Amt \$.00

INDX
ANNO
SCAN
CHEK

LISA SMITH, COUNTY RECORDER
MADISON COUNTY IOWA

REAL ESTATE TRANSFER - GROUNDWATER HAZARD STATEMENT
TO BE COMPLETED BY TRANSFEROR

TRANSFEROR:

Name Beth A. Schwertfeger

Address 1023 3rd Avenue N., Winterset, IA 50273

Number and Street or RR

City, Town or P.O.

State

Zip

TRANSFeree:

Name Dianne Susan Hassenius and Scott Del Hassenius

Address 2403 Cumming Road, Winterset, IA 50273

Number and Street or RR

City, Town or P.O.

State

Zip

Address of Property Transferred:

2208 204th Court, Winterset, IA 50273

Number and Street or RR

City, Town, or P.O.

State

Zip

Legal Description of Property: (Attach if necessary)

Lot One (1) of Woodland Hills Plat No. 1

1. Wells (check one)

There are no known wells situated on this property.

There is a well or wells situated on this property. The type(s), location(s) and legal status are stated below or set forth on an attached separate sheet, as necessary.

2. Solid Waste Disposal (check one)

There is no known solid waste disposal site on this property.

There is a solid waste disposal site on this property and information related thereto is provided in Attachment #1, attached to this document.

3. Hazardous Wastes (check one)

There is no known hazardous waste on this property.

There is hazardous waste on this property and information related thereto is provided in Attachment #1, attached to this document.

4. Underground Storage Tanks (check one)

There are no known underground storage tanks on this property. (Note exclusions such as small farm and residential motor fuel tanks, most heating oil tanks, cisterns and septic tanks, in instructions.)

There is an underground storage tank on this property. The type(s), size(s) and any known substance(s) contained are listed below or on an attached separate sheet, as necessary.

5. Private Burial Site (check one)

- There are no known private burial sites on this property.
- There is a private burial site on this property. The location(s) of the site(s) and known identifying information of the decedent(s) is stated below or on an attached separate sheet, as necessary.

6. Private Sewage Disposal System (check one)

- All buildings on this property are served by a public or semi-public sewage disposal system.
- This transaction does not involve the transfer of any building which has or is required by law to have a sewage disposal system.
- There is a building served by private sewage disposal system on this property or a building without any lawful sewage disposal system. A certified inspector's report is attached which documents the condition of the private sewage disposal system and whether any modifications are required to conform to standards adopted by the Department of Natural Resources. A certified inspection report must be accompanied by this form when recording.
- There is a building served by private sewage disposal system on this property. Weather or other temporary physical conditions prevent the certified inspection of the private sewage disposal system from being conducted. The buyer has executed a binding acknowledgment with the county board of health to conduct a certified inspection of the private sewage disposal system at the earliest practicable time and to be responsible for any required modifications to the private sewage disposal system as identified by the certified inspection. A copy of the binding acknowledgment is attached to this form.
- There is a building served by private sewage disposal system on this property. The buyer has executed a binding acknowledgment with the county board of health to install a new private sewage disposal system on this property within an agreed upon time period. A copy of the binding acknowledgment is provided with this form.
- There is a building served by private sewage disposal system on this property. The building to which the sewage disposal system is connected will be demolished without being occupied. The buyer has executed a binding acknowledgment with the county board of health to demolish the building within an agreed upon time period. A copy of the binding acknowledgment is provided with this form. [Exemption #9]
- This property is exempt from the private sewage disposal inspection requirements pursuant to the following exemption [Note: for exemption #9 use prior check box]: _____.
- The private sewage disposal system has been installed within the past two years pursuant to permit number _____.

Information required by statements checked above should be provided here or on separate sheets attached hereto:

I HEREBY DECLARE THAT I HAVE REVIEWED THE INSTRUCTIONS FOR THIS FORM AND THAT THE INFORMATION STATED ABOVE IS TRUE AND CORRECT.

Signature: Beth A. Schwertfeger Telephone No.: (515) 468-0285
(Transferor or Agent)

GROUNDWATER HAZARD STATEMENT

ATTACHMENT #1

NOTICE OF WASTE DISPOSAL SITE

a. Solid Waste Disposal (check one)

- There is a solid waste disposal site on this property, but no notice has been received from the Department of Natural Resources that the site is deemed to be potentially hazardous.
- There is a solid waste disposal site on this property which has been deemed to be potentially hazardous by the Department of Natural Resources. The location(s) of the site(s) is stated below or on an attached separate sheet, as necessary.

b.. Hazardous Wastes (check one)

- There is hazardous waste on this property and it is being managed in accordance with Department of Natural Resources rules.
- There is hazardous waste on this property and the appropriate response or remediation actions, or the need therefore, have not yet been determined.

Further descriptive information:

I HEREBY DECLARE THAT I HAVE REVIEWED THE INSTRUCTIONS FOR THIS FORM AND THAT THE INFORMATION STATED ABOVE IS TRUE AND CORRECT.

Signature: Beth A. Schweitzer Telephone No.: (515) 468-0225
(Transferor or Agent)



Buyer

Time of Transfer Inspection Report (DNR Form 542-0191)

Property information

Current owner Beth Schwertfeger
Buyer _____ Realtor Remax
Mailing address _____ (amy sucht)

Site Address/County 2208-204th ct. Winterset, Ia. 50273
Legal Description _____ (Madison Co.)

No. of bedrooms 4 Last occupied? 7 1/2 mo. ago Records available yes
Permit 038-04 Installation date 6/17/04 Separation distances ok/ no? OK

Septic system information

Septic tank(s): size 2000 gal. material concrete condition good
Tank pumped? yes date 6/15/17 licensed pumper Major Jentis
Septic/trash/processing tank: size _____ material _____ condition _____
Tank pumped? _____ date _____ licensed pumper _____
Acrobic treatment unit (ATU) mfg: _____ size _____
Tank pumped? _____ date _____ licensed pumper _____
Maintenance contract? _____ expiration date _____ service provider _____
Condition _____

Pump tanks/vaults: type to 2. box size 500 gal condition good

Distribution system: distribution box Plastic outlets used 4 condition good
Header pipe(s) 3 # of lines 4 Pressure dosed? _____

Secondary treatment:
length of absorption fields 4 at 100' determined by next Probing
condition of fields good determined by walking Probing
type of trench material 36" Chamber

Size of sand filter _____ determined by _____
Vent pipes above grade? _____ discharge pipe located? _____
Effluent sample taken? _____ Results _____

Media filters: type _____
Maintenance contract? _____ expiration date _____ service provider _____
Condition _____

NPDES General Permit No. 4: required? _____ permitted? _____ NOI provided _____



Time of Transfer Inspection Report

Other components:

Alarms X Working? X disinfection ABO working? —

Control box — Timers — inspection ports OK

Other components —

Overall condition of the private sewage disposal system

Report system status The septic system at 2208-2044 ct.

Explain (attach additional pages as needed): Winterset, Ia 50273 -
It is in good operating cond.

Comments: The septic tank opened & pumped on 6/15/17 tank is (2) count intake & outflow baffles are in place. there are no cracks in the tank & effl. filter was cleaned & tank at correct level before pumping. The pump to lateral below was run water to pump & pump to lateral of worked good.

The lateral box was uncovered & opened - all laterals took water water was added like heavy use - w/ hose & from pump - all gray water goes to system

Site status at conclusion of Time of Transfer inspection:

- OK • Verify that controls are set on the appropriate mode.
- OK • Power is on to all components.
- Done • Revisit all components to verify lids are secure.
- Done • Gather all tools for removal from the site.
- Done • Verify that no sewage is on the ground surface. None on - 6/15/17

Using this worksheet, write a narrative report of the inspection results and attach a site sketch.

This report indicates the condition of the private sewage disposal system at the time of the inspection. It does not guarantee that it will continue to function satisfactorily.

Signature of Certified inspector: John W. Mayer

Name (print): JOHN MAYER

Address: SEPTIC TANK PUMPING

Phone # 515-462-2624

1509 St. Hwy. 92

Winterset, IA 50273-8000

Date: 6/15/2017


Certificate #: 8979

Provide a copy of this report, the narrative report and sketch to the seller/agent, buyer/agent, the county sanitarian/environmental health office, county Recorder in the county the inspection was conducted and to:

Iowa DNR Onsite Wastewater Program
502 E. 9th St.
Des Moines, IA 50319

Schwertfeger 6/17/04
2208 ~~204~~ ddt:
Winterset, Ia

Permit # 038-04

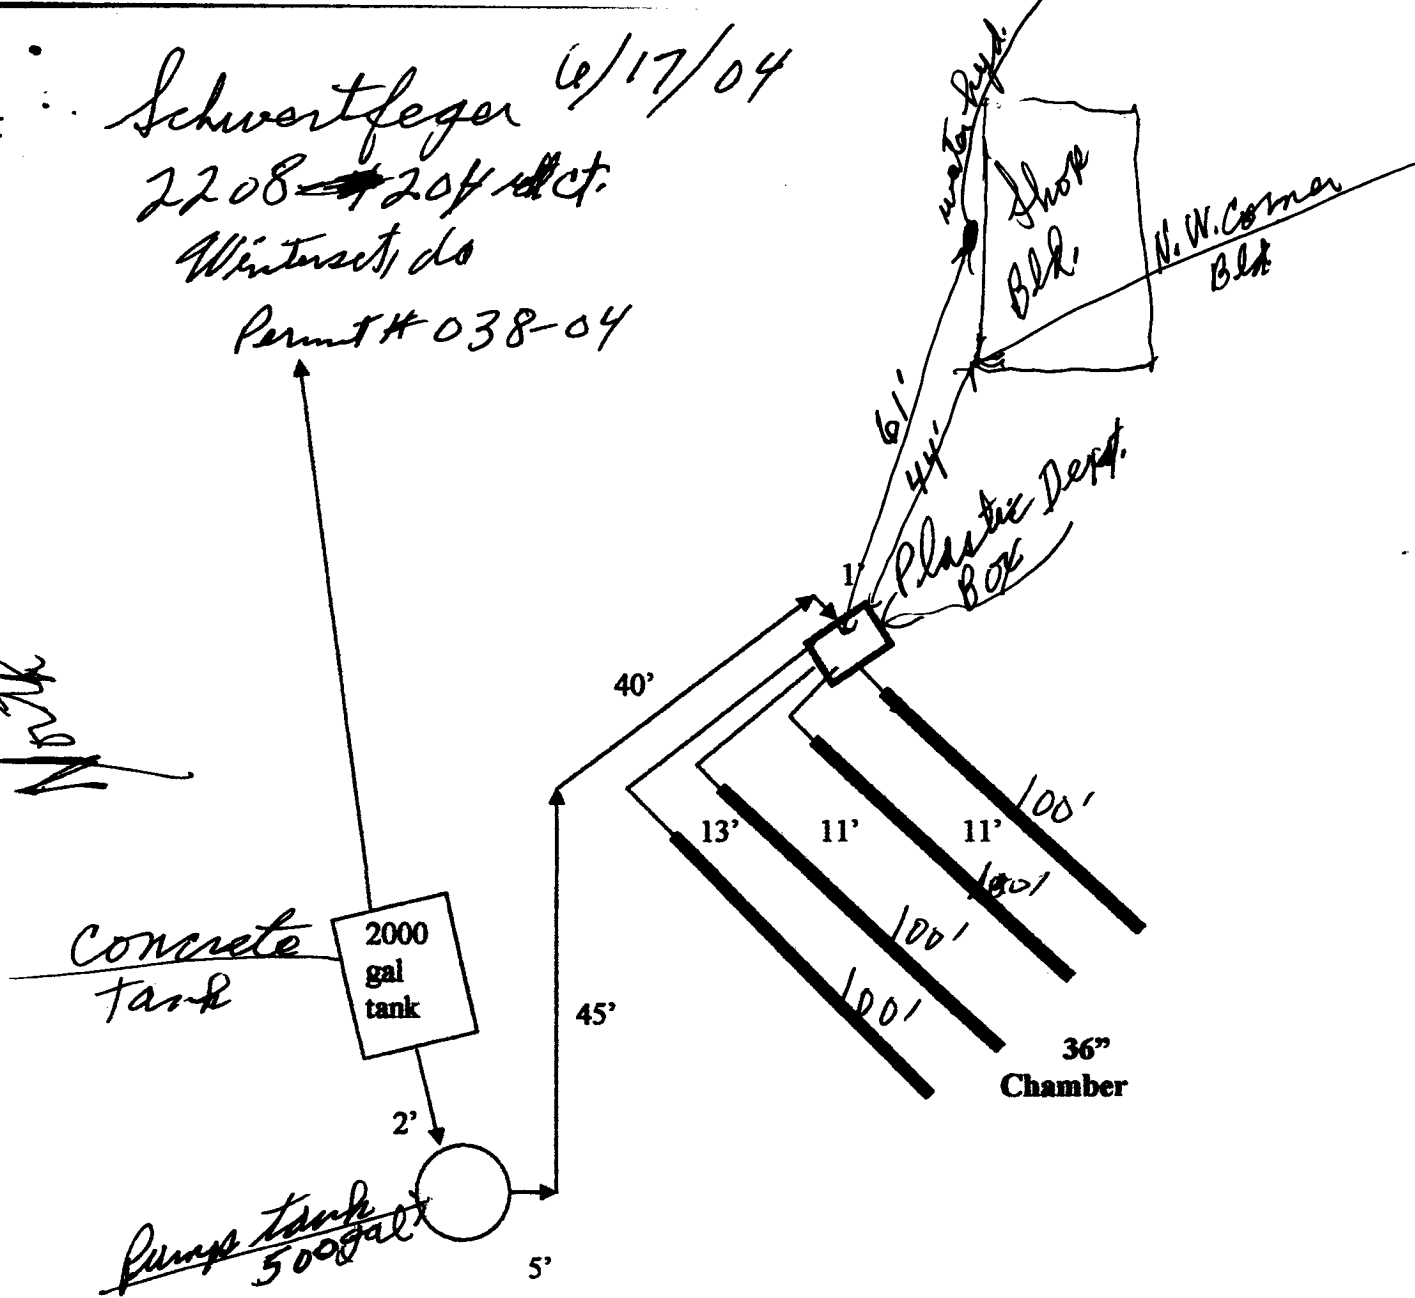

Used perc test from Vance & Hochstetler dated 6-24-04 500' 5 @ 100. Used 36" Chamber and reduced 25%


JOHN MAYER SEPTIC TANK PUMPING
1509 ST. HWY. 92 WINTERSET, IA 50273-8411

6/17/04

Jerry Schwantfeger

Permit # 038-04

North
↑

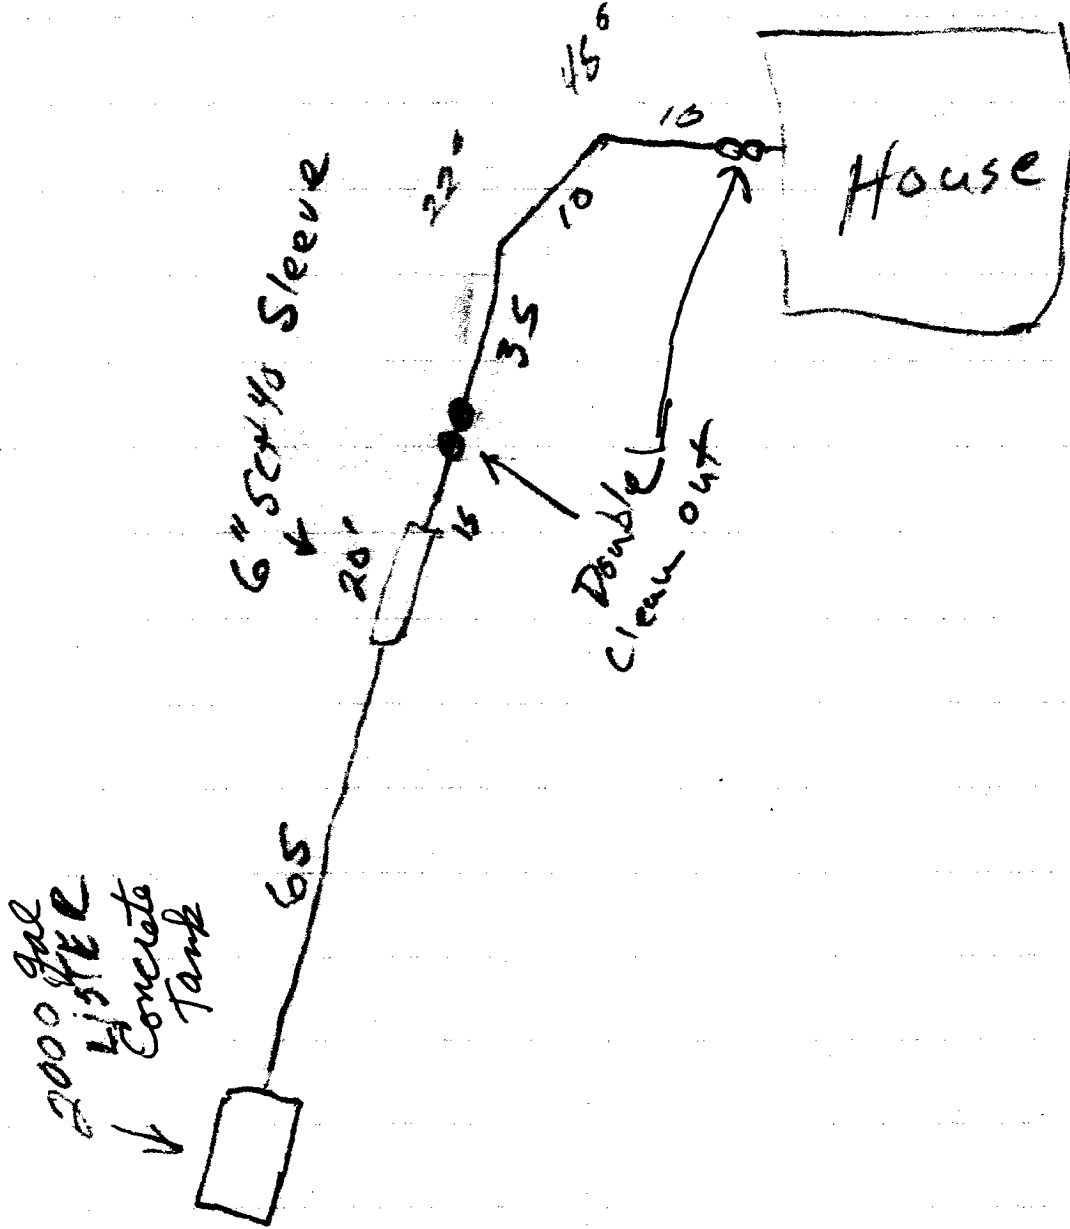

JOHN MAYER SEPTIC TANK PUMPING
1509 ST. HWY. 92 WINTERSET, IA 50273-8411