Form 53: IOWA STATE HIGHWAY COMMISSION No. 4-260

ACCESS PLAT County Madison

Project No. P-764


SPECIAL PUBLIC ROAD CONNECTION (Access Rights Acquired) Attach to Form 536 | CHECK | PRIVATE PROPERTY ENTRANCE (Access Rights NOT Acquired) EXHIBIT "A" Attach to Form 559

Location Description: Primary Road No. 92, Sec. 30, T. 76N, R. 26W


more specifically described as follows: Approx 1237 Ft N of W. West Limits of Town of Patterson

SKETCH MAP (Show intersection, entrance and property line details and dimensions)

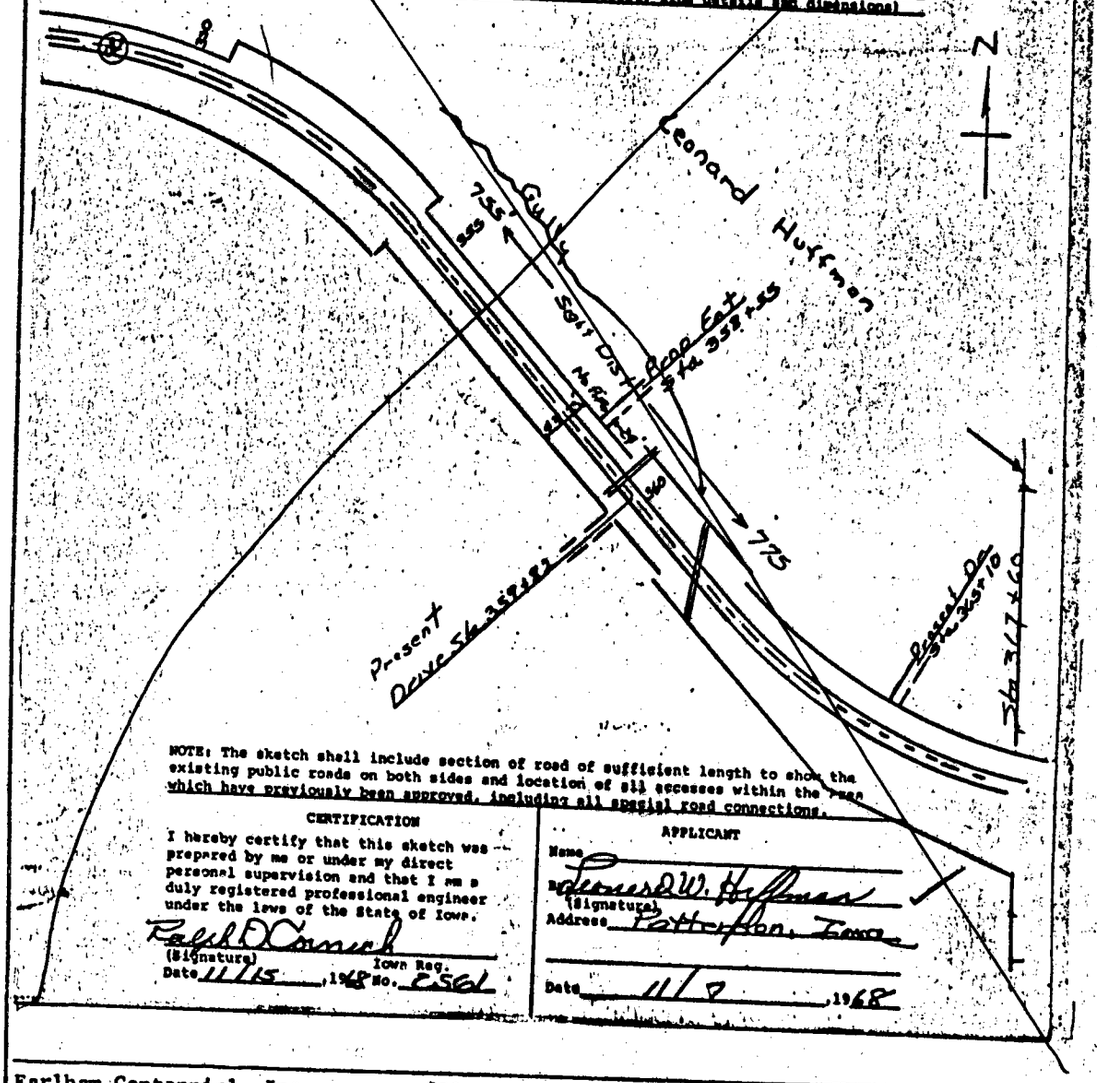

NOTE: The sketch shall include section of road of sufficient length to show the existing public roads on both sides and location of all accesses within the area which have previously been approved, including all special road connections.

CERTIFICATION

I hereby certify that this sketch was prepared by me or under my direct personal supervision and that I am a duly registered professional engineer under the laws of the State of Iowa.

Ralph D Conrad
(Signature)
Iowa Reg. No. 5561

Date 11/15, 1968

APPLICANT

Name Leonard W. Huffman
(Signature)

Address Patterson, Iowa

Date 11/8, 1968

Earlham Centennial, Inc. #23
To
The Public

Fee $2.50 PAID

Filed for record the 8 day of January A.D. 1969 at 9:59 o'clock A. M.

Mary E. Welty, Recorder

ARTICLES OF INCORPORATION OF EARLHAM CENTENNIAL, INC.

To the Secretary of State
of the State of Iowa:

Received 1968 DEC 10 AM 8:34
Secretary of State IOWA

We, the undersigned, acting as incorporators of a corporation under the Iowa Nonprofit Corporation Act under Chapter 388 of the Laws of the Sixty-First General Assembly (1965) adopt the following Articles of Incorporation for such corporation:

I. The name of the corporation is Earlham Centennial Inc.

II. The period of its duration is perpetual.

III. The purpose or purposes for which the corporation is organized are to celebrate the centennial of Earlham, Iowa.

IV. The address of its initial registered office in the state of Iowa is 1025 Center

Street, in the City of Earlham, County of Madison, and the name of its initial registered agent at such address is Charles W. Fry.

V. The number of directors constituting the initial board of directors of the corporation is five (5), and the name and address of the persons who are to serve as the initial directors are:

Charles W. Fry	Earlham, Iowa
Leslie R. Goeldner	Earlham, Iowa
Barbara Marquardt	Earlham, Iowa
Robert J. Kress	Earlham, Iowa
H. Claude Peer	Earlham, Iowa

VI. The date on which the corporate existence shall begin is on the date on which the Secretary of State issues the certificate of Incorporation.

VII. The name and address of each incorporator is:

Charles W. Fry	Earlham, Iowa
Leslie R. Goeldner	Earlham, Iowa
Barbara Marquardt	Earlham, Iowa
Robert J. Kress	Earlham, Iowa
H. Claude Peer	Earlham, Iowa

Dated November 15, 1968.

Charles W. Fry	Robert J. Kress
(Charles W. Fry)	(Robert J. Kress)
Leslie R. Goeldner	H. Claude Peer
(Leslie R Goeldner)	(H. Claude Peer)
Barbara Marquardt	
(Barbara Marquardt)	

STATE OF IOWA COUNTY OF MADISON) SS

On this 15 day of November, A.D. 1968, before me, the undersigned, a notary public in and for said County in said State, personally appeared; Charles W. Fry, Leslie R. Goeldner, Barbara Marquardt, Robert J. Kress, and H. Claude Peer to me known to be the persons named in and who executed the foregoing articles of incorporation, and acknowledged that they executed the same as their voluntary act and deed.

(NOTARIAL SEAL)

Marian A. Mark
(Marian A. Mark) Notary Public
in and for said county.

OFFICE OF THE SECRETARY OF STATE DES MOINES, IOWA
This instrument recorded in Book B-E, Page 57, December 10, 1968 Expires Perpetual, Cert. No. 43489, Receipt No - - - Filed by H. Claude Peer, Atty, Earlham, Iowa Filing Fee 10.00 Recording Fee 1.00 Melvin D. Synhorst Secretary of State.

COMPARED

The Truro Saddle Club Asso. #24
To
The Public

Fee $3.50 VEL

Filed for record the 9 day of January A.D. 1969 at 9:17 o'clock A. M.

Mary E. Welty, Recorder

ARTICLES OF INCORPORATION OF THE TRURO SADDLE CLUB ASSOCIATION

Received 1968 Dec 16 AM 8:46
Secretary of State Iowa

KNOW ALL MEN BY THESE PRESENTS THAT:

We, the undersigned being actual persons of the ages of Twenty-one years or more and being citizens of the State of Iowa, for the purpose of forming a corporation not for pecuniary profit, do hereby adopt the following Articles of Incorporation.

ARTICLE I

The name of the corporation shall be "The Truro Saddle Club Association."

ARTICLE II

This corporation is formed under the provisions of the Iowa non-profit corporation Act, Chapter 388 Laws of the Sixty-first General Assembly.

ARTICLE III

The location of its principal office is the residence of Robert Fitch, Rural Route #1, Truro, Iowa.

ARTICLE IV

The property and business of the corporation shall be managed and controlled by a