



Document 2018 281

Book 2018 Page 281 Type 06 043 Pages 1
Date 1/25/2018 Time 11:05:51AM
Rec Amt \$7.00

INDX
ANNO
SCAN
CHEK

LISA SMITH, COUNTY RECORDER
MADISON COUNTY IOWA

Prepared By: J. Brian Morrissey, Morrissey Surveying & Consulting, LLC, 1405 Hwy. G28, Otley, Ia. 50214, 515-480-2531

UNITED STATES PUBLIC LAND SURVEY CORNER CERTIFICATE OF

Land Survey Monuments situated in Section 29, Township 74N, Range 27W, of the Fifth Principal Meridian, Madison County, Iowa.
Previously recorded in N/A in the County Recorder's Office.
(book, page, document number, etc.)


(Show reason for preparing this certificate, the evidence and detailed procedures used in establishing the corner positions and monumentation found or placed.)

Monument Description and Remarks: Set 5/8" x 18" orange plastic capped rebar, #7995, at the intersection of a line from found W 1/4 Cor. and found NW Cor., NE 1/4 of the SE 1/4 and centerline of Norwood Ln., Class B road to the south. Centerline used due to Road Record Bk. B, P. 35.

This Corner was used for a Plat of Survey in the NW 1/4 of the SW 1/4 of Sec. 29, recorded in Bk. 2016, P. 3346.

PLAN VIEW

(Show a minimum of three reference ties to durable physical objects, relevant monuments and physical conditions that will enable recovery of the corner.)

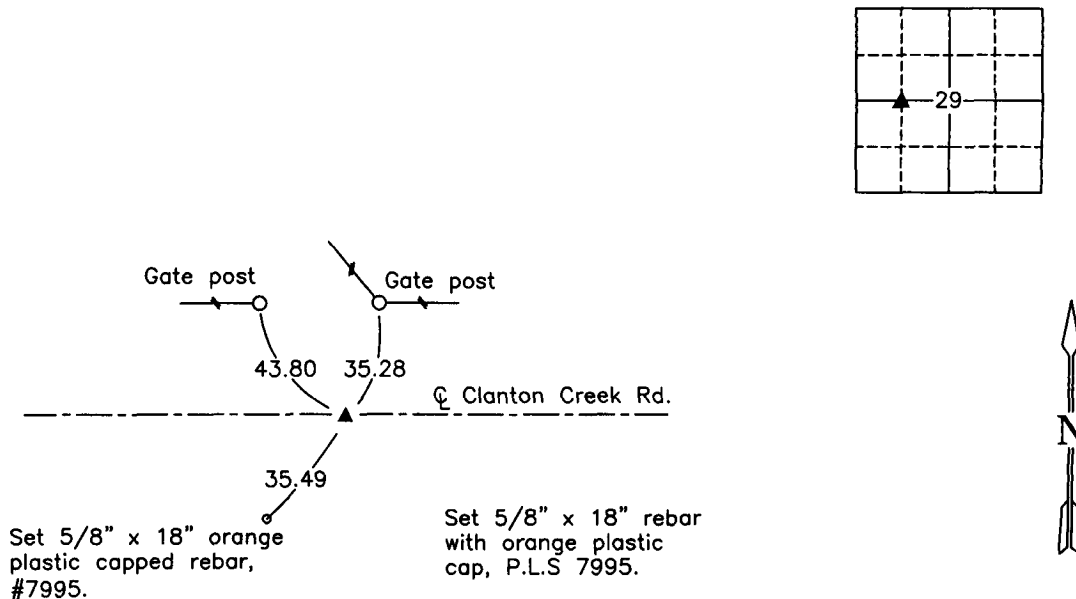

NE Corner, NW 1/4 of the SW 1/4, Section 29

Date of Survey: 10/25/16

NOTE: ALL TIES TO BRASS DISK OR YELLOW/ORANGE SURVEY MARKER UNLESS NOTED.



I hereby certify that this land surveying document was prepared and the related survey work was performed by me or under my direct personal supervision and that I am a duly Licensed Land Surveyor under the laws of the state of Iowa.

Signature: J. Brian Morrissey Date: 1/22/18
J. Brian Morrissey

License number 7995.

My license renewal date is December 31, 2019

883-16-1/2