INDEX LECEND

COUNTY: Madison
PARCEL DESIGNATION:
SECTION: 31 TOWNSHIP: 77 N RANGE: 27 W
ALIQUOT PART: NE1/4
SUBDIVISION NAME:
BLOCK: LOT(S):
SITE ADDRESS: 2299 152nd Street
CITY: Winterset

PROPRIETOR: David and Nancy Forrest

REQUESTED BY: Nancy Forrest SURVEYOR NAME: Vincent E. Piagentini

ABACI CONSULTING, INC. CIVIL ENGINEERING - LAND SURVEYING 101 NE CIRCLE DR., GRIMES, IOWA 50111, PH. (515)986-5048

Book 2018 Page 454 Type 06 026 Pages 1 Date 2/12/2018 Time 10:27:43AM Rec Amt \$7.00

Document 2018 454

INDX 🗸 **ANNO SCAN**

LISA SMITH, COUNTY RECORDER MADISON COUNTY IOWA

CHEK


THIS SPACE RESERVED FOR RECORDER'S OFFICE USE ONLY

PREPARED BY & RETURN TO: ABACI CONSULTING INC, 101 NE CIRCLE DR., GRIMES, IA 50111, PH.(515)986-5048

BOUNDARY RETRACEMENT SURVEY

Legal Description

The East Half (E1/2) of the Northeast Quarter (NE1/4), Section 31, Township 77 North, Range 27 West, of the 5th P.M., Madison County, Iowa, containing 79.63 acres, including 1.00 acre of road right of way, more or less.

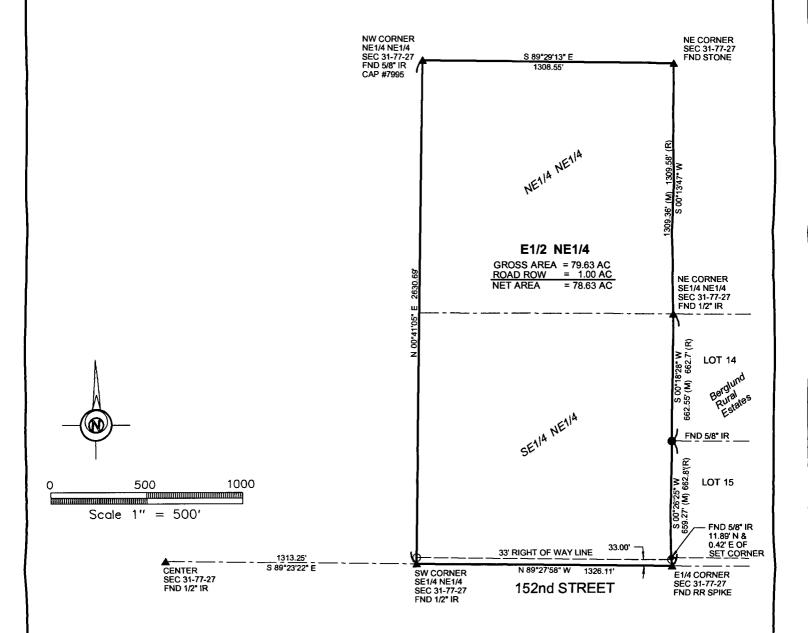

DATE OF SURVEY FIELDWORK: 1/25/2018 DRAWING DATE: 2/1/2018 DRAFTER: CTA PROJECT NO: 18010


I HEREBY CERTIFY THAT THIS SURVEYING DOCUMENT WAS PREPARED AND THE RELATED WORK WAS PERFORMED BY ME OR UNDER MY DIRECT PERSONAL SUPERVISION, AND THAT I AM A DULY LICENSED PROFESSIONAL LAND SURVEYOR UNDER THE LAWS OF THE STATE OF IOWA.

L

2/5/18 algh VINCENT E. PIAGENTINI, IOWA LIC. NO 15982 DATE

MY LICENSE RENEWAL DATE IS DECEMBER 31, 2018.

ADDITIONAL PAGES CERTIFIED (NONE UNLESS INDICATED HERE).

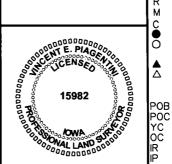

REVISION DATE:

SYMBOLS LEGEND:

RECORDED DISTANCE
MEASURED DISTANCE
CALCULATED DISTANCE
CORNER MONUMENT FOUND
SET 1/2" IR YC 15982
UNLESS NOTED UNLESS NOTED
SECTION CORNER FOUND
SECTION CORNER SET
1/2" IR YC 15982
UNLESS NOTED
POINT OF BEGINNING
POINT OF COMMENCEMENT YELLOW CAP ORANGE CAP IRON ROD IRON PIPE