

INDEX LEGEND



Document 2018 1294

Book 2018 Page 1294 Type 06 026 Pages 1
 Date 4/26/2018 Time 10:41:36AM
 Rec Amt \$7.00

INDX
 ANNO
 SCAN
 CHEK

LISA SMITH, COUNTY RECORDER
 MADISON COUNTY IOWA

Location:: Fieldstone Add. to Winterset

Requestor: Stan Mason

Proprietor: Fieldstone H.A.

Project: 18020 Date of Survey: 4/19/2018

Surveyor Co: Boldman Surveying Consultants



✓ Prepared by/Return to: Craig S. Boldman

521 West Green Street, Winterset, Ia 50273

Phone/fax: 515-462-9242

BOUNDARY RETRACEMENT SURVEY

The Replat of Lots 4 thru 15 in Fieldstone Addition to the City of Winterset, Madison County, Iowa,

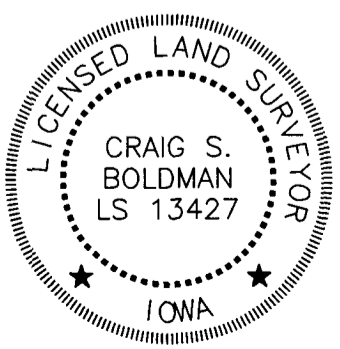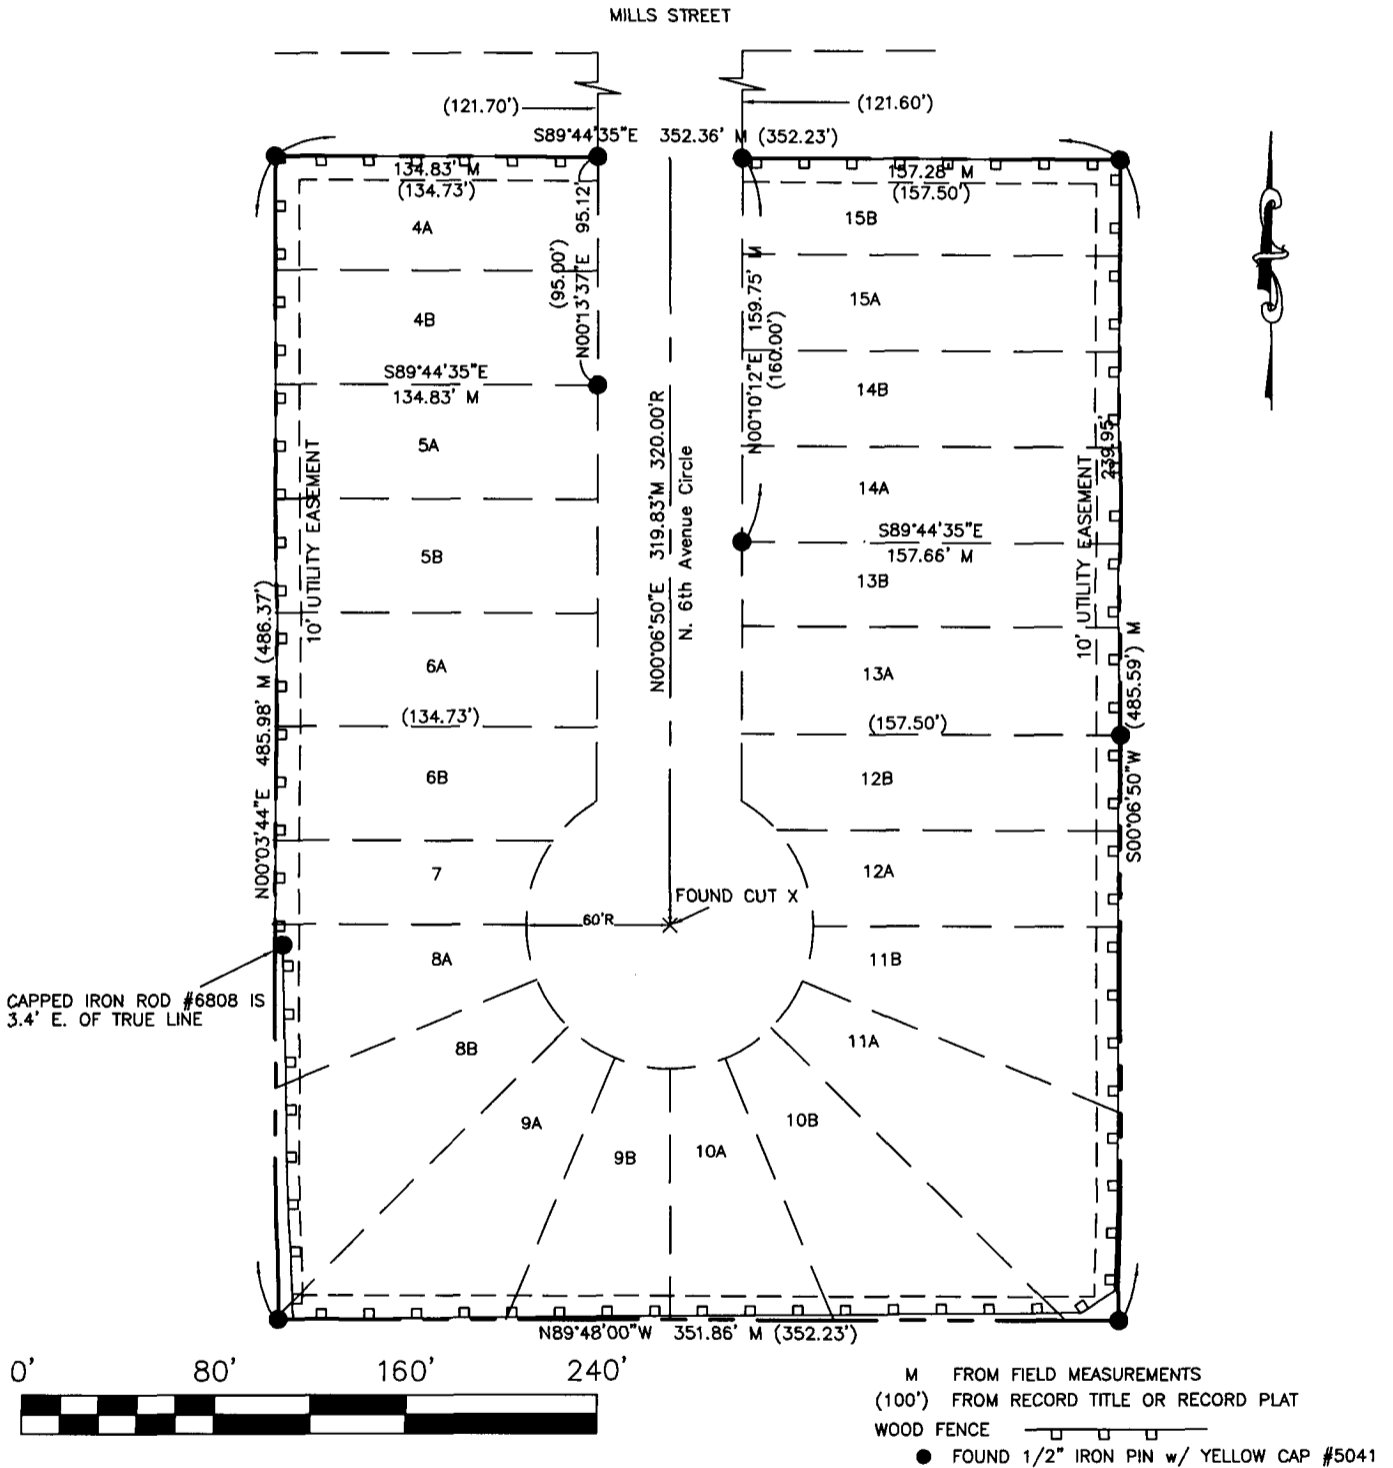

I hereby certify that this land surveying document was prepared and the related survey work was performed by me or under my direct supervision and that I am a duly licensed Land Surveyor under the laws of the State of Iowa

Signature *Craig S. Boldman* Date 4/23/18

Name Craig S. Boldman P.L.S No. 13427

Renewal date is December 31, 2018

Pages or sheets covered by this seal 1