



Document 2018 2109

Book 2018 Page 2109 Type 06 043 Pages 1  
Date 7/05/2018 Time 1:19:13PM  
Rec Amt \$7.00

INDX  
ANNO  
SCAN  
CHEK

LISA SMITH, COUNTY RECORDER  
MADISON COUNTY IOWA


PREPARED BY - JOSEPH P. RUESCHENBERG - SUNDQUIST ENGINEERING - 120 S. MAIN, DENISON, IOWA 51442 - PHONE (712) 263-8118

# UNITED STATES PUBLIC LAND SURVEY CORNER CERTIFICATE OF



LAND SURVEY MONUMENT SITUATED IN SECTION 4, T 76 N, R 26 W OF  
THE 5TH P.M.,                      MADISON                      COUNTY, IOWA.  
PREVIOUSLY RECORDED IN BOOK           , PAGE           , OTHER                     

## MONUMENT DESCRIPTION AND REMARKS

SW CORNER - FOUND IRON PIN W/YELLOW CAP #6808 FLUSH.  
  
CENTER - FOUND 5/8" DIA. IRON PIN 0.4' DEEP.

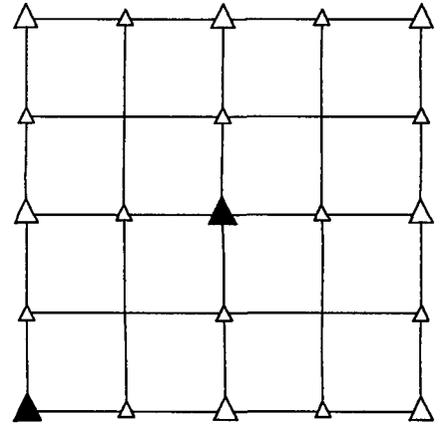

## PLAN VIEW SHOWING RELATIVE LOCATION OF MONUMENT AND REFERENCE POINTS.

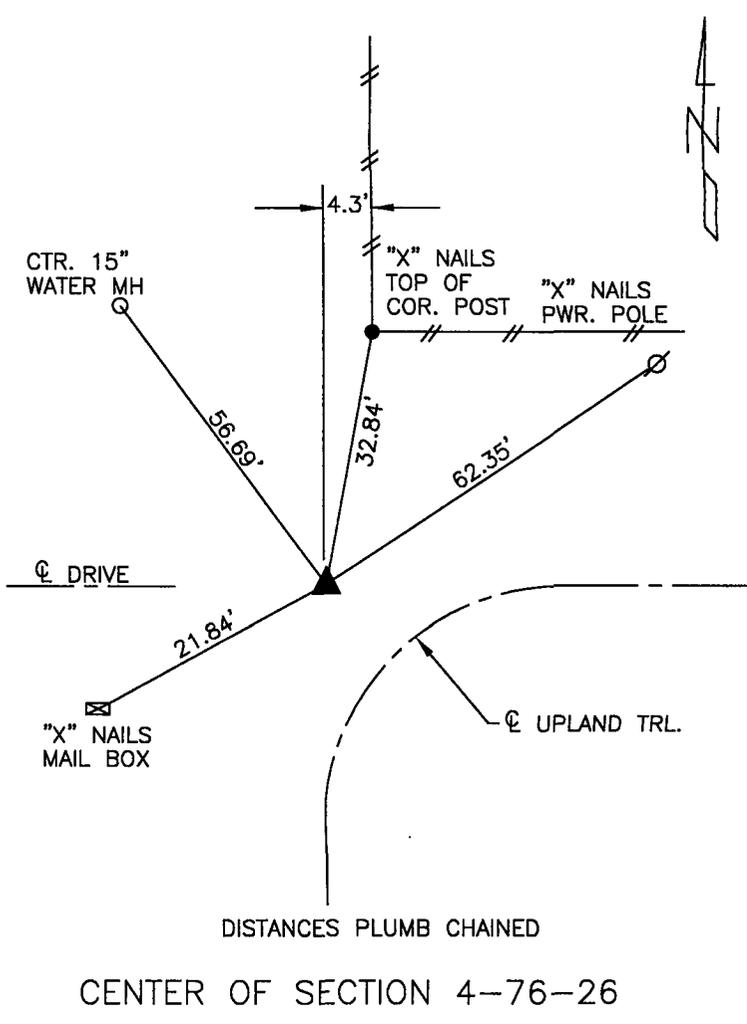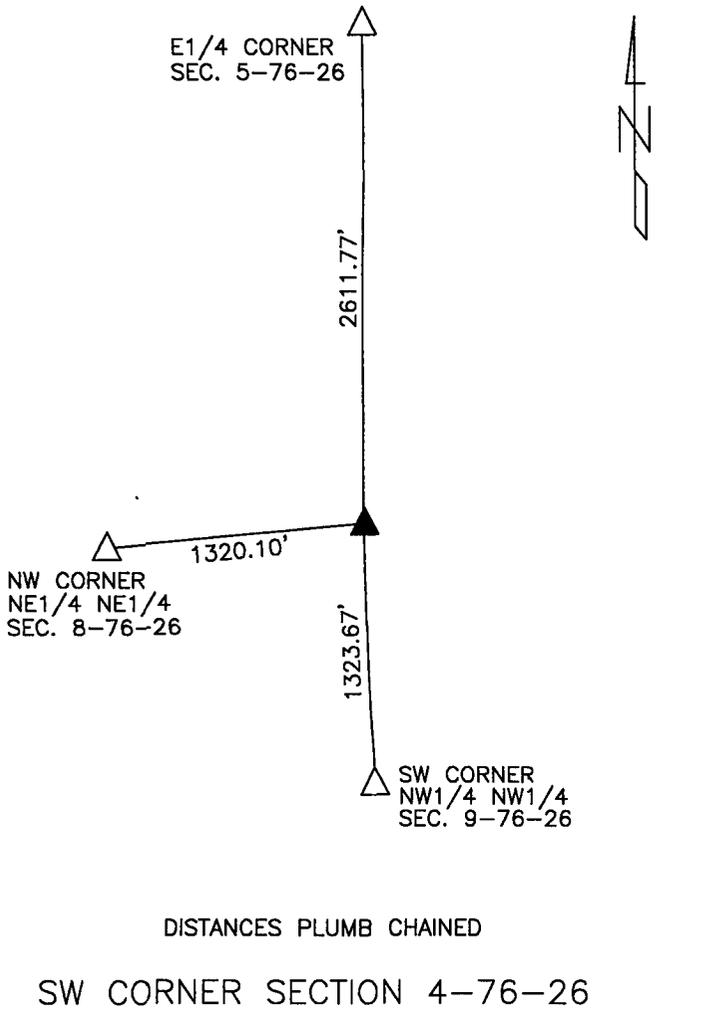

I HEREBY CERTIFY THAT THIS LAND SURVEYING DOCUMENT WAS PREPARED AND THE RELATED SURVEY WORK WAS PERFORMED BY ME OR UNDER MY DIRECT PERSONAL SUPERVISION AND THAT I AM A DULY LICENSED LAND SURVEYOR UNDER THE LAWS OF THE STATE OF IOWA.

*Joseph P. Rueschenberg* 7-3-2018  
JOSEPH P. RUESCHENBERG DATE

IA LICENSE NO. 14709

EXP. DATE DECEMBER 31, 2018



SE PROJECT NO. 21418  
DRAWN BY: LLL