



Document 2018 GW3512

Book 2018 Page 3512 Type 43 001 Pages 6

Date 10/31/2018 Time 10:32:05AM

Rec Amt \$.00

INDX
ANNO
SCAN

LISA SMITH, COUNTY RECORDER
MADISON COUNTY IOWA

CHEK

**REAL ESTATE TRANSFER - GROUNDWATER HAZARD STATEMENT
TO BE COMPLETED BY TRANSFEROR**

TRANSFEROR:

Name Karen Henke, Trustee of the Sybil E. Witt Trust

Address 1569 105th Street, Earlham, IA 50072

Number and Street or RR

City, Town or P.O.

State

Zip

TRANSFeree:

Name Rachelle D. Keller

Address 305 NW Elm Avenue, Earlham, IA 50072

Number and Street or RR

City, Town or P.O.

State

Zip

Address of Property Transferred:

1569 105th Street, Earlham, IA 50072

Number and Street or RR

City, Town or P.O.

State

Zip

Legal Description of Property: (Attach if necessary) Lot Three (3) of Godby Subdivision located in the Southwest Quarter (1/4) of the Northeast Quarter (1/4) of Section One (1), Township Seventy-seven (77) North, Range Twenty-nine (29) West of the 5th P.M., Madison County, Iowa.

1. Wells (check one)

There are no known wells situated on this property.

There is a well or wells situated on this property. The type(s), location(s) and legal status are stated below or set forth on an attached separate sheet, as necessary.

2. Solid Waste Disposal (check one)

There is no known solid waste disposal site on this property.

There is a solid waste disposal site on this property and information related thereto is provided in Attachment #1, attached to this document.

3. Hazardous Wastes (check one)

There is no known hazardous waste on this property.

There is hazardous waste on this property and information related thereto is provided in Attachment #1, attached to this document.

4. Underground Storage Tanks (check one)

There are no known underground storage tanks on this property. (Note exclusions such as small farm and residential motor fuel tanks, most heating oil tanks, cisterns and septic tanks, in instructions.)

There is an underground storage tank on this property. The type(s), size(s) and any known substance(s) contained are listed below or on an attached separate sheet, as necessary.

5. Private Burial Site (check one)


- There are no known private burial sites on this property.
- There is a private burial site on this property. The location(s) of the site(s) and known identifying information of the decedent(s) is stated below or on an attached separate sheet, as necessary.

6. Private Sewage Disposal System (check one)

- All buildings on this property are served by a public or semi-public sewage disposal system.
- This transaction does not involve the transfer of any building which has or is required by law to have a sewage disposal system.
- There is a building served by private sewage disposal system on this property or a building without any lawful sewage disposal system. A certified inspector's report is attached which documents the condition of the private sewage disposal system and whether any modifications are required to conform to standards adopted by the Department of Natural Resources. A certified inspection report must be accompanied by this form when recording.
- There is a building served by private sewage disposal system on this property. Weather or other temporary physical conditions prevent the certified inspection of the private sewage disposal system from being conducted. The buyer has executed a binding acknowledgment with the county board of health to conduct a certified inspection of the private sewage disposal system at the earliest practicable time and to be responsible for any required modifications to the private sewage disposal system as identified by the certified inspection. A copy of the binding acknowledgment is attached to this form.
- There is a building served by private sewage disposal system on this property. The buyer has executed a binding acknowledgment with the county board of health to install a new private sewage disposal system on this property within an agreed upon time period. A copy of the binding acknowledgment is provided with this form.
- There is a building served by private sewage disposal system on this property. The building to which the sewage disposal system is connected will be demolished without being occupied. The buyer has executed a binding acknowledgment with the county board of health to demolish the building within an agreed upon time period. A copy of the binding acknowledgment is provided with this form. [Exemption #9]
- This property is exempt from the private sewage disposal inspection requirements pursuant to the following exemption [Note: for exemption #9 use prior check box]: _____.
- The private sewage disposal system has been installed within the past two years pursuant to permit number _____.

Information required by statements checked above should be provided here or on separate sheets attached hereto:

I HEREBY DECLARE THAT I HAVE REVIEWED THE INSTRUCTIONS FOR THIS FORM AND THAT THE INFORMATION STATED ABOVE IS TRUE AND CORRECT.

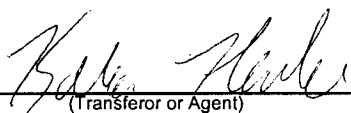Signature:  Telephone No.: (410) 253-6330
(Transferor or Agent)



Time of Transfer Inspection Report (DNR Form 542-0191)

Property information

Current owner Sybil Witt Trust

Buyer Realtor

Mailing address 1569 105th St, Earlham

Site Address/County 1569 105th St, Earlham Madison Co

Legal Description

No. of bedrooms 2 Last occupied? no Records available NO

Permit/installation date Separation distances ok/ no?

Septic system information

Septic tank(s): size 1250 GAL material plastic condition working condition

Tank pumped? YES date 9/18/18 licensed pumper Forest Septic

Septic/trash/processing tank: size material condition

Tank pumped? date licensed pumper

Aerobic treatment unit (ATU) mfr size

Tank pumped? date licensed pumper

Maintenance contract? expiration date service provider

Condition

Pump tanks/vaults: type size condition

Distribution system: distribution box Plastic outlets used 3 condition working condition

Header pipe(s) # of lines Pressure dosed?

Secondary treatment:

length of absorption fields 3x100ft=300ft determined by Probe

condition of fields Working condition determined by hydraulic load test/probe

type of trench material Rock and pipe

Size of sand filter determined by

Vent pipes above grade? discharge pipe located?

Effluent sample taken? Results

Media filters: type

Maintenance contract? expiration date service provider

Condition

NPDES General Permit No. 4: required? permitted? NOI provided



Time of Transfer Inspection Report

Other components:

Alarms _____ Working? _____ disinfection _____ working? _____

Control box _____ Timers _____ inspection ports _____

Other components _____

Overall condition of the private sewage disposal system

Report system status _____

Explain (attach additional pages as needed): All waste water goes from house to septic. 1250 gal plastic tank with risers and baffles in working condition. Plastic distribution box in working condition. Hydraulic load tested the 3x100ft=300ft rock and pipe laterals with 300 gal water. All laterals took water and probed dry and clean.

Site status at conclusion of Time of Transfer inspection:

- Verify that controls are set on the appropriate mode.
- Power is on to all components.
- Revisit all components to verify lids are secure.
- Gather all tools for removal from the site.
- Verify that no sewage is on the ground surface.

Using this worksheet, write a narrative report of the inspection results and attach a site sketch.

This report indicates the condition of the private sewage disposal system at the time of the inspection. It does not guarantee that it will continue to function satisfactorily.

Signature of Certified inspector: Rick Rogers Date: 9/25/18
 Name (print): Rick Rogers Certificate #: 9597
 Address: 401 NE 52nd Ave, Des Moines, IA 50313
 Phone #: 515-745-8352



Provide a copy of this report, the narrative report and sketch to the seller/agent, buyer/agent or the person ordering the inspection, the county sanitarian/environmental health office, and to;

Iowa DNR
Private Sewage Disposal Program
502 E. 9th St.
Des Moines, IA 50319



- 1) 1250 gal plastic tank
- 2) Plastic distribution box
- 3) 3x100ft=300ft rock and pipe laterals.

Well location
1509 105th St Earlham

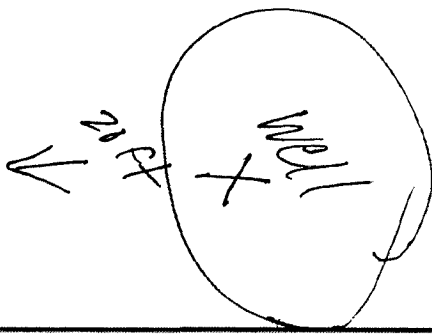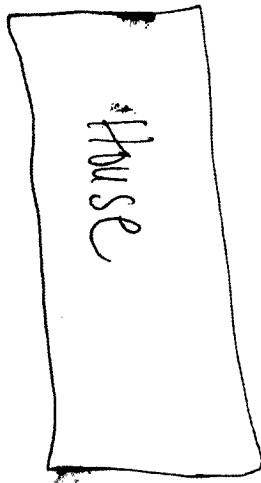

road

