



Prepared by and return to:
 William J. Fox PLS
 Iowa Department of Transportation
 District 4 Office
 2210 E. 7th Street
 Atlantic, IA 50022
 Phone 712-243-7661



Document 2018 3704

Book 2018 Page 3704 Type 06 043 Pages 1
 Date 11/15/2018 Time 10:35:56AM
 Rec Amt \$7.00

INDX
 ANNO
 SCAN
 CHEK

LISA SMITH, COUNTY RECORDER
 MADISON COUNTY IOWA




**UNITED STATES PUBLIC LAND SURVEY CORNER CERTIFICATE
 OF**

Land Survey Monuments situated in Section 25, Township 76N North, Range 28W West, of the Fifth Principal Meridian, MADISON County, Iowa. Previously recorded in _____ in the County Recorder's Office.

Monument Description and Remarks:

(1) Fd. nail hole with sound that fit existing ties. Set Iowa D.O.T. brass plug after asphalt overlay.

PLAN - VIEW

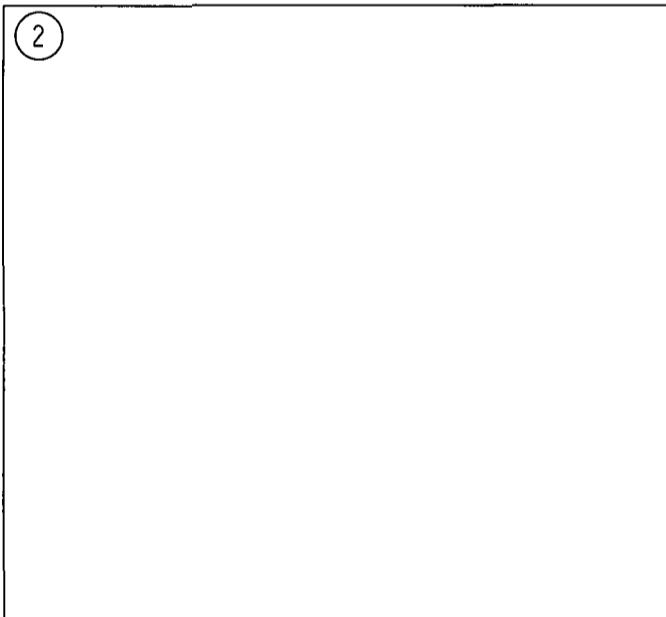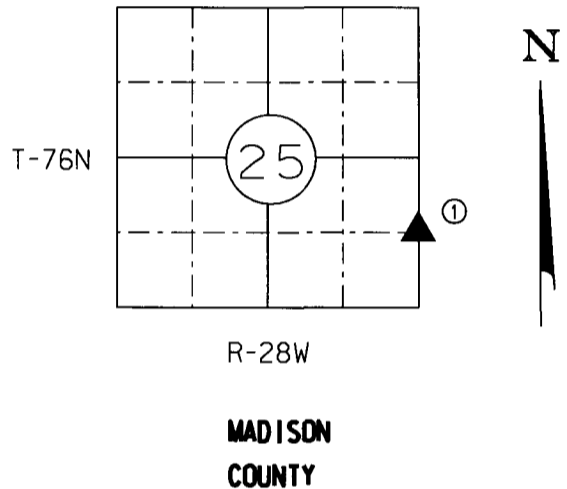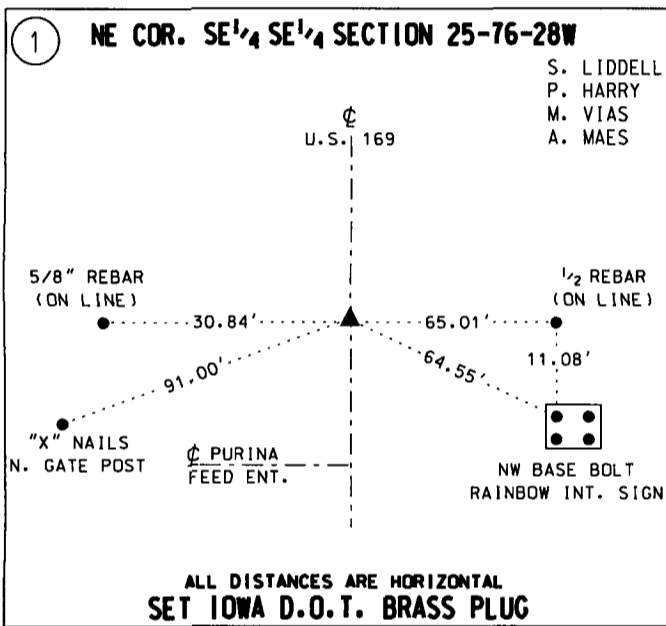

I hereby certify that this land surveying document was prepared by me or under my direct personal supervision, and that I am a duly licensed Professional Land Surveyor under the laws of the State of Iowa.

William J. Fox 10-1-18
 William J. Fox License No. 15482 Date
 My license renewal date is December 31, 2019

Corner(s) to be Indexed			
Corner(s)	Section	Twp.	Range
NE CORNER SE ¹ / ₄ SE ¹ / ₄	25	76	28W