
Sec. No. 11, Township 77, Range 27.

FILED NO. 1348
BOOK 1 PAGE 101
1974 AUG 19 PM 2:53
MARY E. [illegible]
RECORDER
MADISON COUNTY, IOWA

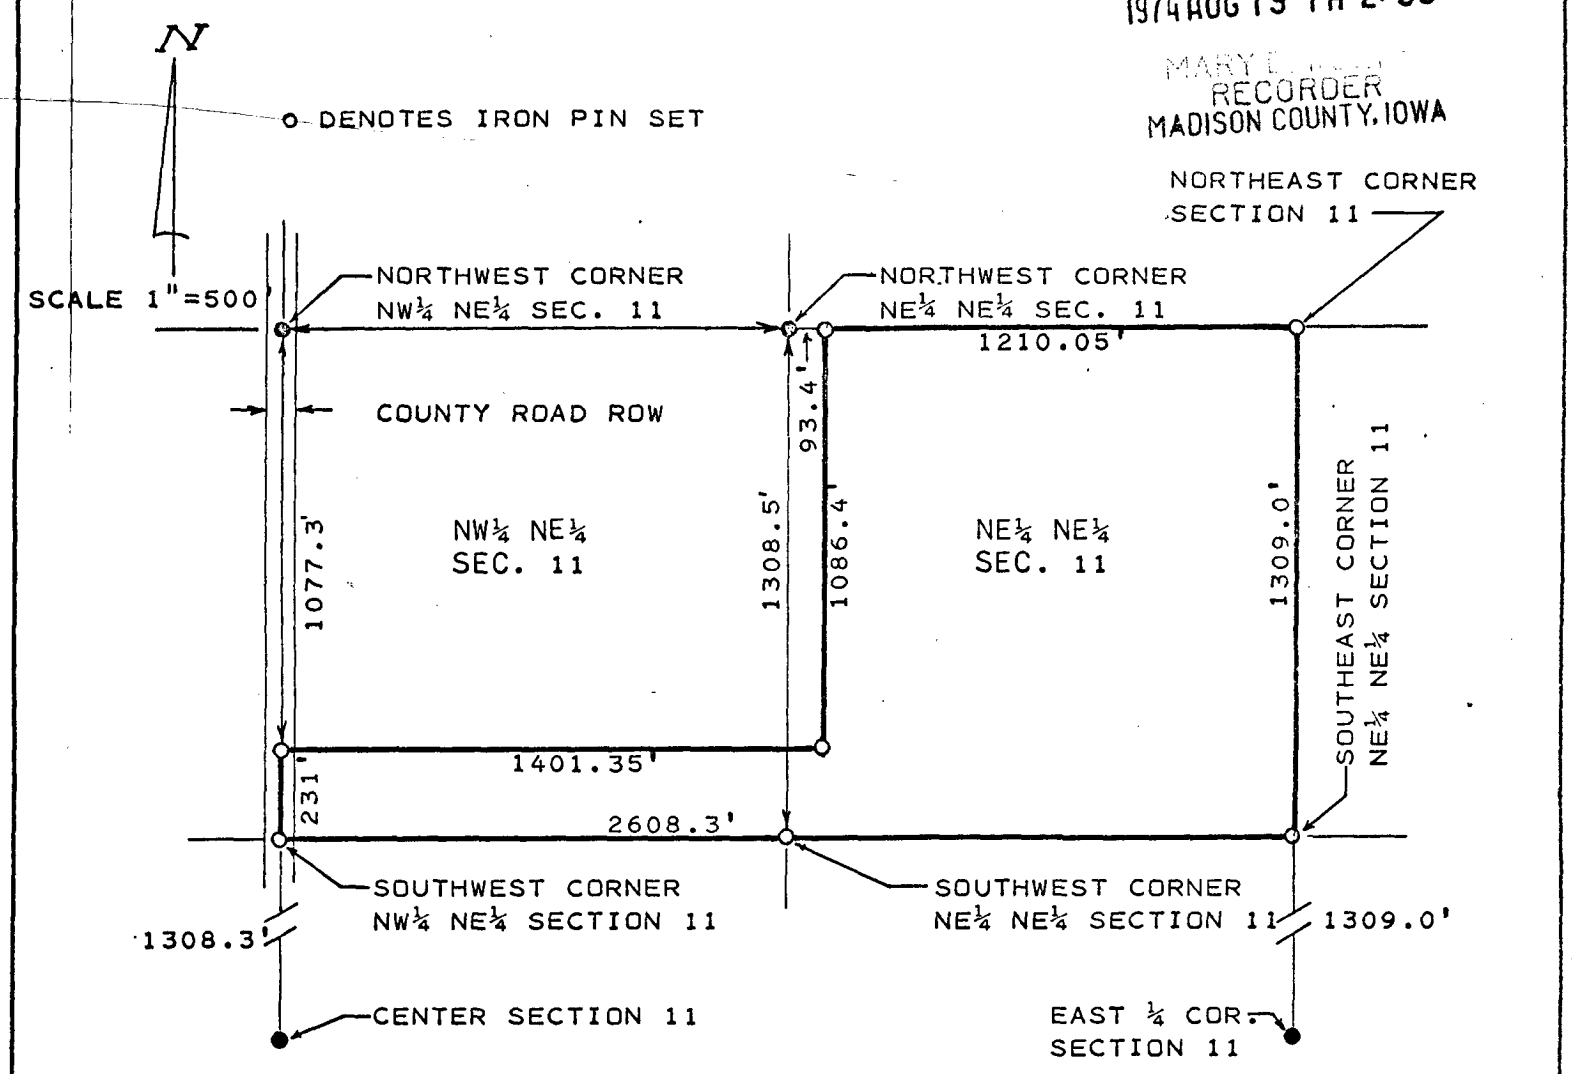


The above tract is described as beginning at an iron pin on the northeast corner of Section 11, T77N, R27W of the 5th PM thence south along the east line of the northeast quarter (NE¼) of the northeast quarter (NE¼) a distance of one thousand three hundred nine (1309.0) feet to an iron pin on the southeast corner of the northeast quarter (NE¼) of the northeast quarter (NE¼) of said Section 11, thence west along the south line of the north half (N½) of the northeast quarter of said Section 11 a distance of two thousand six hundred eight and three tenths (2608.3) feet to an iron pin on the southwest corner of the northwest quarter (NW¼) of the north east quarter (NE¼) of said Section 11, thence north along the west line of the northwest quarter (NW¼) of the northeast quarter (NE¼) of said Section 11 a distance of two hundred thirty one (231.0) feet to an iron pin, thence easterly a distance of one thousand four hundred one and thirty five hundredths (1401.35) feet to an iron pin. Thence northerly a distance of one thousand eighty six and four tenths (1086.4) feet to an iron pin on the north line of the northeast quarter (NE¼) of the northeast quarter NE¼) of said Section 11, thence easterly along the north line of the northeast quarter (NE¼) of the northeast quarter (NE¼) of said Section 11 a distance of one thousand two hundred ten and five hundredths (1210.05) feet to the point of beginning, containing 44 acres more or less subject to all recorded easements.

Subscribed and sworn to before me this 1st day of March, 1974.
Robert Irving
Notary Public
(SEAL)

I, Lynn W. Sickels, a duly registered Professional Engineer & Land Surveyor, do hereby certify that the above plat is a true representation of the survey made by me in accordance with the laws of the State of Iowa on March 1, 1974
Lynn Sickels
Lynn W. Sickels, P.E. & L.S. 5076

survey for
IOWA CONSERVATION COMMISSION
date June 24, 1974

MID-STATE ENGINEERING
BOX 39
CRESTON, IOWA 50801