
Sec. No. 10, Township 77, Range 27.

FILED NO. 1349
BOOK 1 PAGE 102
1974 AUG 19 PM 2:54
MARY E. [illegible]
RECORDER
MADISON COUNTY, IOWA

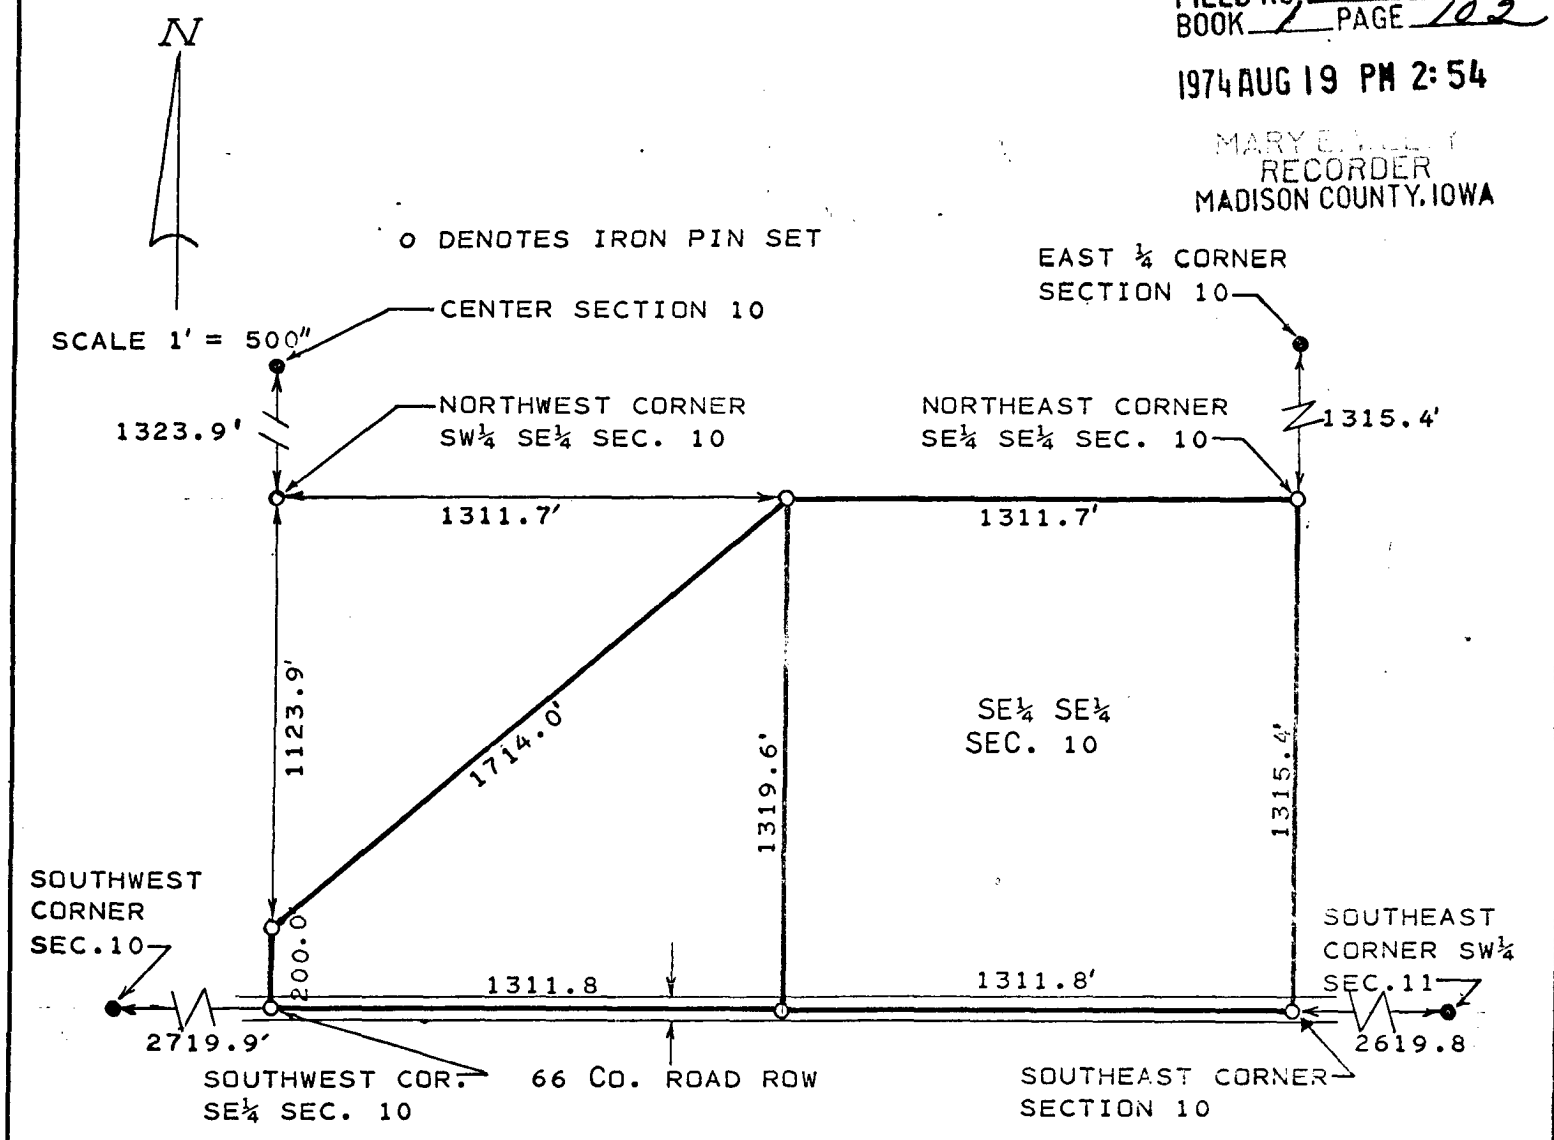

The above tracts are described as the southeast quarter (SE¼) of the southeast quarter (SE¼) of Section 10, township 77N, Range 27W of the 5th PM, Madison County, Iowa, and a parcel in the southwest quarter (SW¼) of the southeast quarter (SE¼) of said Section 10 described as beginning at an iron pin on the northeast corner of the southwest quarter (SW¼) of the southeast quarter (SE¼) of said Section 10, thence south along the east line of the southwest quarter (SW¼) of the southeast quarter (SE¼) of said Section 10 a distance of one thousand three hundred nineteen and six tenths (1319.6) feet to an iron pin on the south line of the southeast quarter (SE¼) of said Section 10, thence west along the south line of the southeast quarter of said Section 10 a distance of one thousand three hundred eleven and eight tenths (1311.8) feet to an iron pin on the southwest corner of the southwest quarter (SW¼) of the southeast quarter (SE¼) of said Section 10, thence north along the west line of the southwest quarter (SW¼) of the southeast quarter (SE¼) of said Section 10 a distance of two hundred (200.0) feet to an iron pin, thence northeasterly a distance of one thousand seven hundred fourteen (1714.0) feet to the point of beginning, containing 63 acres more or less subject to all recorded easements.

Subscribed and sworn to before me this 1st day of March, 1974
Robert Trunk
Notary Public
(SEAL)

I, Lynn W. Sickels, a duly registered Professional Engineer & Land Surveyor, do hereby certify that the above plat is a true representation of the survey made by me in accordance with the laws of the State of Iowa on March 1, 1974.

Lynn Sickels
Lynn W. Sickels, P.E. & L.S. 5076

survey for
IOWA CONSERVATION COMMISSION

date June 24, 1974

MID-STATE ENGINEERING
BOX 39
CRESTON, IOWA 50801