
Sec. No. 11, Township 77, Range 27.

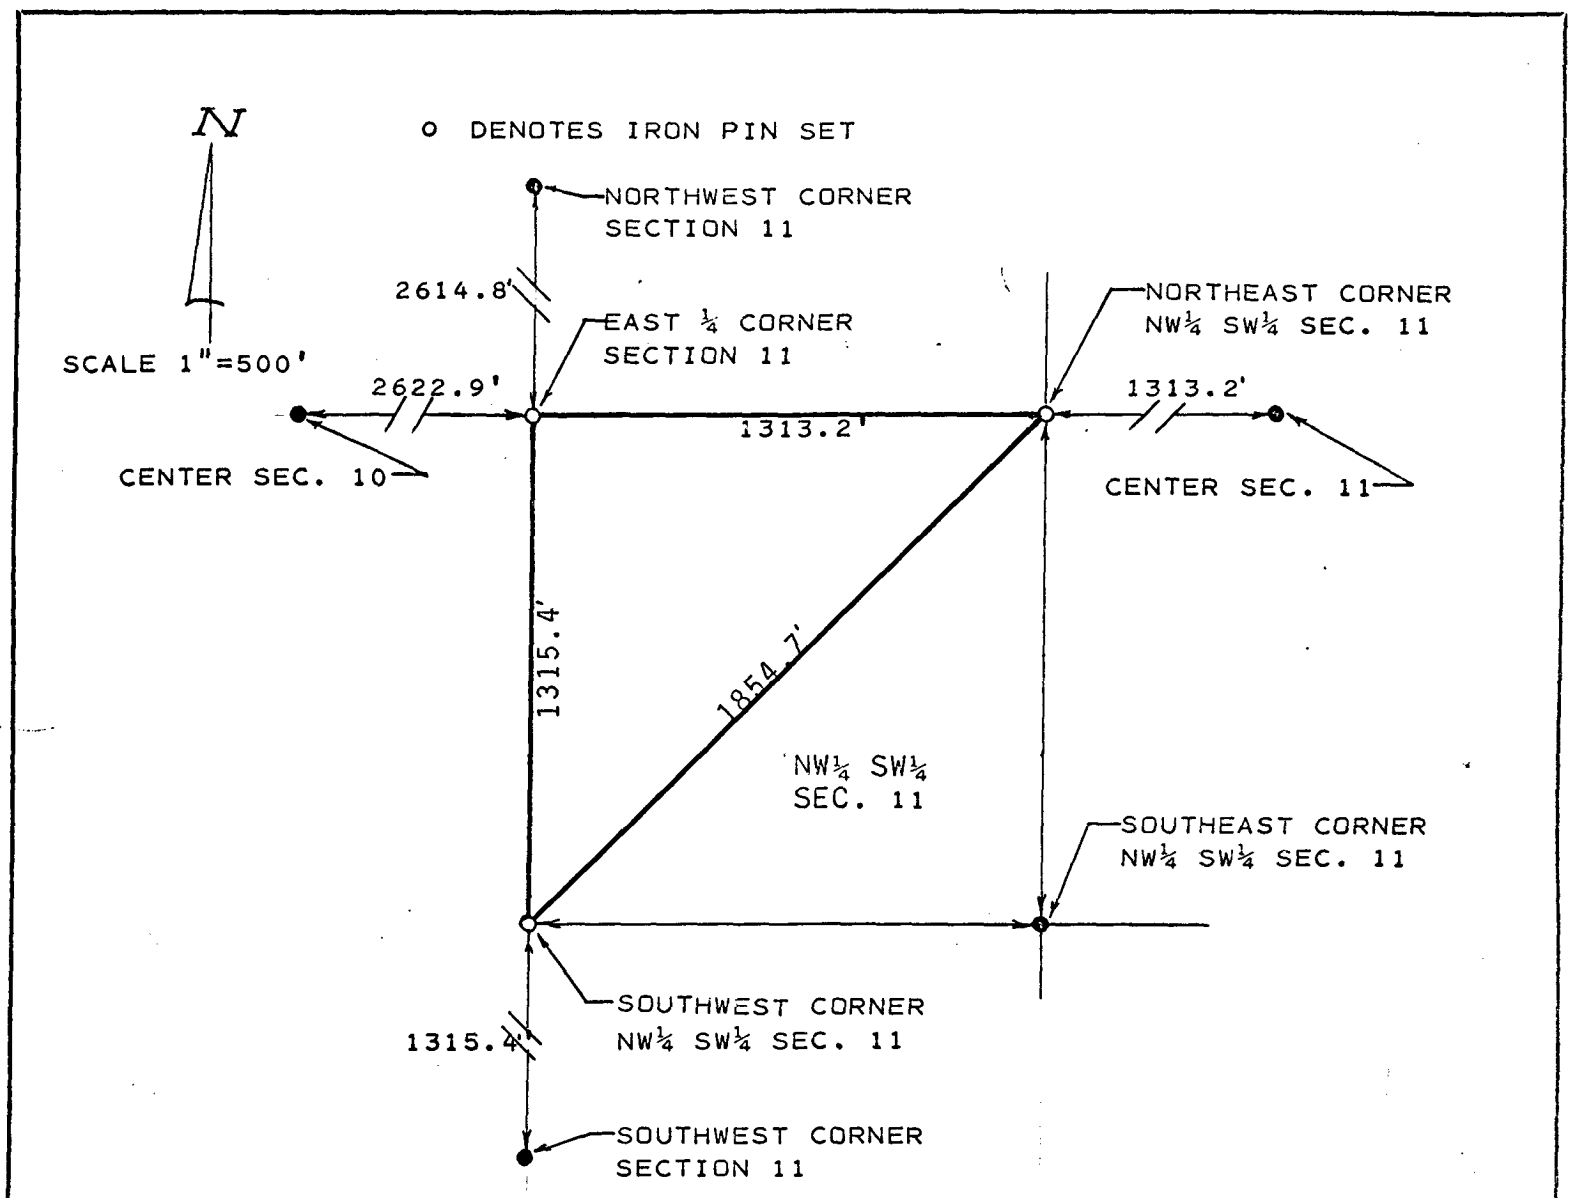

The above tract is described as the northwest half (NW½) of the northwest quarter (NW¼) of the southwest quarter (SW¼) of Section 11, T77N, R27W of the 5th PM located in Madison County, Iowa, containing 20 acres more or less subject to all recorded easements.

1350
FILED NO.
BOOK 1 PAGE 103
1974 AUG 19 PM 2:56
MARY L. [illegible]
RECORDER
MADISON COUNTY, IOWA

Subscribed and sworn to before me this 1st day of March, 19 74
B. Lou Stringer
Notary Public
(SEAL)

I, Lynn W. Sickels, a duly registered Professional Engineer & Land Surveyor, do hereby certify that the above plat is a true representation of the survey made by me in accordance with the laws of the State of Iowa on March 1, 1974
Lynn Sickels
Lynn W. Sickels, P.E. & L.S. 5076

survey for
IOWA CONSERVATION COMMISSION
date June 24, 1974

MID-STATE ENGINEERING
BOX 39
CRESTON, IOWA 50801