
Sec. No. 14, Township 77, Range 27.

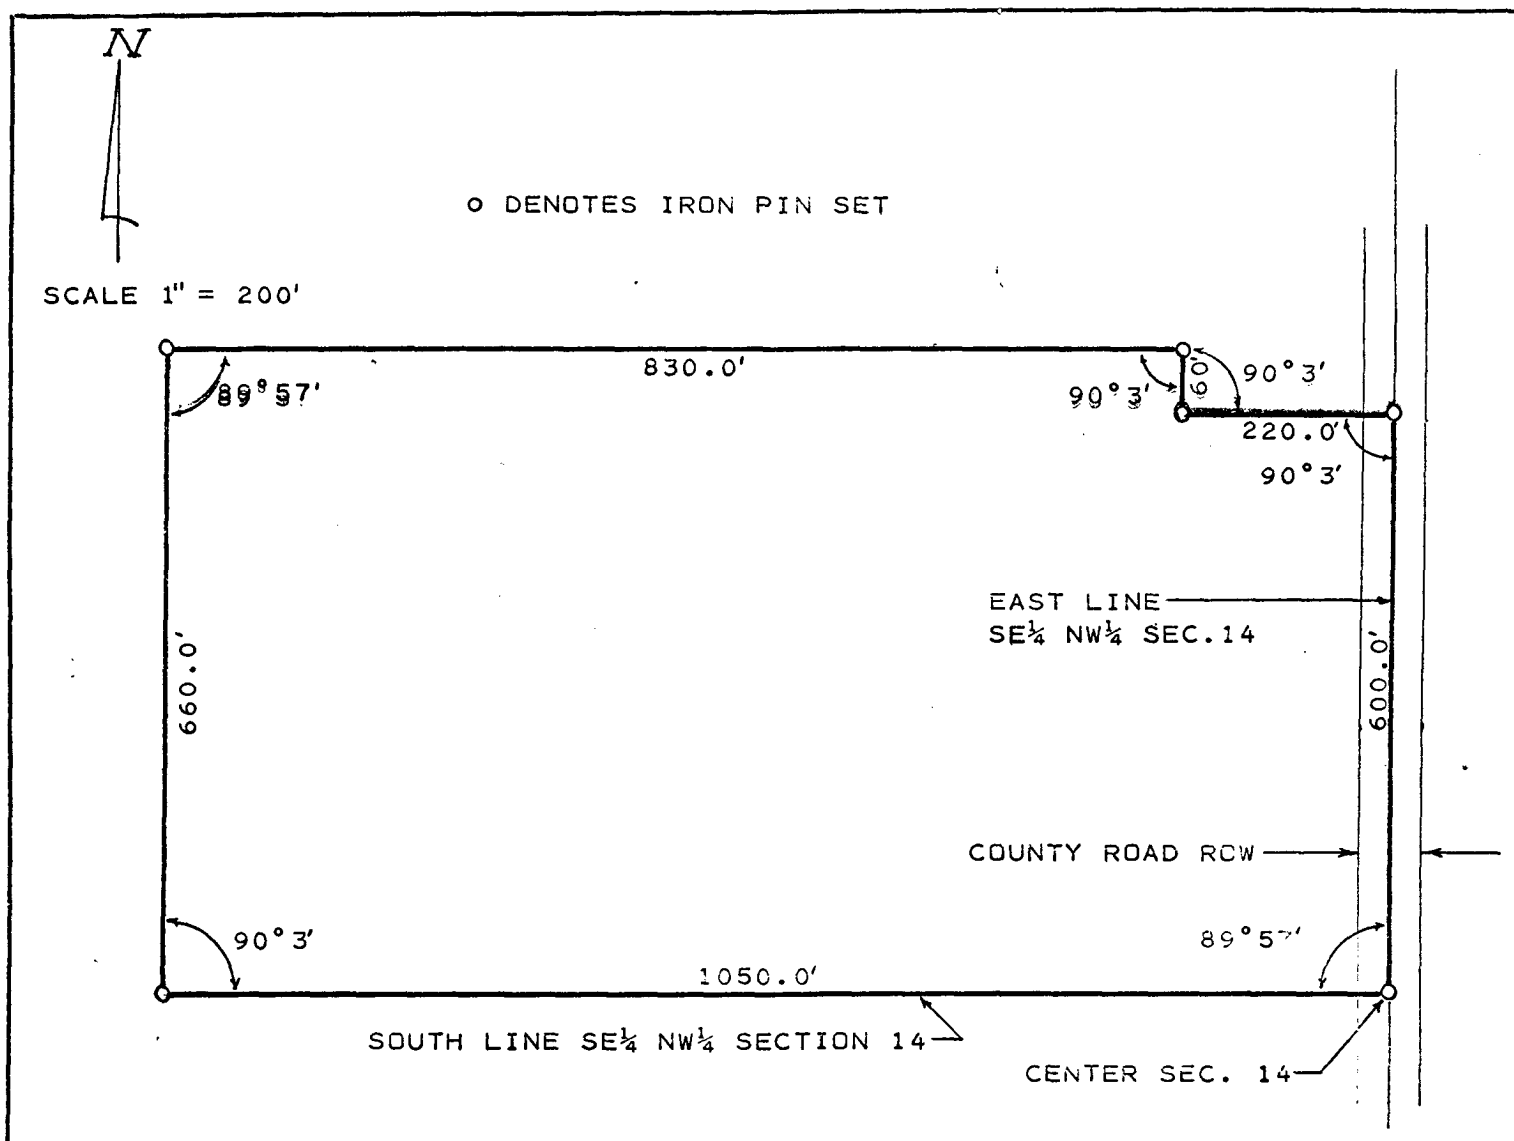

The above tract is described as the south six hundred sixty **(660.0)** feet of the east one thousand fifty (1050.0) feet of the southeast quarter (SE¼) of the northwest quarter (NW¼) of Section 14, T77N, **R27W** of the 5th PM located in Madison County, Iowa, except the north sixty (60.0) feet of the east two hundred twenty (220.0) feet thereof containing 15.5 acres more or less subject to all recorded easements.

FILED NO. 1353
BOOK 1 PAGE 106
1974 AUG 19 PM 2:59
MARY [illegible]
RECORDER
MADISON COUNTY, IOWA

Subscribed and sworn to before me this 1st day of March, 1974
[illegible]
Notary Public
(SEAL)

I, Lynn W. Sickels, a duly registered Professional Engineer & Land Surveyor, do hereby certify that the above plat is a true representation of the survey made by me in accordance with the laws of the State of Iowa on March 1, 1974
Lynn Sickels
Lynn W. Sickels, P.E. & L.S. [illegible]

survey for
IOWA CONSERVATION COMMISSION
date June 24, 1974

MID-STATE ENGINEERING
BOX 99
CRESTON, IOWA 50801