
Sec. No. 12, Township 77, Range 27.

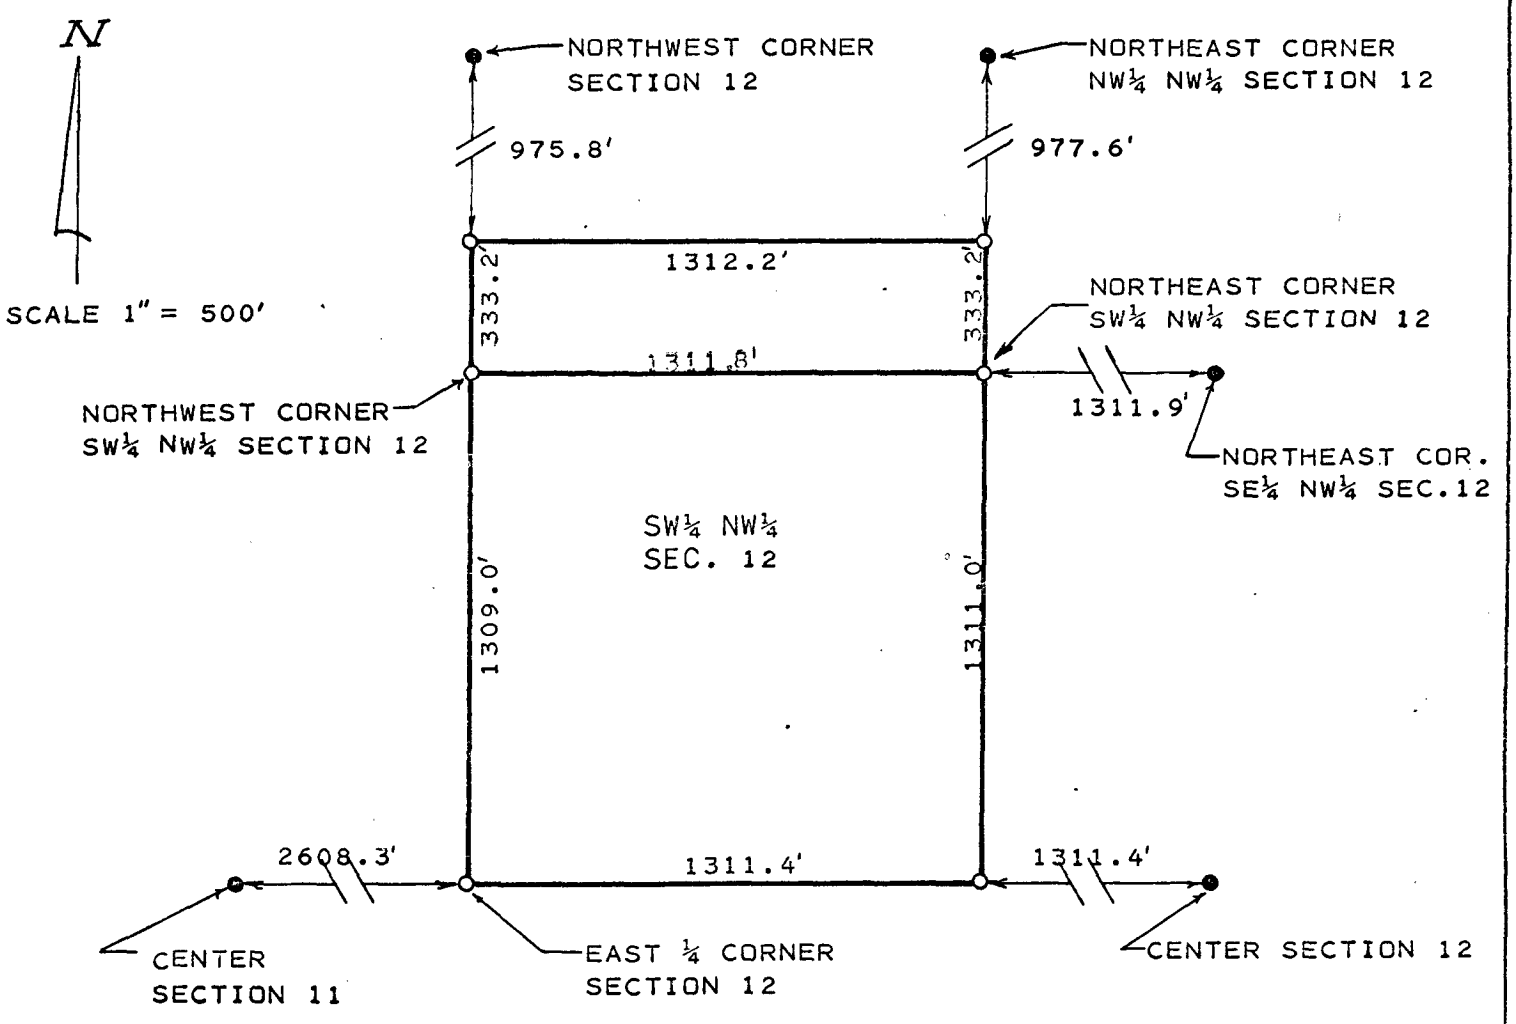

o DENOTES IRON PIN SET

The above tracts are described as the southwest quarter (SW¼) of the northwest quarter (NW¼) of Section 12, T77N, R27W of the 5th PM located in Madison County, Iowa, and the south ten (10.0) acres of the northwest quarter (NW¼) of the northwest quarter (NW¼) of said Section 12 containing 50 acres more or less subject to all recorded easements.

FILED NO. 1354
BOOK 1 PAGE 107
1974 AUG 19 PM 3:00
MARY E. [illegible]
RECORDER
MADISON COUNTY, IOWA

Subscribed and sworn to before me this 1st day of March, 1974
Robert Trimble
Notary Public
(SEAL)

I, Lynn W. Sickels, a duly registered Professional Engineer & Land Surveyor, do hereby certify that the above plat is a true representation of the survey made by me in accordance with the laws of the State of Iowa on March 1, 1974
Lynn Sickels
Lynn W. Sickels, P.E. & L.S. 5076

survey for
IOWA CONSERVATION COMMISSION
date June 24, 1974

MID-STATE ENGINEERING
BOX 39
CRESTON, IOWA 50801