
Sec. No. 12, Township 75, Range 27.

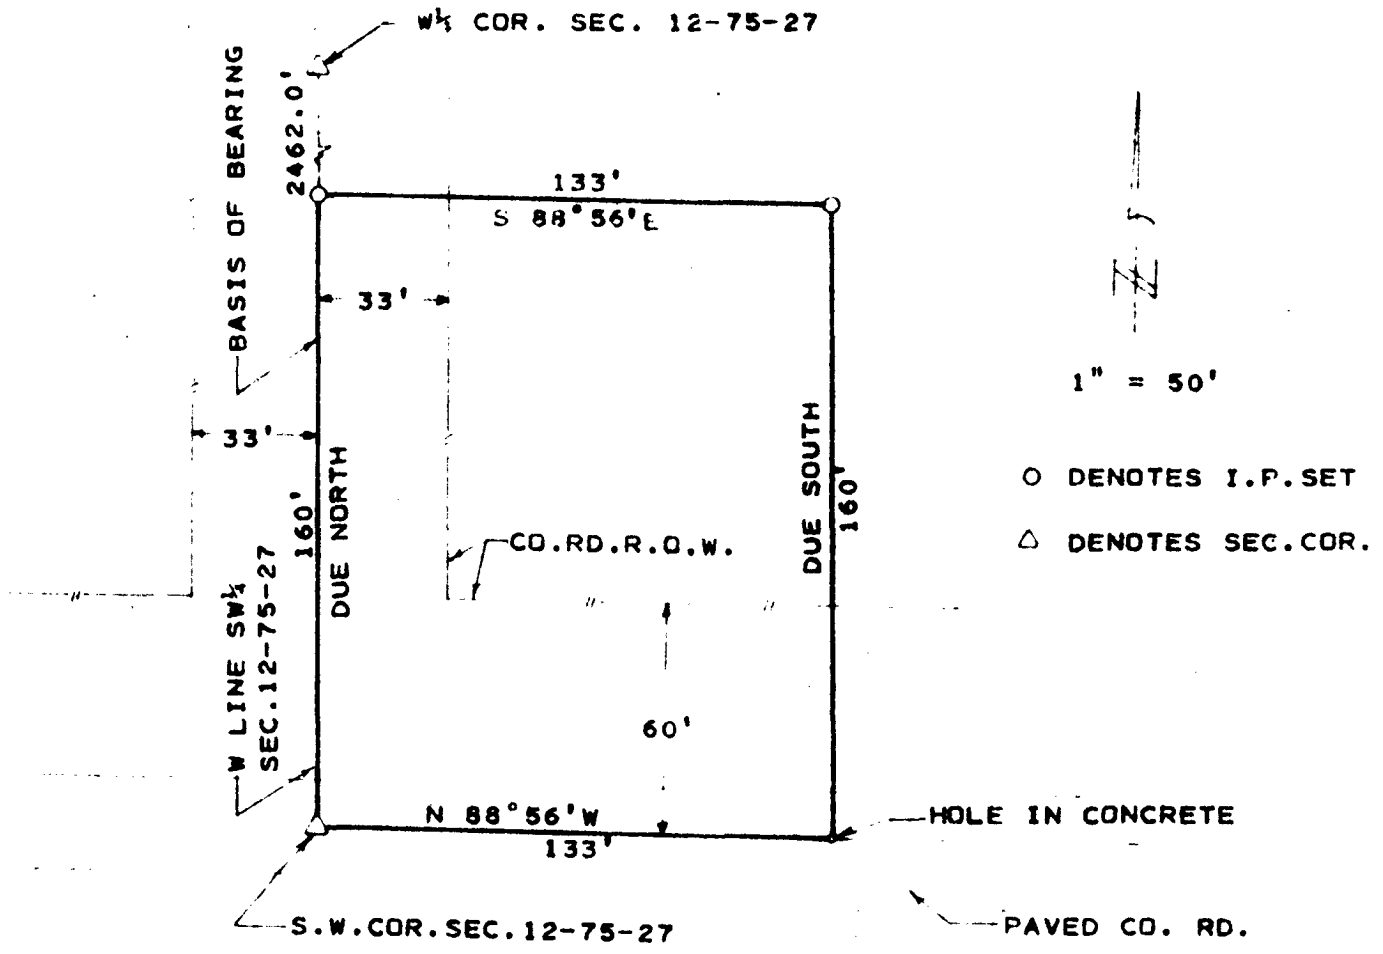

A tract of land in the Southwest Quarter of Section 12, Township 75 North, Range 27 West of the 5th PM, Madison County, Iowa, more particularly described as

Beginning at the SW corner of said Section 12, thence due north along the west line of the SW¼ of said Section 12 a distance of 160.0 feet to an iron pin, thence S 88°56'E a distance of 133.0 feet to an iron pin, thence due south a distance of 160.0 feet to a point on the south line of the SW¼ of said Section 12, said point being marked by a hole in the concrete pavement, thence N 88°56'W along the south line of the SW¼ of said Section 12 a distance of 133.0 feet to the true point of beginning, containing 0.5 acres more or less, subject to all recorded easements.

Plat FILED NO. 988
BOOK 1 PAGE 116

1976 NOV 24 AM 9:44

MARY E. WELTY
RECORDER
MADISON COUNTY, IOWA
Fee 2 50

Subscribed and sworn to before me this 2nd day of Nov., 1976
Donna Thach
Notary Public
(SEAL)

I, Lynn W. Sickels, a duly registered Professional Engineer & Land Surveyor, do hereby certify that the above plat is a true representation of the survey made by me in accordance with the laws of the State of Iowa on 11-2, 1976.
Lynn W. Sickels, P.E. & L.S. 5076

survey for
GREENFIELD R.E.C.
date 11-2-76

MID-STATE ENGINEERING
BOX 39
CRESTON, IOWA 50801