
Sec. No. 34, Township 77, Range 29.

Plat of a Survey made for Willard Parkison in the West 60 Acres of the West Half of the Southeast Quarter of Section 34, Township 77 North, Range 29 West of the 5th P.M., Madison County, Iowa.

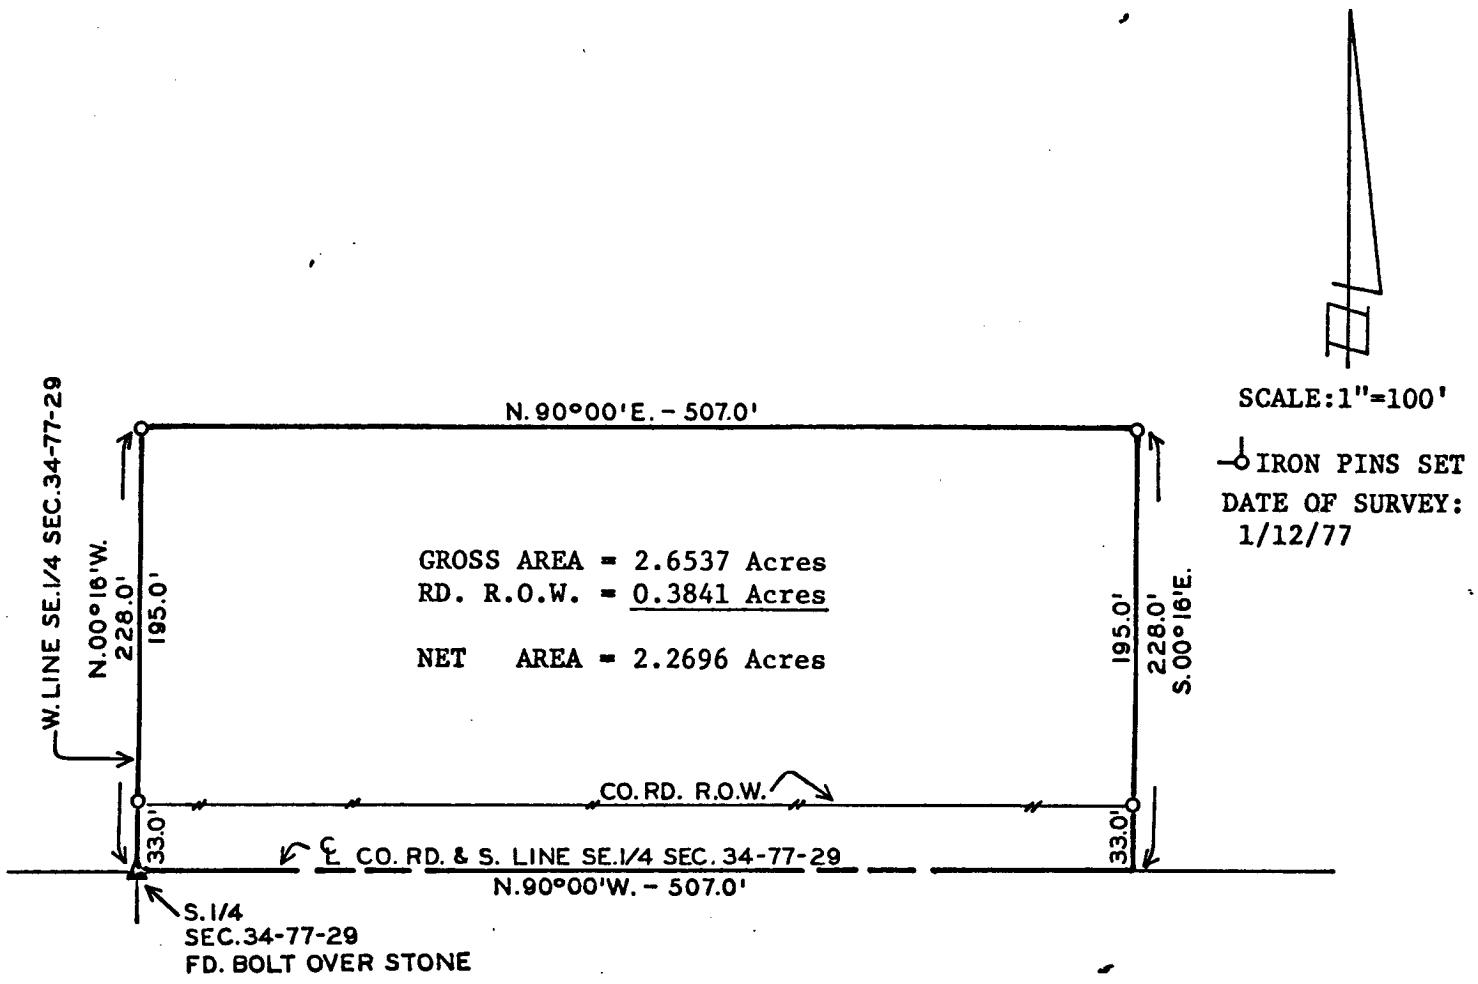

DESCRIPTION:

A parcel of land described as commencing at the South Quarter Corner of Section 34, Township 77 North, Range 29 West of the 5th P.M., Madison County, Iowa thence N.00°16'W. along the West line of the Southeast Quarter of said Section 34 228.0 feet; thence N.90°00'E. 507.0 feet; thence S.00°16'E. 228.0 feet to the South line of the Southeast Quarter of said Section 34; thence N.90°00'W. 507.0 feet to Point of Beginning containing 2.6537 Acres including 0.3841 Acres of County Road Right-of-Way.

NOTE: South line of the Southeast Quarter of Section 34, Township 77 North, Range 29 West of the 5th P.M., is assumed to bear due East and West.

1287

FILED NO. _____
BOOK 1 PAGE 119
Plat Book
1977 JAN 17 PM 3:27

MARY E. WELTY
RECORDER
MADISON COUNTY, IOWA

I hereby certify that this plat, map, survey or report was made by me or under my direct personal supervision and that I am a duly registered Land Surveyor under the laws of the State of Iowa

Signed J. M. Hochstetler Date Jan. 13 1977

J. M. Hochstetler, P.E., L.S. Iowa Reg. No. 6808

VANCE & HOCHSTETLER
CONSULTING ENGINEERS
WINTERSET, IOWA