
Sec. No. 10, Township 75, Range 28.

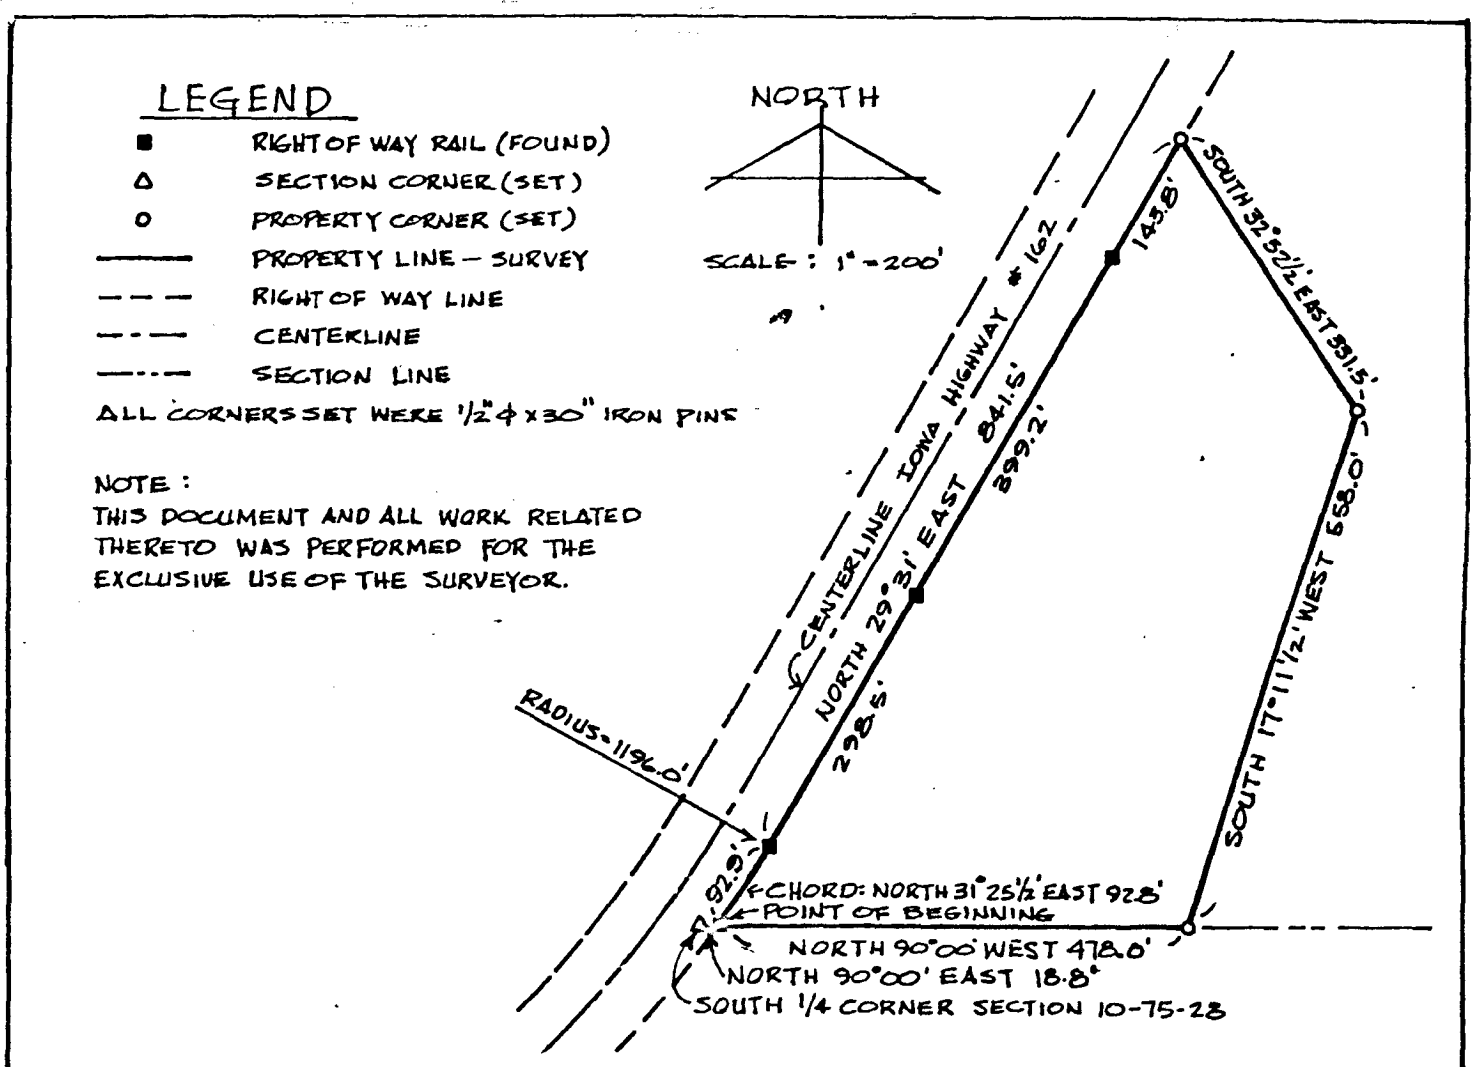

I, Tedde R. Blunck, Registered Engineer and Land Surveyor in the State of Iowa, hereby certify that on April 22, 1978, I completed a survey of the following described property:

Commencing as a point of reference at the South quarter corner of Section 10, Township 75 North, Range 28 West of the Fifth Principal Meridian, Madison County, Iowa;
thence North 90°00' East 18.8 feet along the South line of the Southeast quarter of said Section 10 to a point of intersection with the Easterly right of way line of Iowa highway 162 and the point of beginning of the tract herein described (this is an assumed bearing for purposes of this description only);
thence Northeasterly 92.9 feet along said Easterly right of way line of Iowa highway 162 being a 1196.0 foot radius curve concave Northwesterly (chord: North 31°25 1/2' East 92.8 feet) to a point of tangency;
thence North 29°31' East 841.5 feet along said Easterly right of way line of Iowa highway 162 to a point;
thence South 32°52 1/2' East 331.5 feet to a point;
thence South 17°11 1/2' West 558.0 feet to a point of intersection with said South line of the Southeast quarter of Section 10;
thence North 90°00' West 478.0 feet along said South line of the Southeast quarter of Section 10 to the point of beginning,
and subject to easements of record,
and containing 6.0 acres more or less

and located the property lines and set iron pins (except where found) at the corners thereof as shown on this plat and that this plat is a true and correct representation of said survey.

TEDDE R. BLUNCK REGISTERED IOWA

Signed Tedde R. Blunck
Tedde R. Blunck, P.E. & L.S.

Date April 26, 1978
Iowa Reg. No. 7044

Exhibit "A"

STATE OF IOWA, MADISON COUNTY ss.

PLAT

Inst. No. 129 S Filed for Record this 17 day of July 19 78 at 10:49 A.M.
Book 1 Page 139 Recording Fee filed with contract - 108-157 Mary E. Welty, Recorder By Deputy