
Sec. No. 19, Township 76, Range 28.

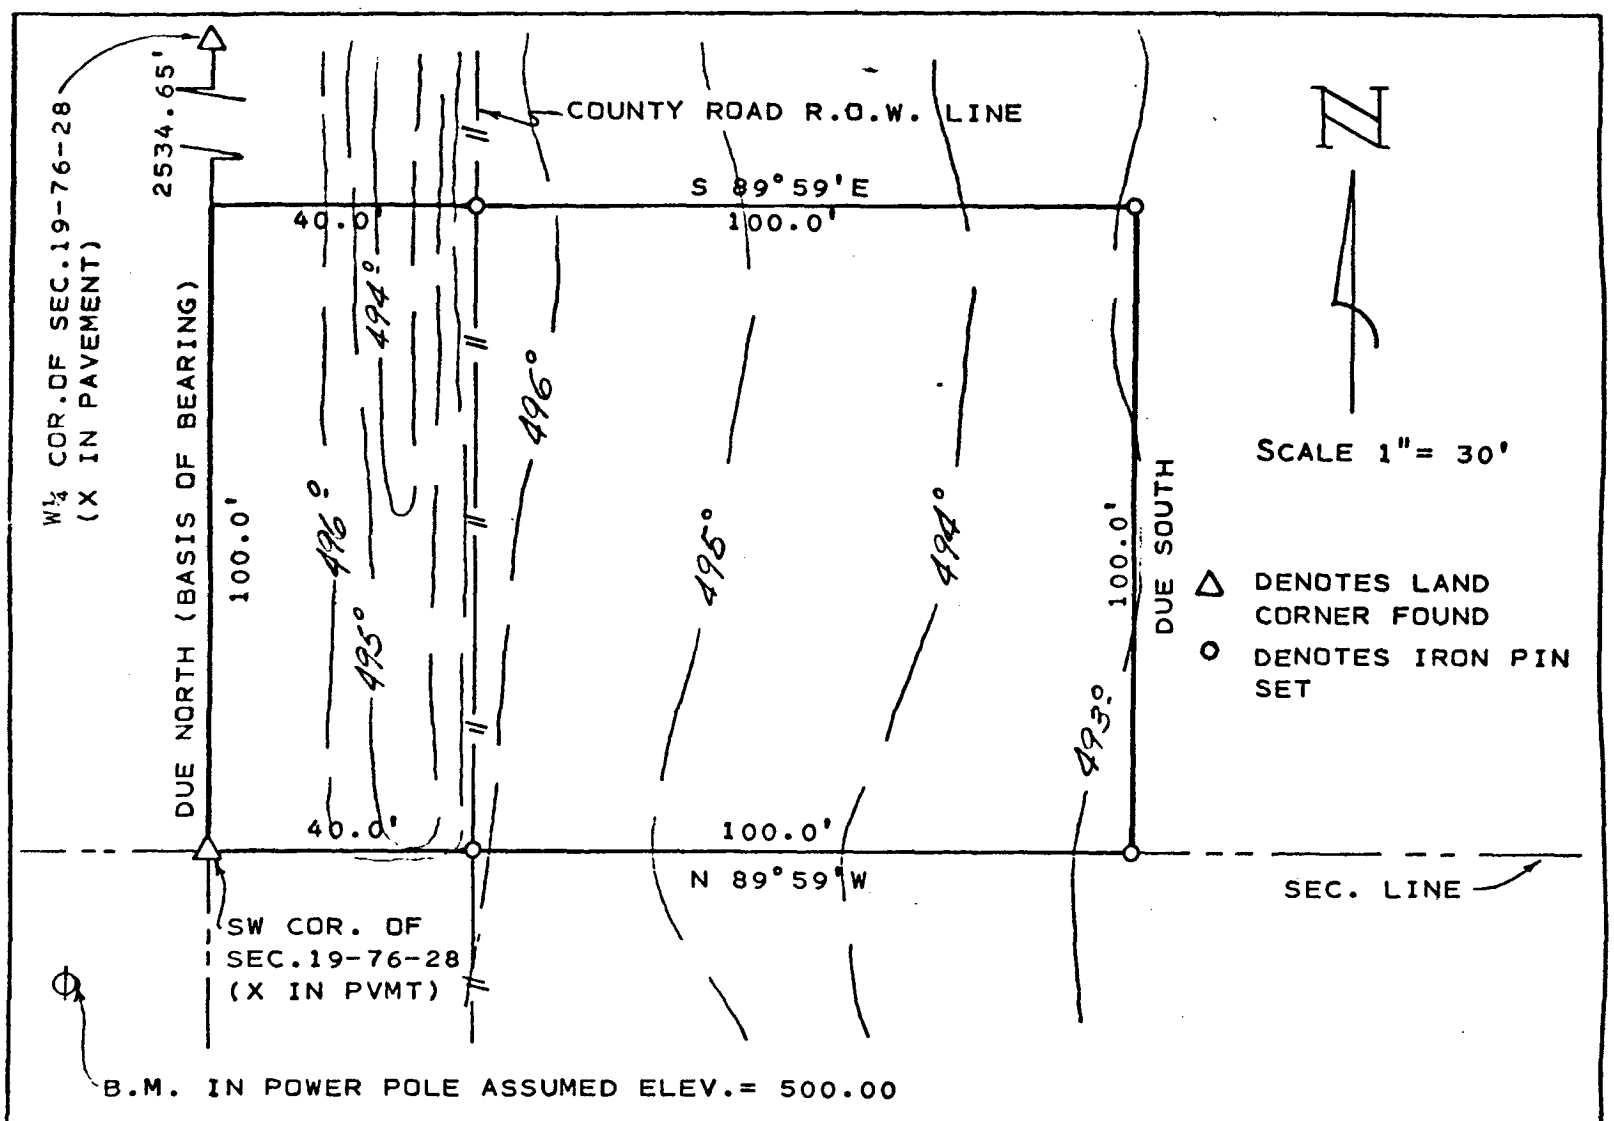

A tract of land in the SW¼ of the SW¼ of Section 19, Township 76 North, Range 28 West of the 5th PM, located in Madison County, Iowa, more particularly described as follows:

Beginning at the southwest corner of said Sec. 19-76-28, being the true point of beginning, thence due north along the west line of said Sec. 19-76-28, a distance of 100.0 feet to a point, thence S 89°59'E a distance of 40.0 feet to an iron pin being on the east R.O.W. line of a County Road, thence S 89°59'E a distance of 100.0 feet to an iron pin, thence due south a distance of 100.0 feet to an iron pin being on the south line of said Sec. 19-76-28, thence N 89°59'W along the south line of said Sec. 19-76-28 a distance of 100.0 feet to an iron pin being on the east R.O.W. line of a County Road, thence N 89°59'W a distance of 40.0 feet to the true point of beginning, containing 0.32 acres, subject to all recorded easements.

FILED NO. 574
BOOK 1 PAGE 144
PLAT BOOK
1978 SEP 14 PM 1:53

MARY E. WELTY
RECORDER
MADISON COUNTY, IOWA
Fee 3 00

DONNA
Subscribed and sworn to before me this 12th day of June, 1978

Notary Public

(SEAL)

I, Lynn Sickels, a duly registered Professional Engineer & Land Surveyor, do hereby certify that the above plat is a true representation of the land surveyed and that the survey was made by me in accordance with the laws of the State of Iowa on 6-12, 1978

Lynn Sickels, P.E. & L.S. 5076

survey for FARMERS ELEC. CO-OP
GREENFIELD, IOWA

date 6-12-78

MID-STATE ENGINEERING
BOX 39
CRESTON, IOWA 50801