
Sec. No. 26, Township 75, Range 28.

PLAT OF A SURVEY MADE FOR MRS. GLENN HORRAS IN THE S½ OF THE NW¼ OF SEC. 26-T75N-R28W OF THE 5TH P.M., MADISON COUNTY, IOWA.

FILED NO. 1470
BOOK 1 PAGE 146
1979 JAN 23 PM 1:13
MARY E. WELTY
RECORDER
MADISON COUNTY, IOWA
Fee 3 00

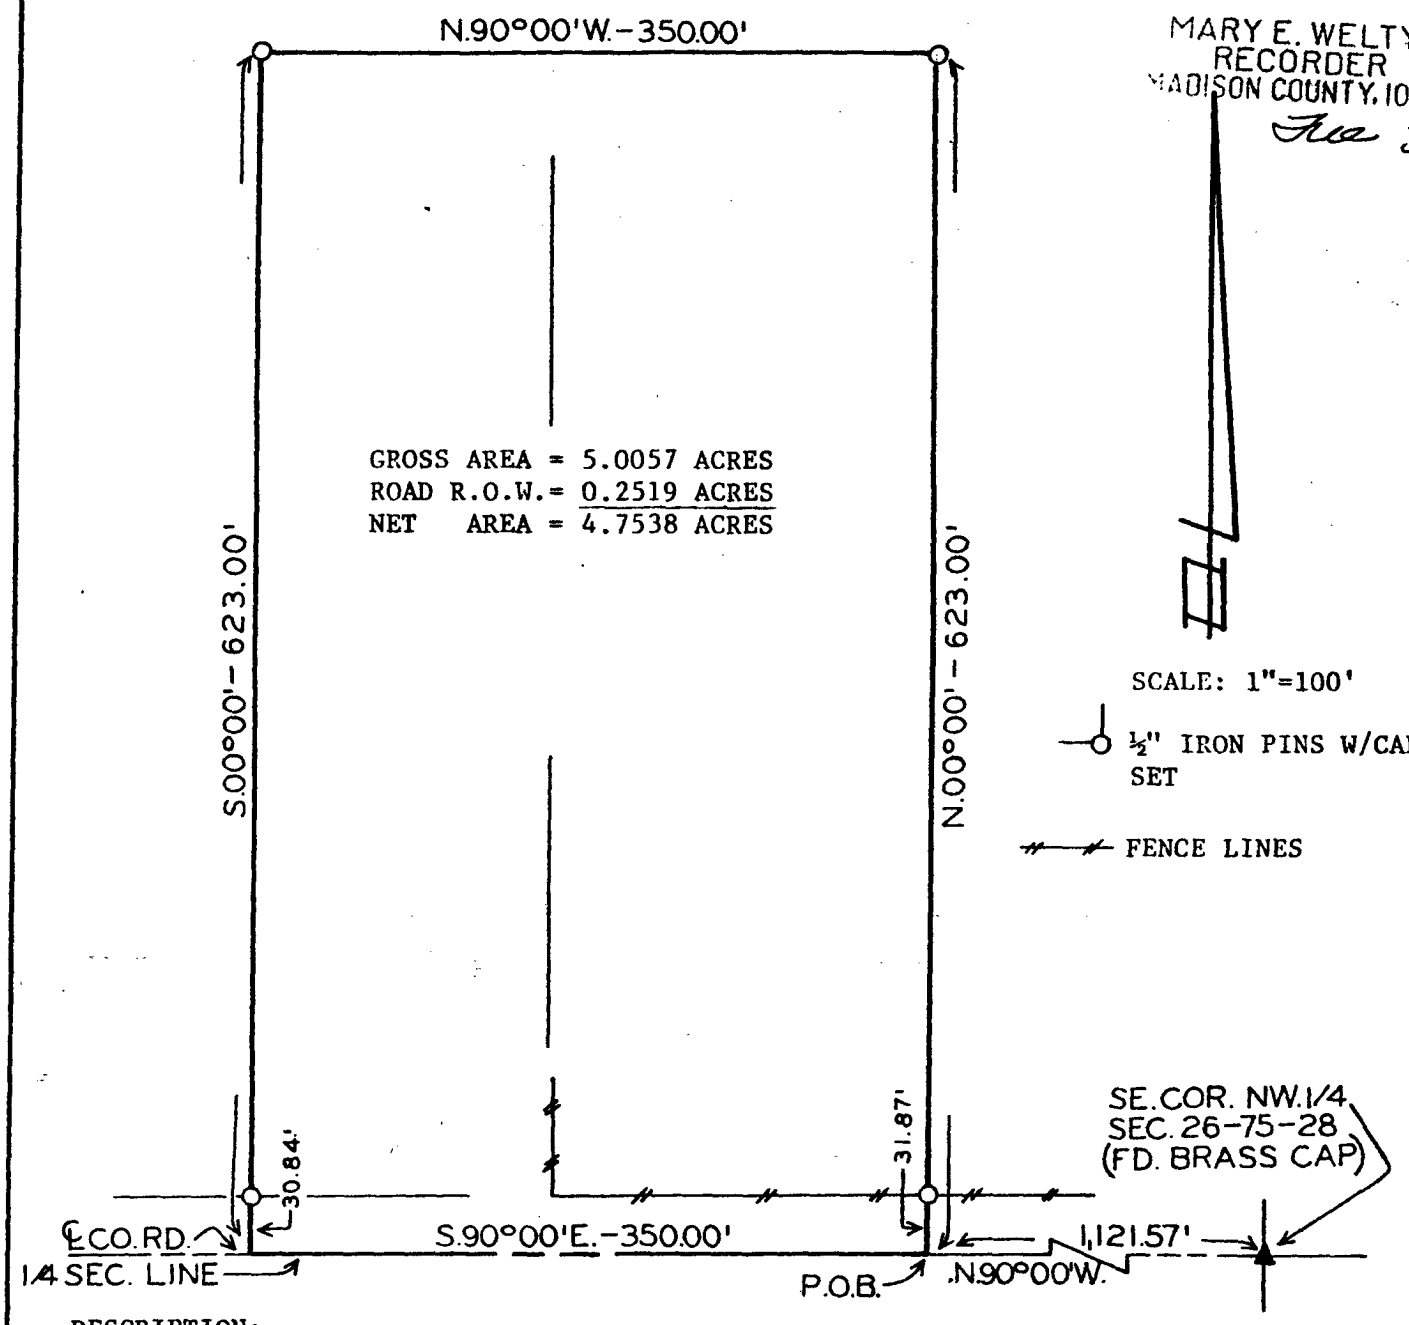


DESCRIPTION:
Commencing at the SE. Cor. of the NW¼ of Sec. 26-T75N-R28W of the 5th P.M., Madison County, Iowa, thence N.90°00'W. 1,121.57 feet along the south line of said NW¼ to the point of beginning. Thence N.00°00' 623.00 feet, thence N.90°00'W. 350.00 feet, thence S.00°00' 623.00 feet, thence S.90°00'E. 350.00 feet along the south line of said NW¼ to the point of beginning. Said parcel contains 5.0057 Acres including 0.2519 Acres of County Road Right-of-Way.

NOTE: The south line of the NW¼ of Sec. 26-75-28 is assumed to bear due east and west.

I hereby certify that this plat, map, survey or report was made by me or under my direct personal supervision and that I am a duly registered Land Surveyor under the laws of the State of Iowa

Signed J. M. Hochstetler Date Oct 31 1978

J. M. Hochstetler, P.E., L.S. Iowa Reg No 6808

VANCE & HOCHSTETLER, P.C.
CONSULTING ENGINEERS
WINTERSET, IOWA