
Sec. No. 36, Township 77, Range 28.

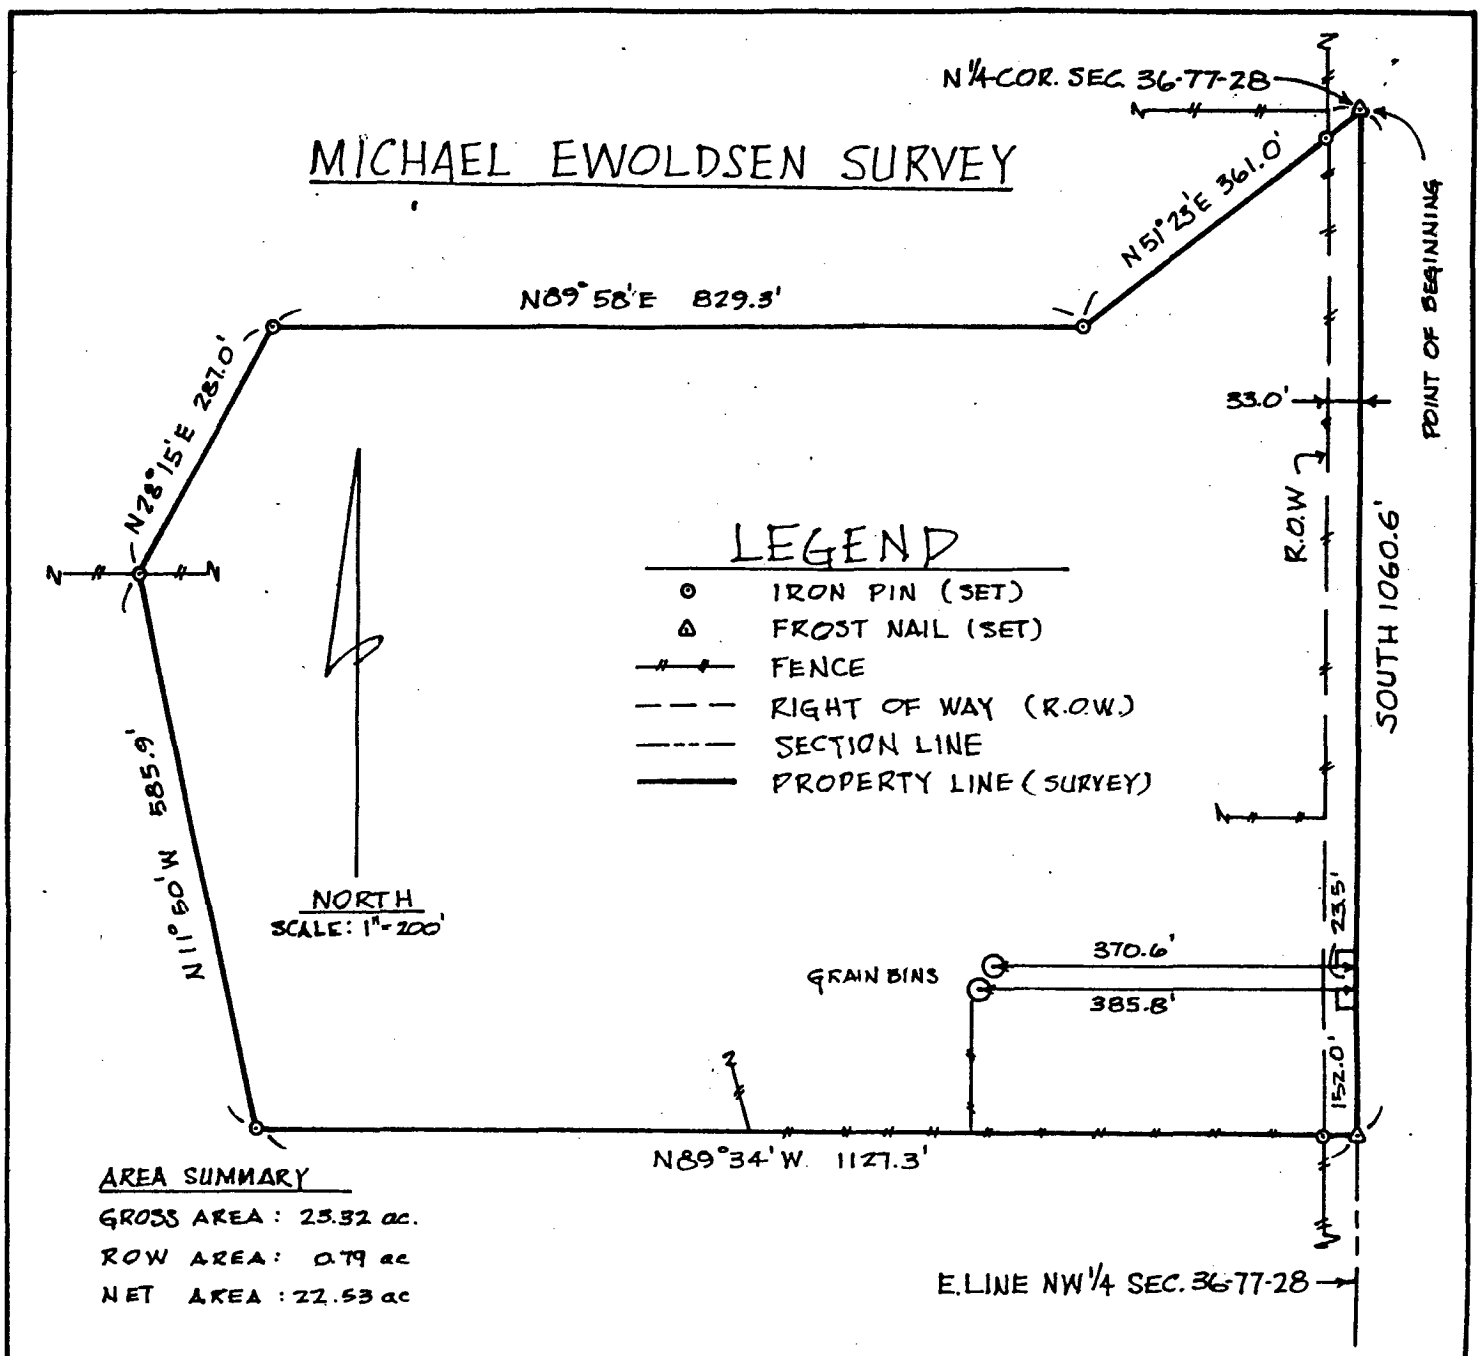

I, Tedde R. Blunck, Registered Engineer and Land Surveyor in the State of Iowa, hereby certify that on February 18, 1980, I surveyed the following described property for Michael Ewoldsen, R. R. 2, Winterset, Iowa:

Beginning at the North quarter corner of Section 36, Township 77 North, Range 28 West of the Fifth Principal Meridian, Madison Township, Madison County, Iowa;

thence South 1060.6 feet along the East line of the Northwest quarter of said Section 36 to a point (this is an assumed bearing for purposes of this description only);

thence North 89°34' West 1127.3 feet to a point;

thence North 11°50' West 585.9 feet to a point;

thence North 28°15' East 287.0 feet to a point;

thence North 89°58' East 829.3 feet to a point;

thence North 51°23' East 361.0 feet to the point of beginning,

and subject to easements of record,

and containing 23.3 acres, more or less,

and located the property lines and set iron pins at the corners thereof as shown on this plat and that this plat is a true and correct representation of said survey.

FILED NO. 1433
BOOK 1 PAGE 150
Farm Plat Book
1980 FEB 28 PM 1:29
MARY L. WELTY
RECORDER
MADISON COUNTY, IOWA
Fee 3.00

TEDDE R. BLUNCK REGISTERED 7044

Signed Tedde R. Blunck
Tedde R. Blunck, P.E. & L.S.

Dated February 23, 1980
Iowa Registration Number 7044