
CLARK CEMETERY SURVEY

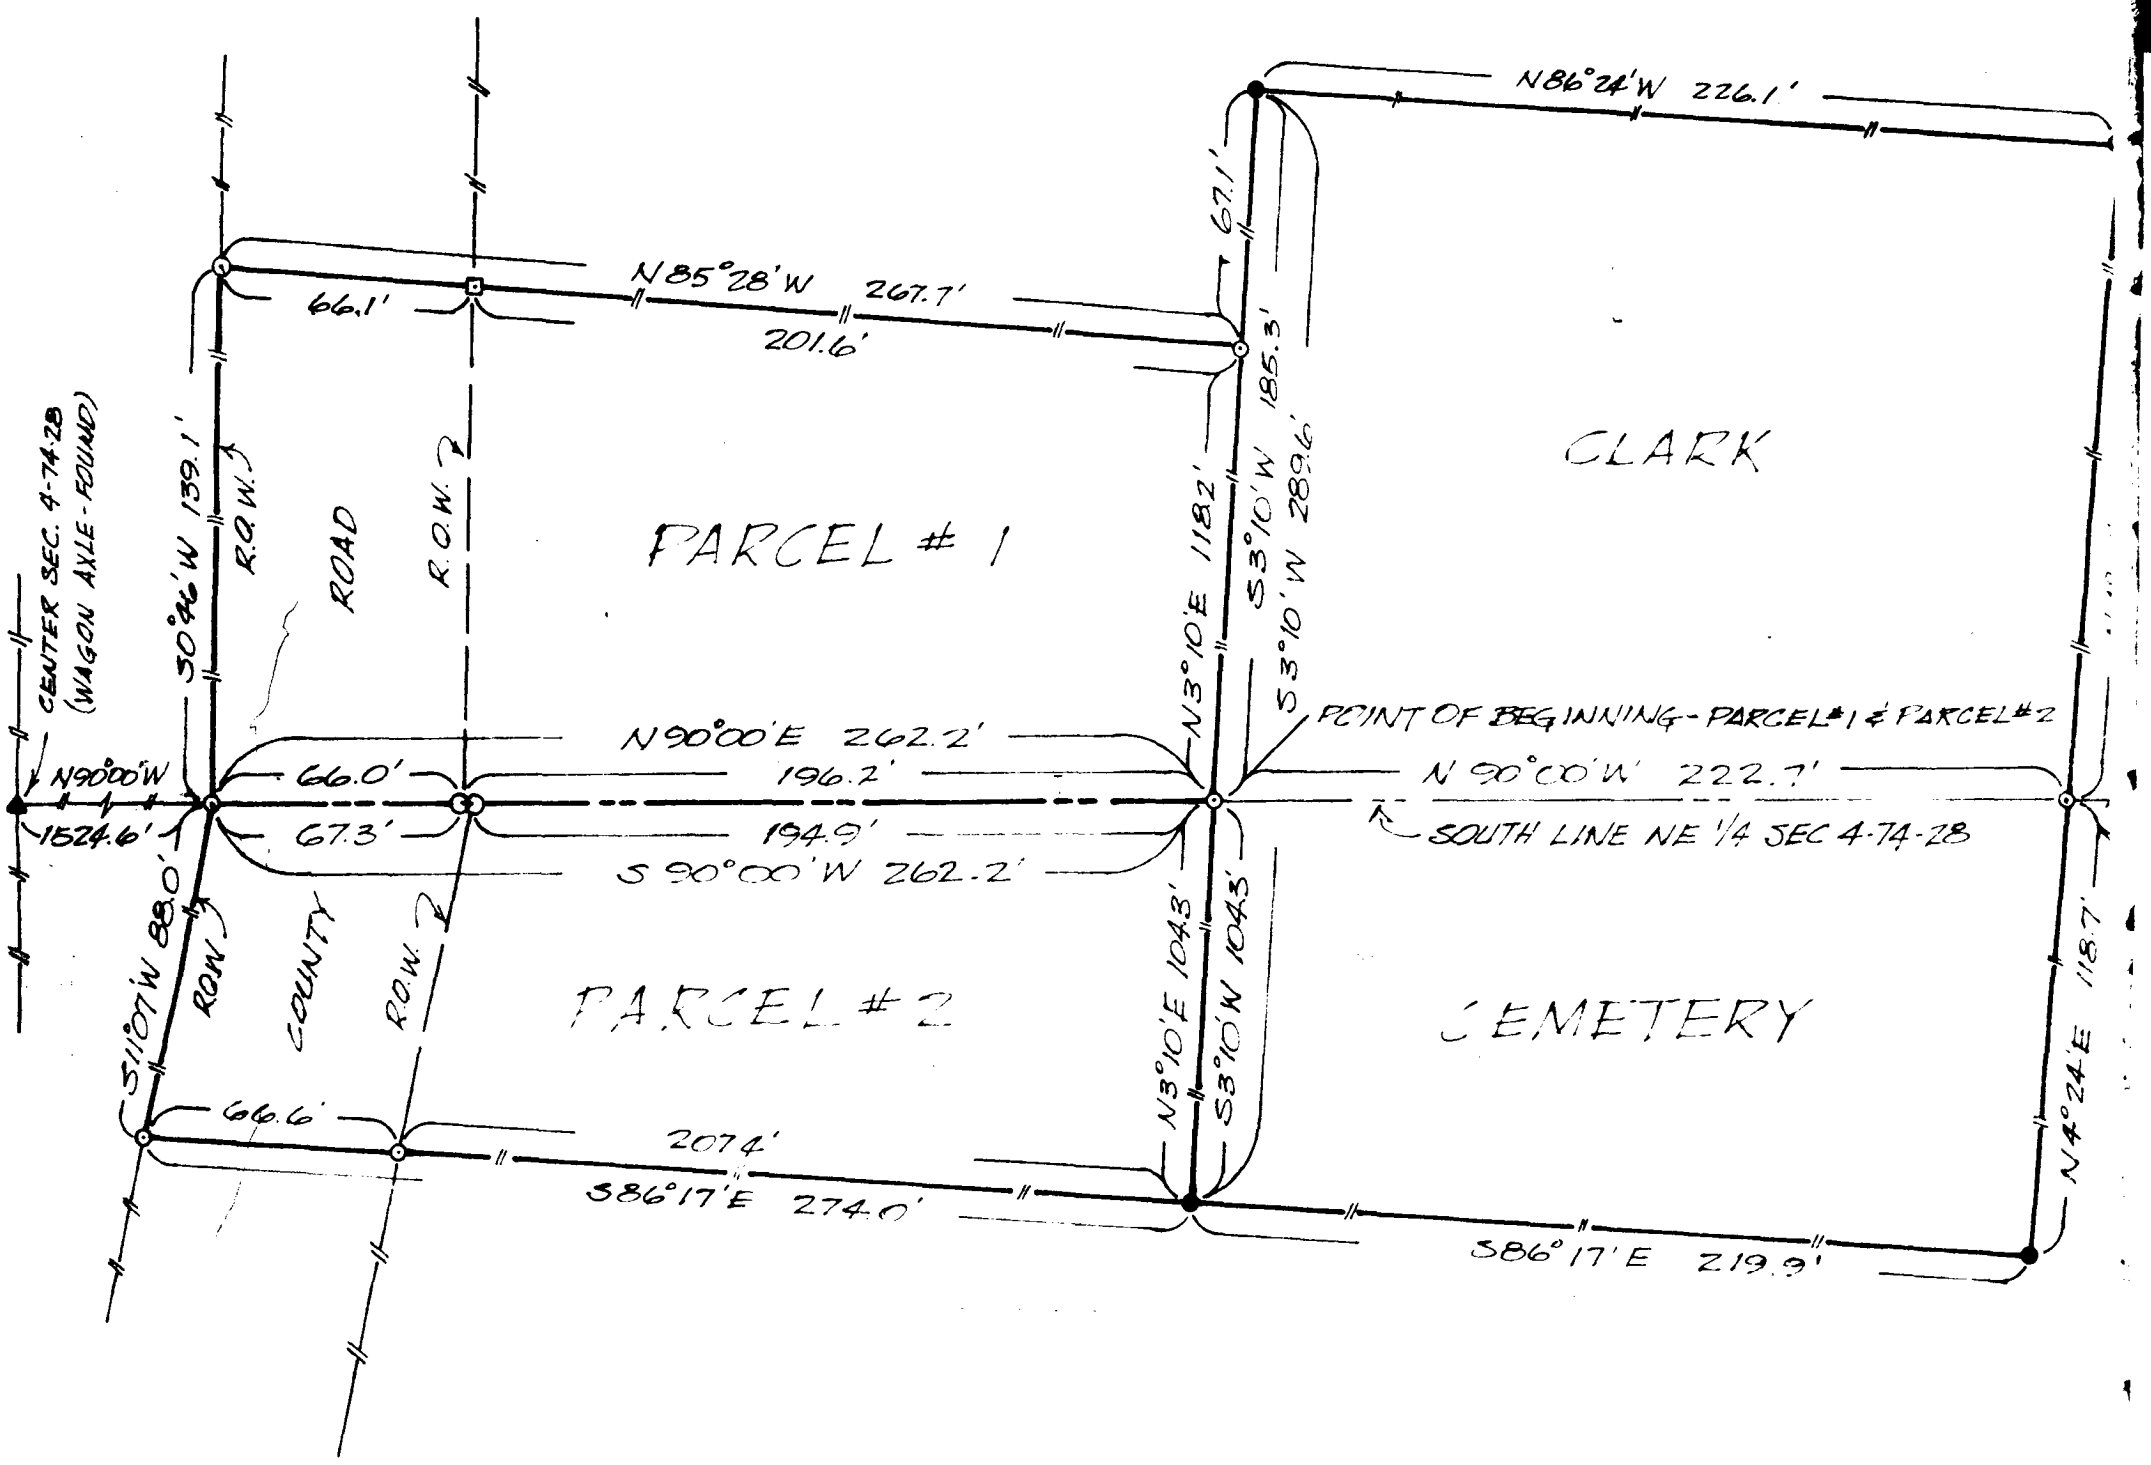

LEGEND

- ▲ SECTION CORNER - FOUND
- ● IRON CORNER POST - FOUND
- ⊡ 60d SPIKE - SET
- ⊙ ½" ϕ x 30" REBAR W/ CAP - SET
- — - - — SECTIONAL LINE
- ═══ PROPERTY LINE - SURVEY
- —//—//— FENCE
- — — — RIGHT OF WAY LINE (R.O.W.)


NOTE: ALL DIMENSIONS SHOWN ARE MEASURED DIMENSIONS.

NORTH
SCALE: 1"=50'

Survey completed April 1, 1980.

I, Tedde R. Blunck, Registered Professional Engineer and Land Surveyor in the State of Iowa, hereby certify that I personally supervised a land survey which was made at the request of the Monroe Township Trustees, Madison County, Iowa, and that I personally prepared this plat and these property descriptions from the field notes of said survey.

Signed _____ Dated Apr. 14, 1980
Tedde R. Blunck PE & LS — Iowa Registration Number 7044

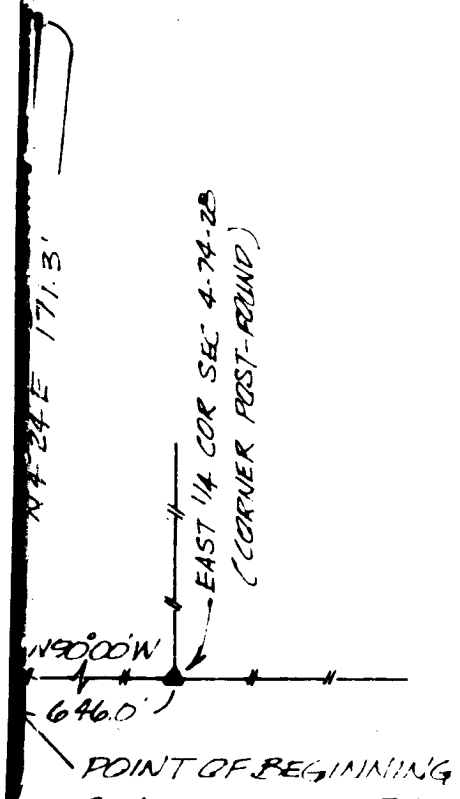

Clark Cemetery

A tract of land located in the East half of Section 4, Township 74 North, Range 28 West of the Fifth Principal Meridian, Monroe Township, Madison County, Iowa, the boundaries of which are identified as shown on the plat of a survey of the same by Tedde R. Blunck, PE&LS, dated April 1, 1980, more particularly described as follows:

Commencing as a point of reference at the East quarter corner of said Section 4;

thence North 90° 00' West 646.0 feet along the South line of the Northeast quarter of said Section 4 to the point of beginning (this is an assumed bearing for purposes of this description only);

thence North 4°24' East 171.3 feet;

thence North 86° 24' West 226.1 feet;

thence South 3° 10' West 289.6 feet;

thence South 86° 17' East 219.9 feet;

thence North 4° 24' East 118.7 feet to the point of beginning;

and subject to encumbrances of record,

and containing 1.5 acres more or less.

FILED NO. 1717
BOOK 1 PAGE 152
plat
1980 APR -8 PM 3:59
MARY E. WELTY
RECORDER
MADISON COUNTY, IOWA
no fee
filed by
Prop. Trustee

Clark Cemetery Addition - Parcel 1

A tract of land located in the Northeast quarter of Section 4, Township 74 North, Range 28 West of the Fifth Principal Meridian, Monroe Township, Madison County, Iowa, the boundaries of which are identified as shown on the plat of a survey of the same by Tedde R. Blunck, P.E.& L.S. dated April 1, 1980, more particularly described as follows:

Commencing as a point of reference at the East quarter corner of said Section 4;

thence North 90° 00' West 868.7 feet along the South line of said Northeast quarter of Section 4 to the point of beginning (this is an assumed bearing for purposes of this description only);

thence North 3° 10' East 118.2 feet;

thence North 85° 28' West 267.7 feet to a point of intersection with the Westerly right of way line of county road;

thence South 0° 46' West 139.1 feet along said Westerly right of way line of county road to a point of intersection with said South line of the Northeast quarter of Section 4;

thence North 90° 00' East 262.2 feet along said South line of the Northeast quarter of Section 4 to the point of beginning;

and subject to encumbrances of record,

and containing 0.8 acres more or less.

Clark Cemetery Addition - Parcel 2

A tract of land located in the Southeast quarter of Section 4, Township 74 North, Range 28 West of the Fifth Principal Meridian, Monroe Township, Madison County, Iowa, the boundaries of which are identified as shown on the plat of a survey of the same by Tedde R. Blunck, PE&LS, dated April 1, 1980, more particularly described as follows:

Commencing as a point of reference at the East quarter corner of said Section 4;

thence South 90° 00' West 868.7 feet along the North line of said Southeast quarter of Section 4 to the point of beginning (this is an assumed bearing for purposes of this description only);

thence continuing South 90° 00' West 262.2 feet along said North line of the Southeast quarter of Section 4 to a point of intersection with the Westerly right of way line of county road;

thence South 11°07' West 88.0 feet along said Westerly right of way line of county road;

thence South 86° 17' East 274.0 feet;

thence North 3° 10' East 104.3 feet to the point of beginning;

and subject to encumbrances of record.

and containing 0.6 acres more or less.