
Sec. No. 17 & 20, Township 75, Range 26.

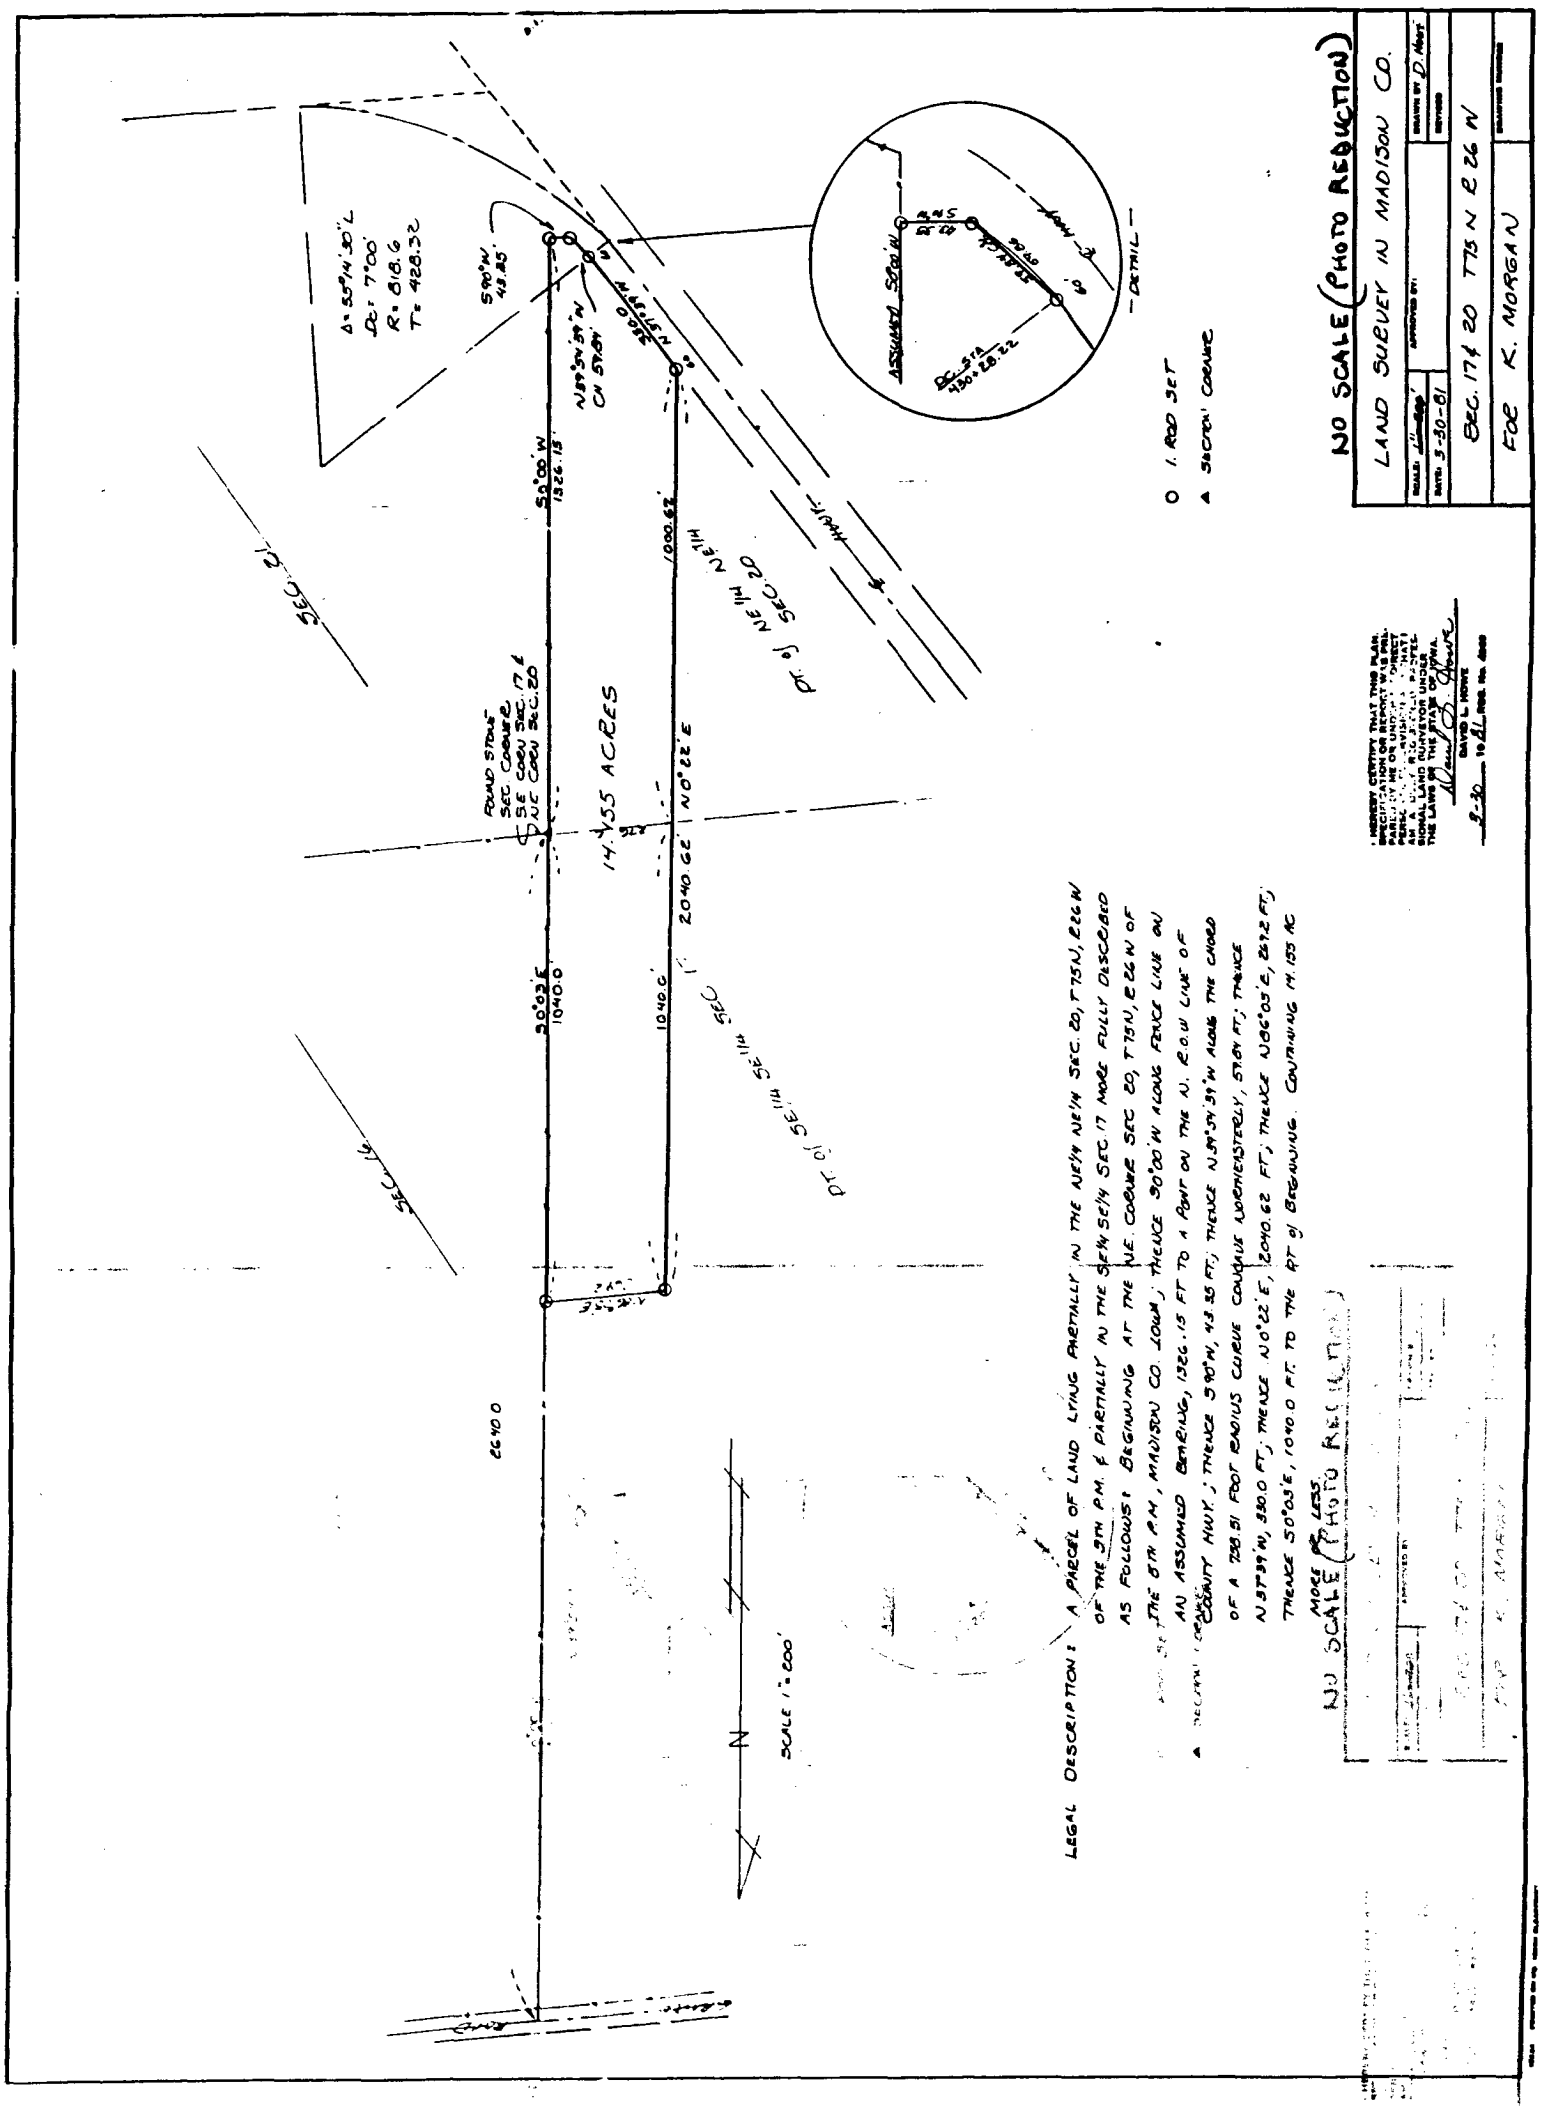

FILED NO. 1855 S
BOOK 1 PAGE 162
Farm Plat
1981 JUN -5 PM 3:34

MARY E. WELTY
RECORDER
MADISON COUNTY, IOWA