
Sec. No. 25 / 30, Township 77 / 77, Range 28 / 27.

FILED NO. 704
BOOK 1 PAGE 174
FARM PLAT
1982 NOV 23 AM 11:31

MARY E. WELTY
RECORDER
MADISON COUNTY, IOWA


PROJ. NO. FN-169-3(23)--21-61

(1) NW COR. NW1/4 NE1/4 SEC. 25-77-28W

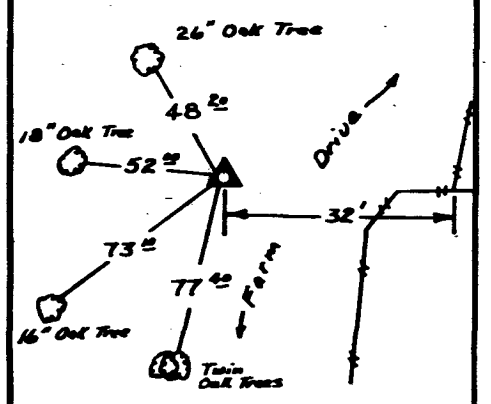


SET ALUMINUM MONU.

(2) NE COR. NW1/4 NE1/4 SEC. 25-77-28W

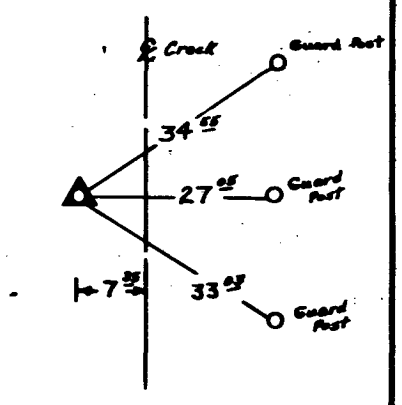


CUT "X" in SLAB

(3) NE CORNER SEC. 25-77-28W

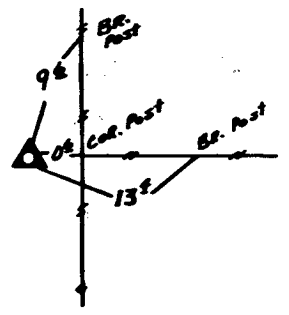


FOUND CONC. BLOCK OVER I.P.

(4) NW COR. SW1/4 NE1/4 SEC. 25-77-28W

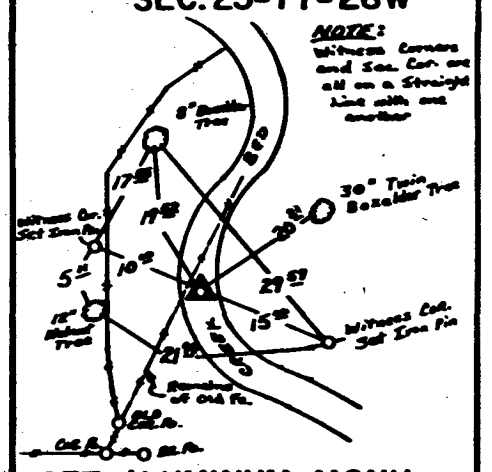


SET ALUMINUM MONU.

(5) NE COR. SE1/4 NE1/4 SEC. 25-77-28W

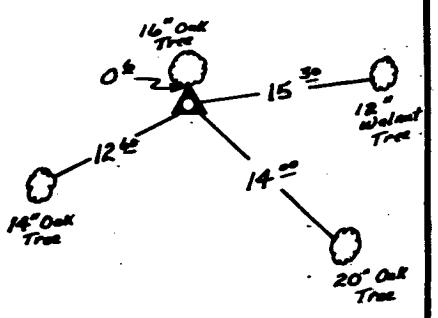


SET IRON PIN

(6) CENTER SEC. 25-77-28W

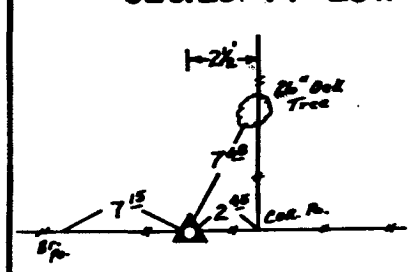


SET ALUMINUM MONU.

(10) S1/4 CORNER SEC. 25-77-28W

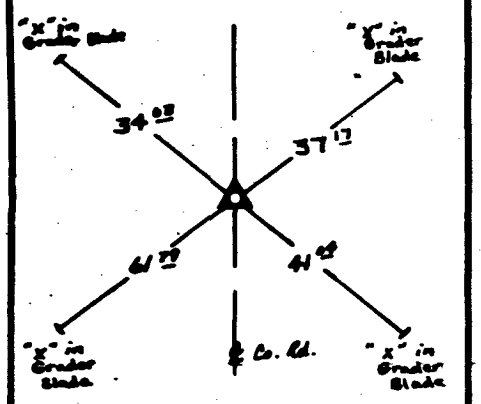


FOUND CAPPED IRON PIN

(11) SE CORNER SEC. 25-77-28W

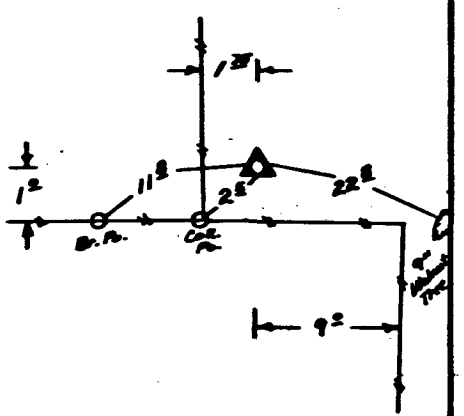

FOUND CONC. BLOCK OVER I.P.

(D)

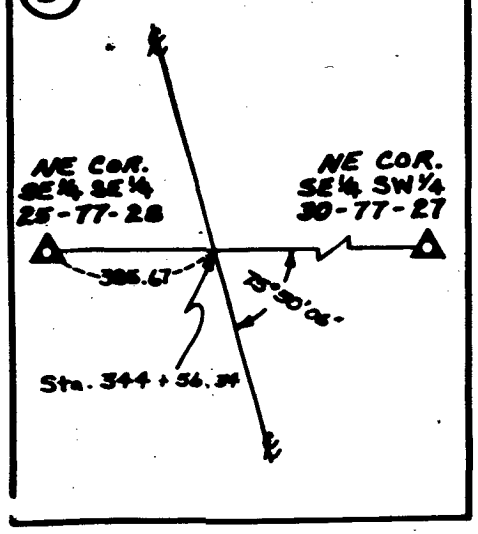

LAND CORNER SURVEY
MADISON COUNTY
PROJ. NO. FN-169-3(23)--21-61
T-77N R-28W

I HEREBY CERTIFY THAT THIS PLAT AND SURVEY WERE MADE BY ME OR UNDER MY DIRECT PERSONAL SUPERVISION AND THAT I AM A DULY REGISTERED LAND SURVEYOR UNDER THE LAWS OF THE STATE OF IOWA.

ASSISTED BY DENNIS L. MEYER, JAMES O. BERRY & MIKE J. JENSEN.

THIS PLAT COMPUTED FROM FIELD DATA OF 2nd ORDER MINIMUM ACCURACY.

REGISTERED LAND SURVEYOR LESLIE J. MAROUSEK 6263 IOWA

DATE: Oct 25, 1982

Leslie J. Marousek

LESLIE J. MAROUSEK R.L.S. NO. 6263

REGISTERED LAND SURVEYOR JAMES E. CAREY 6130 IOWA

DATE: Oct. 25, 1982

James E. Carey

JAMES E. CAREY R.L.S. NO. 6130

IRREGULAR SURVEY OF

NOTE.—Record Surveyor's Certificate in marginal lines, numbering each survey from 1 up, on each section.


Acres, Blackmar & Co., Makers, Burlington, Iowa.

MADISON COUNTY


T 77 N

R-28W

R-27W

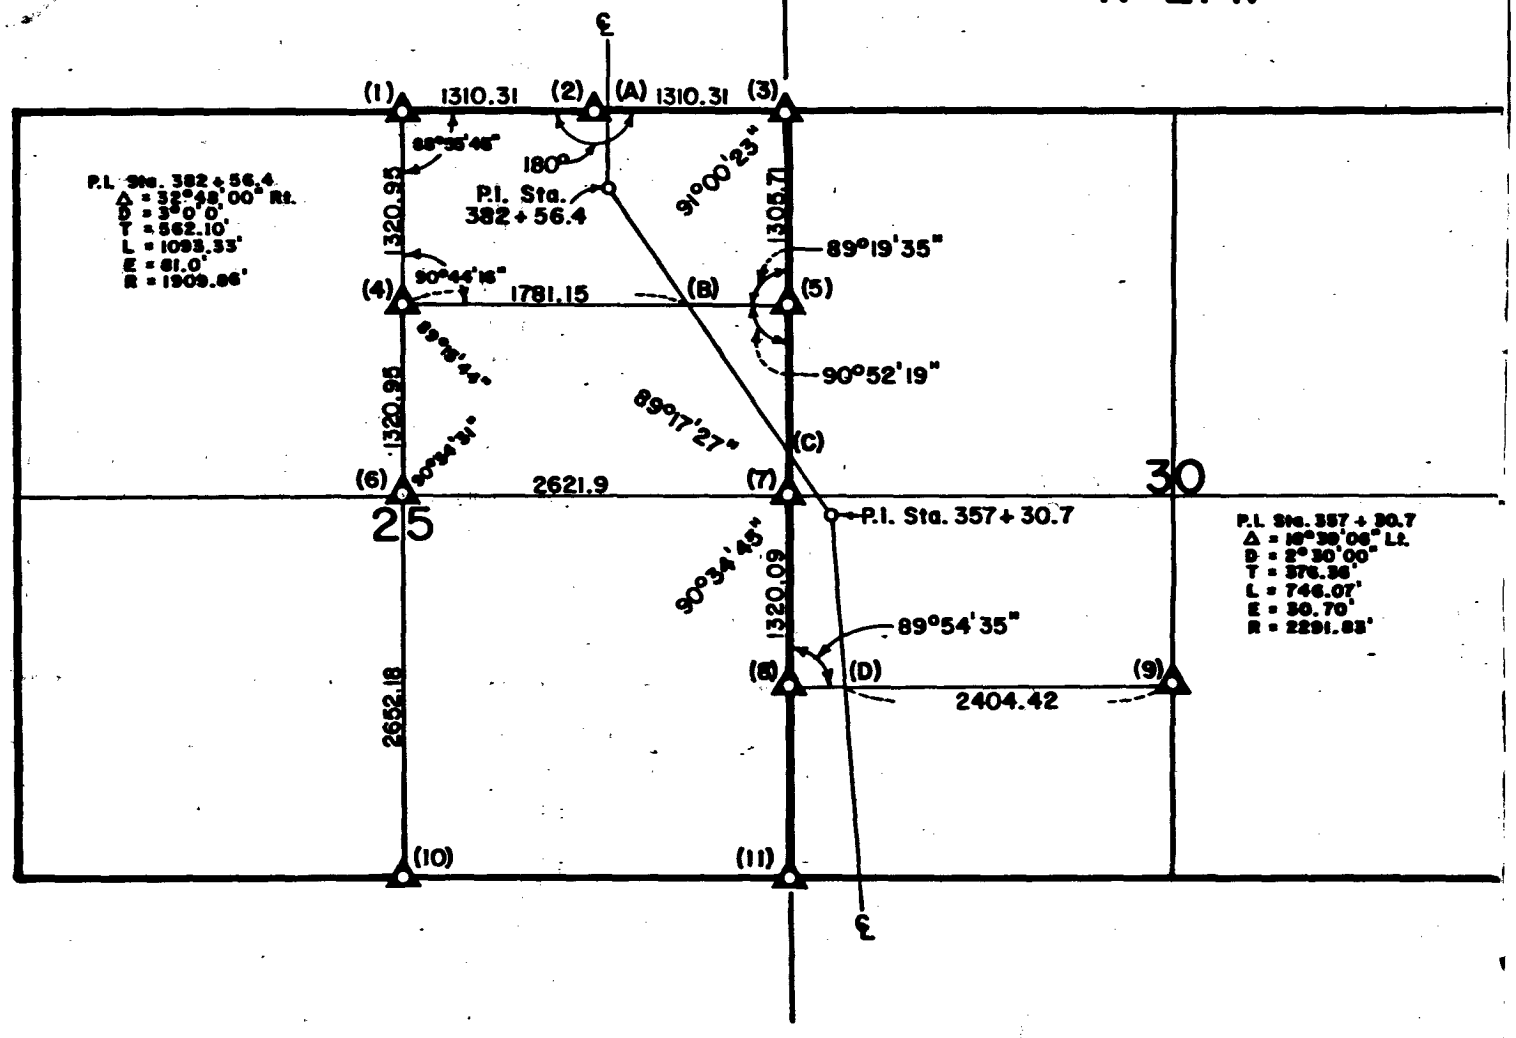


(7) E1/4 CORNER SEC.25-77-28W

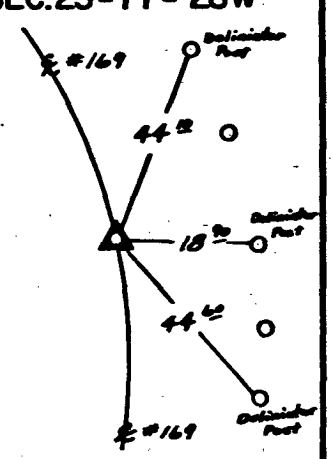


FOUND LEAD PLUG

(8) NE COR. SE1/4 SE1/4 SEC. 25-77-28W

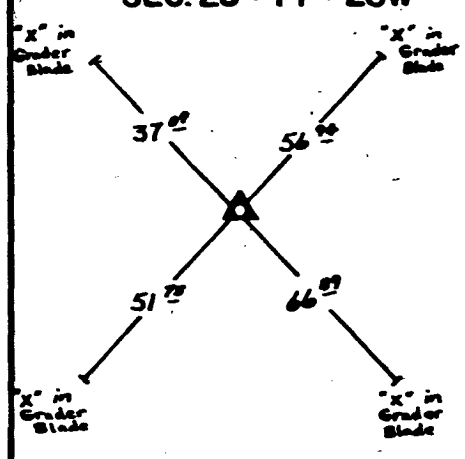


FOUND IRON PIN

(9) NE COR. SE1/4 SW1/4 SEC. 30-77-27W

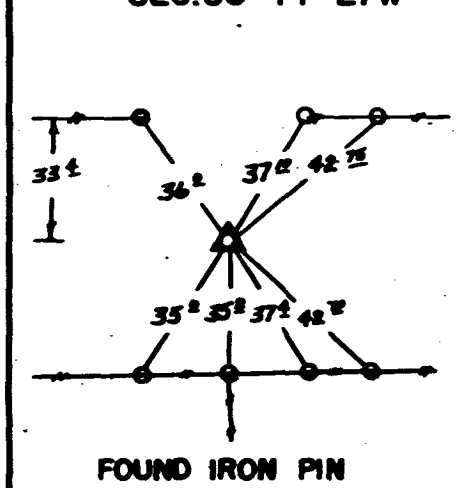


FOUND IRON PIN

(A)

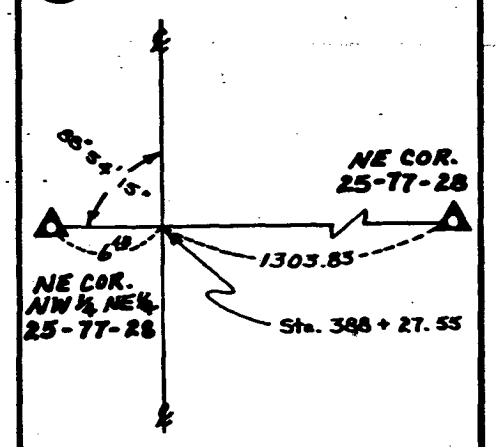

(B)

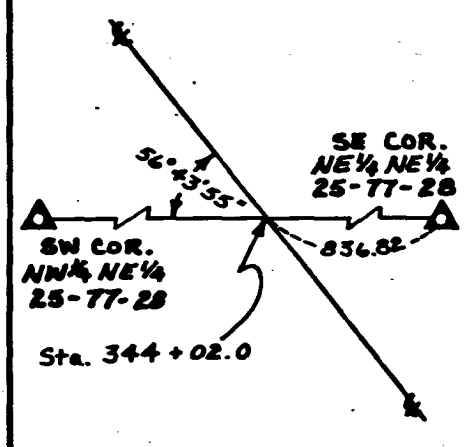

(C)

