Sec. No. 30, Township 76, Range 27.

PRIMITIVE BAPTIST CEMETERY SURVEY

A parcel of land located in the Southwest quarter of the Northeast quarter of Section 30, Township 76 North, Range 27 West of the Fifth Principal Meridian, Union Township, Madison County, Iowa, more particularly described as follows:

Beginning at the North quarter corner of said Section 30;

thence North 90° 00' East 654.4 feet along the North line of Northeast quarter of said Section 30 to a point of intersection with centerline of county road (this is an assumed bearing for purpose of this description only);

thence South 0° 10' East 1936.7 feet along the centerline of said county road;

thence South 42° 22' West 40.1 feet along the centerline of said county road;

thence South 0° 10' East 133.4 feet to the point of beginning;


thence continuing South 0° 10' East 244.6 feet;

thence South 89° 35' West 225.3 feet;

thence North 42° 22' East 333.3 feet to the point of beginning;

and subject to encumbrances of record,

and containing 0.63 acres more or less.

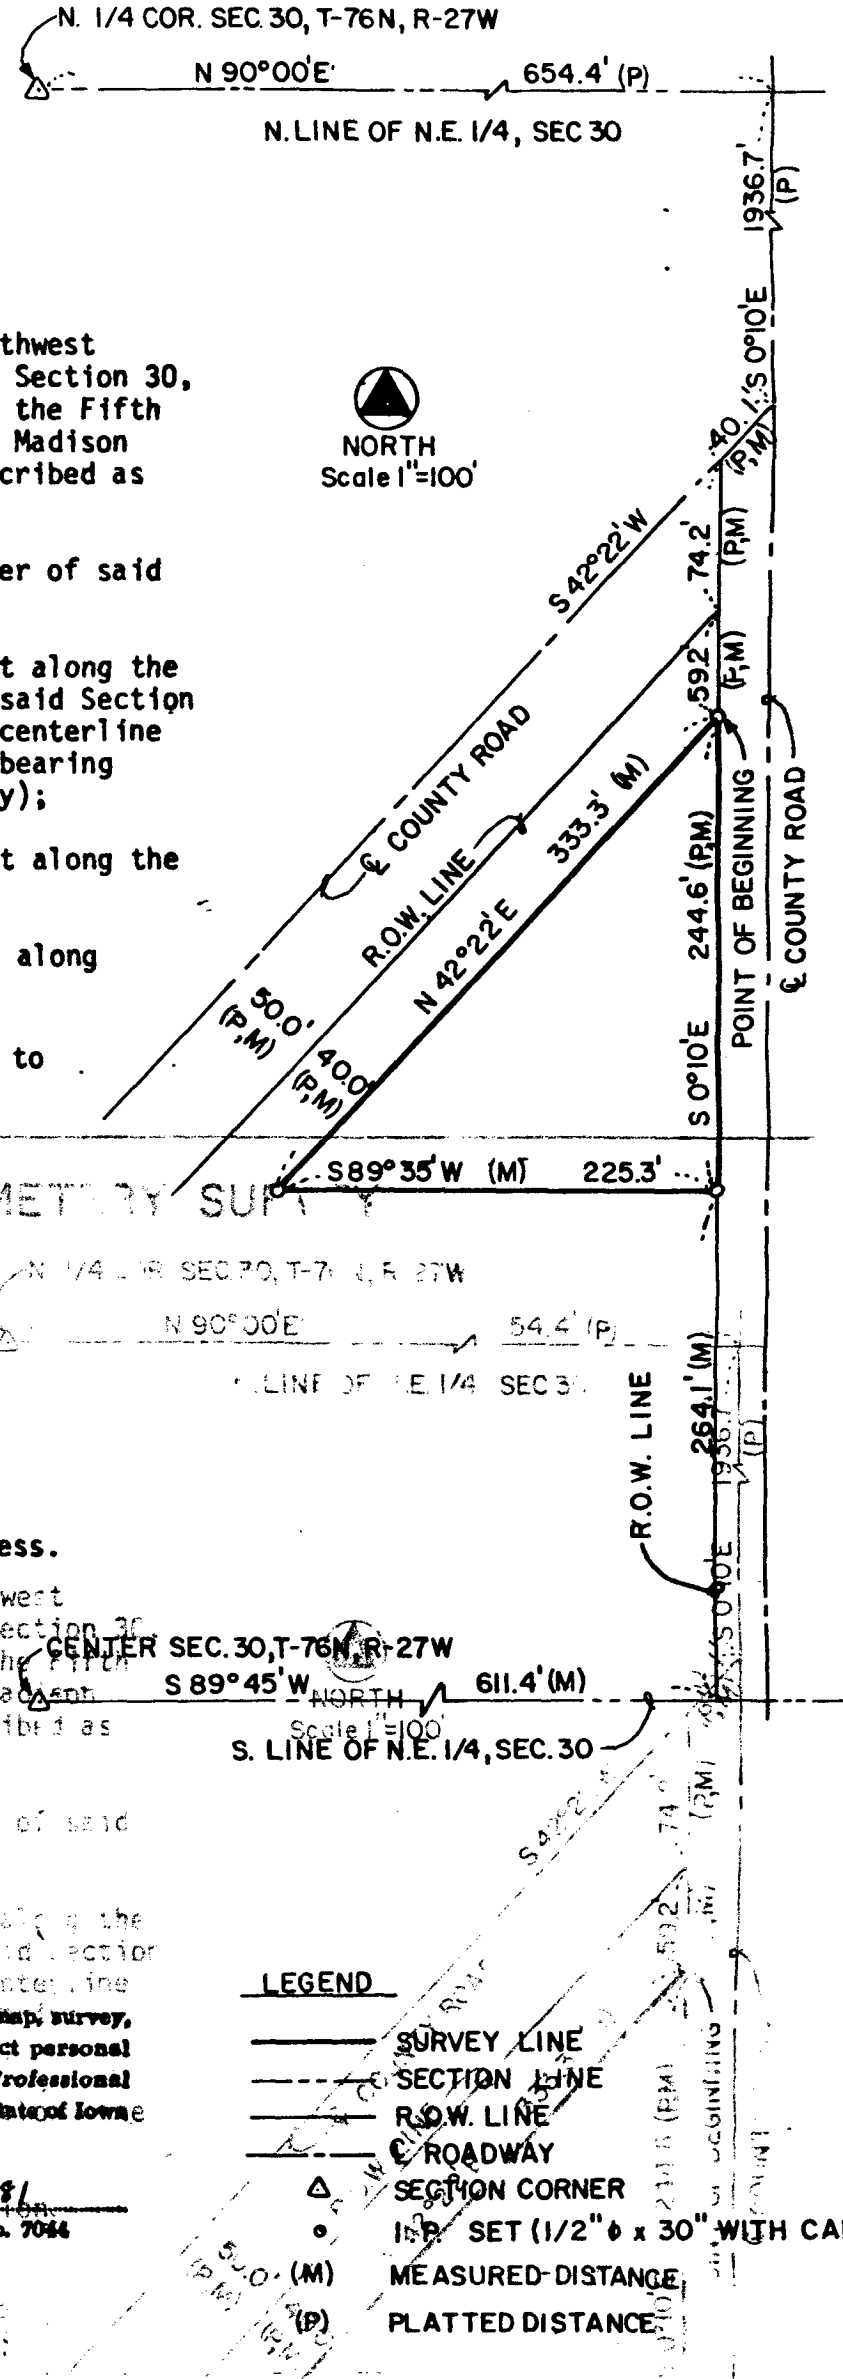

LEGEND

- SURVEY LINE
- SECTION LINE
- R.O.W. LINE
- ℄ ROADWAY
- △ SECTION CORNER
- ○ I.P. SET (1/2" ϕ x 30" WITH CAP)
- (M) MEASURED DISTANCE
- (P) PLATTED DISTANCE

TEDD R. BLUNCK — REGISTERED — 7044 — IOWA — PROF. ENGR. & LAND SURVEYOR

I hereby certify that this plan, specification, plat, map, survey, or report was prepared by me or under my direct personal supervision and that I am a duly Registered Professional Engineer and Land Surveyor under the laws of the State of Iowa and that I am competent to prepare this document.

Signed _____ Date 6/12/82

Tedde R. Blunck, P.E. & L.S. Iowa Reg. No. 7044

STATE OF IOWA, MADISON COUNTY, ss: Inst. No. 1716 Filed for Record this 25 day of May 19 82 at 11:30 AM

Book 1 Pages 171-172 Recording Fee none Marie E. Welty, Recorder By _____ Deputy

Farm Plat