
192

PLAT OF SURVEY FOR IOWA REALTY
IN THE S1/2 OF SECTION 14, T75N, R2
OF THE 5TH P.M., MADISON COUNTY, IO

REDUCED

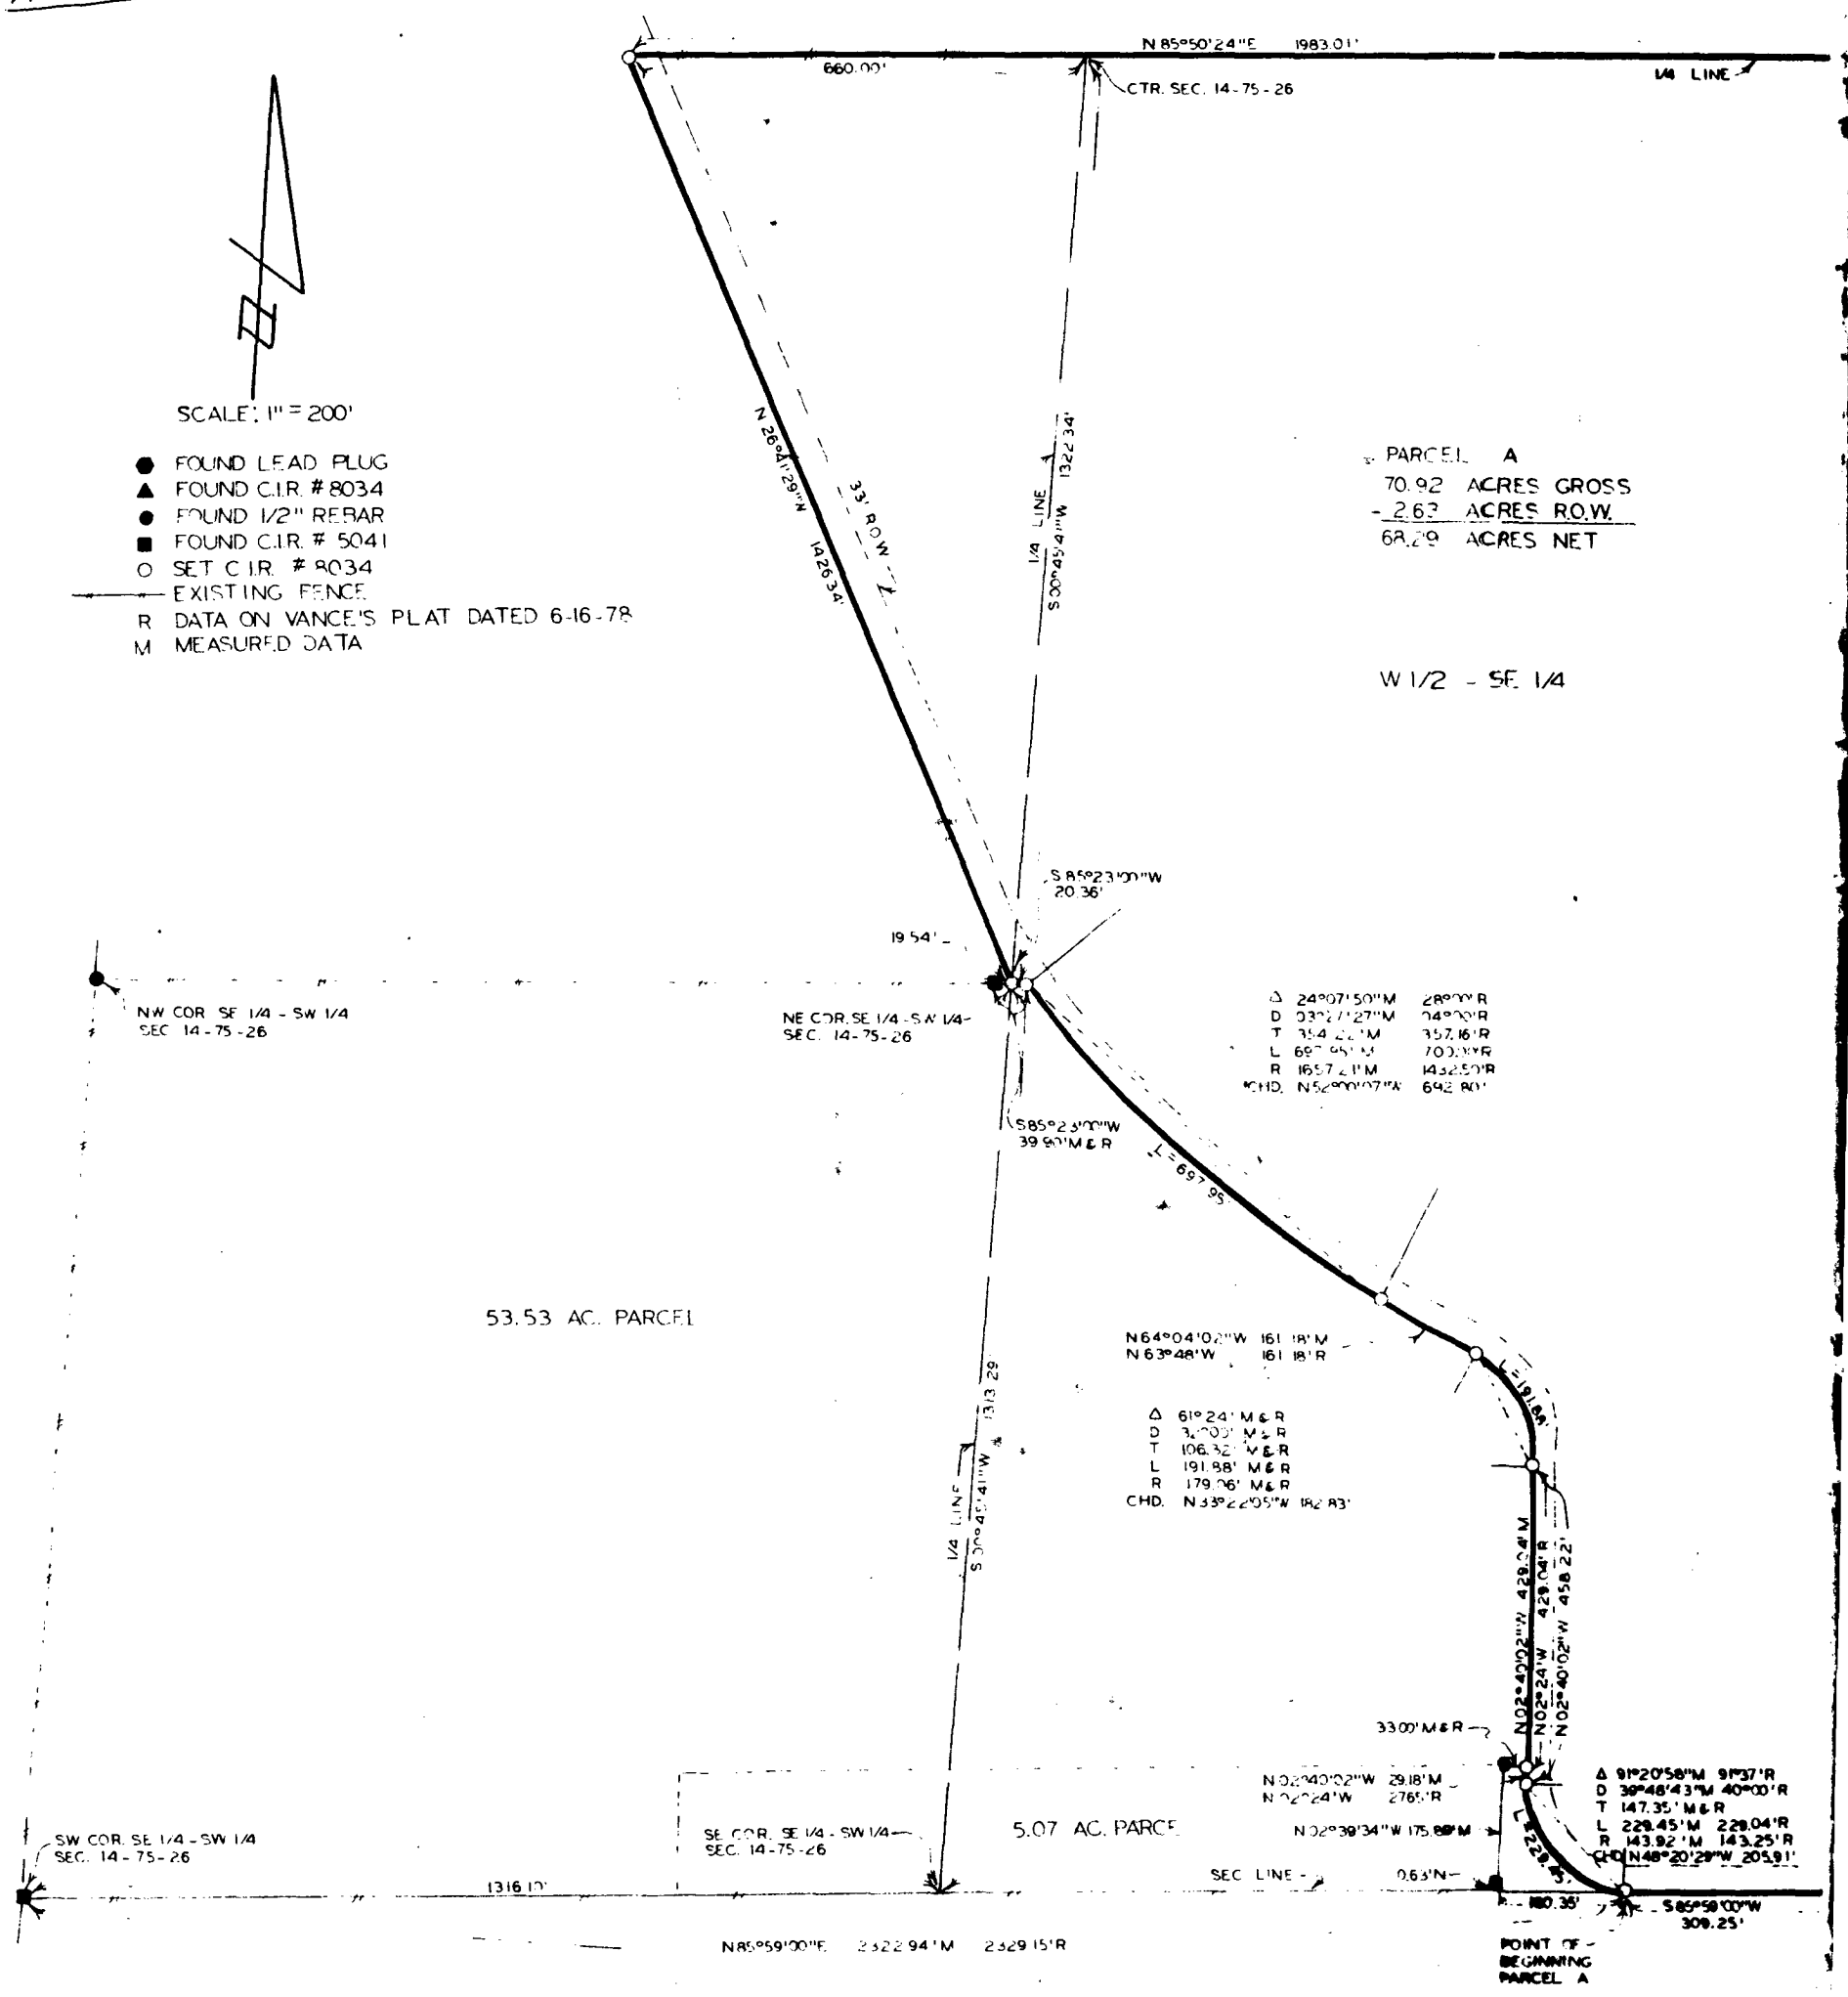







Range 14-75-26

FILED NO. 1776
BOOK 1 PAGE 192
FARM PLAT
1984 APR -4 PM 1:49

MARY E. WELTY
RECORDER
MADISON COUNTY, IOWA

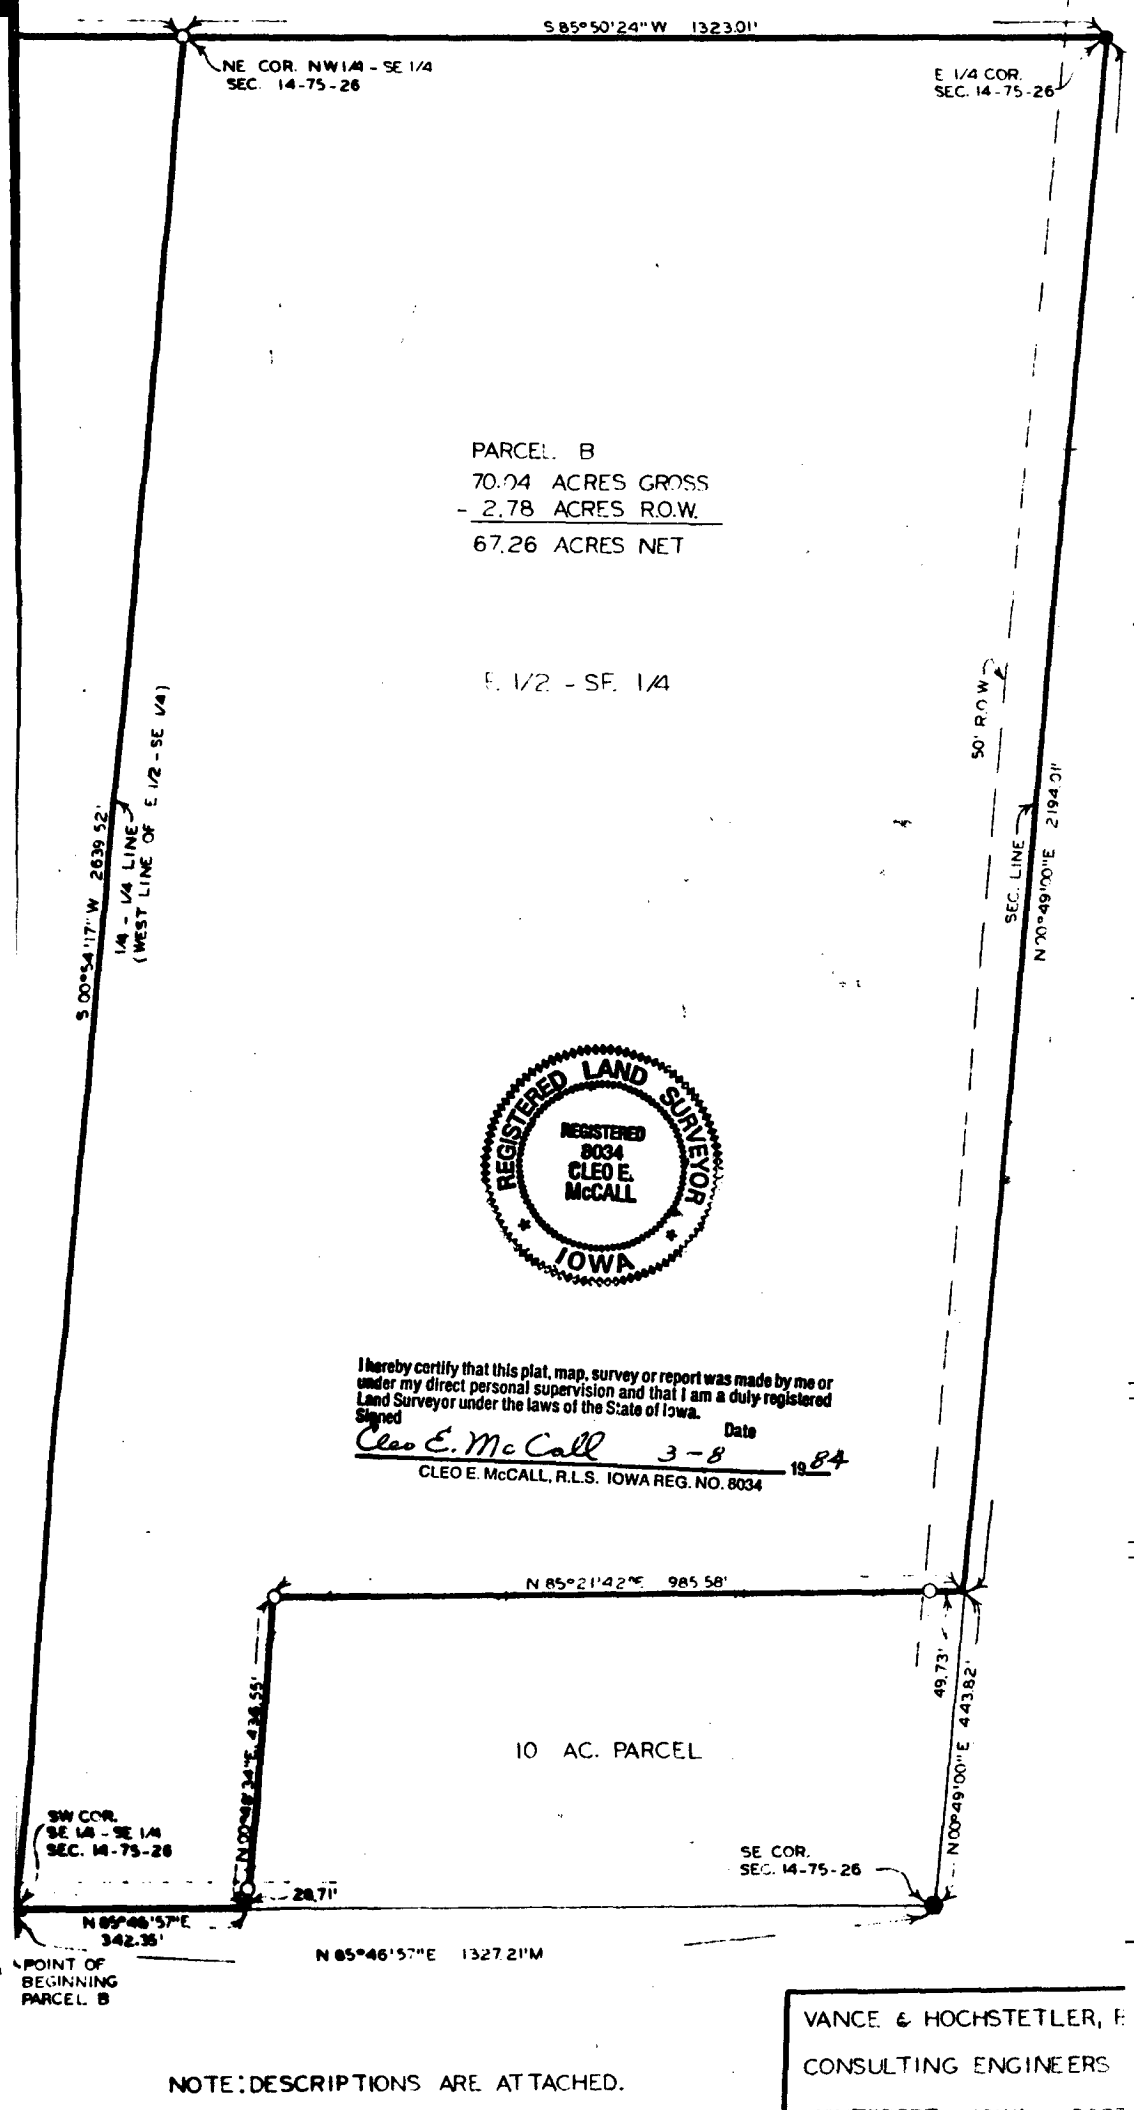

NOTE: DESCRIPTIONS ARE ATTACHED.

VANCE & HOCHSTETLER, P
CONSULTING ENGINEERS
WINTERSET, IOWA 502





