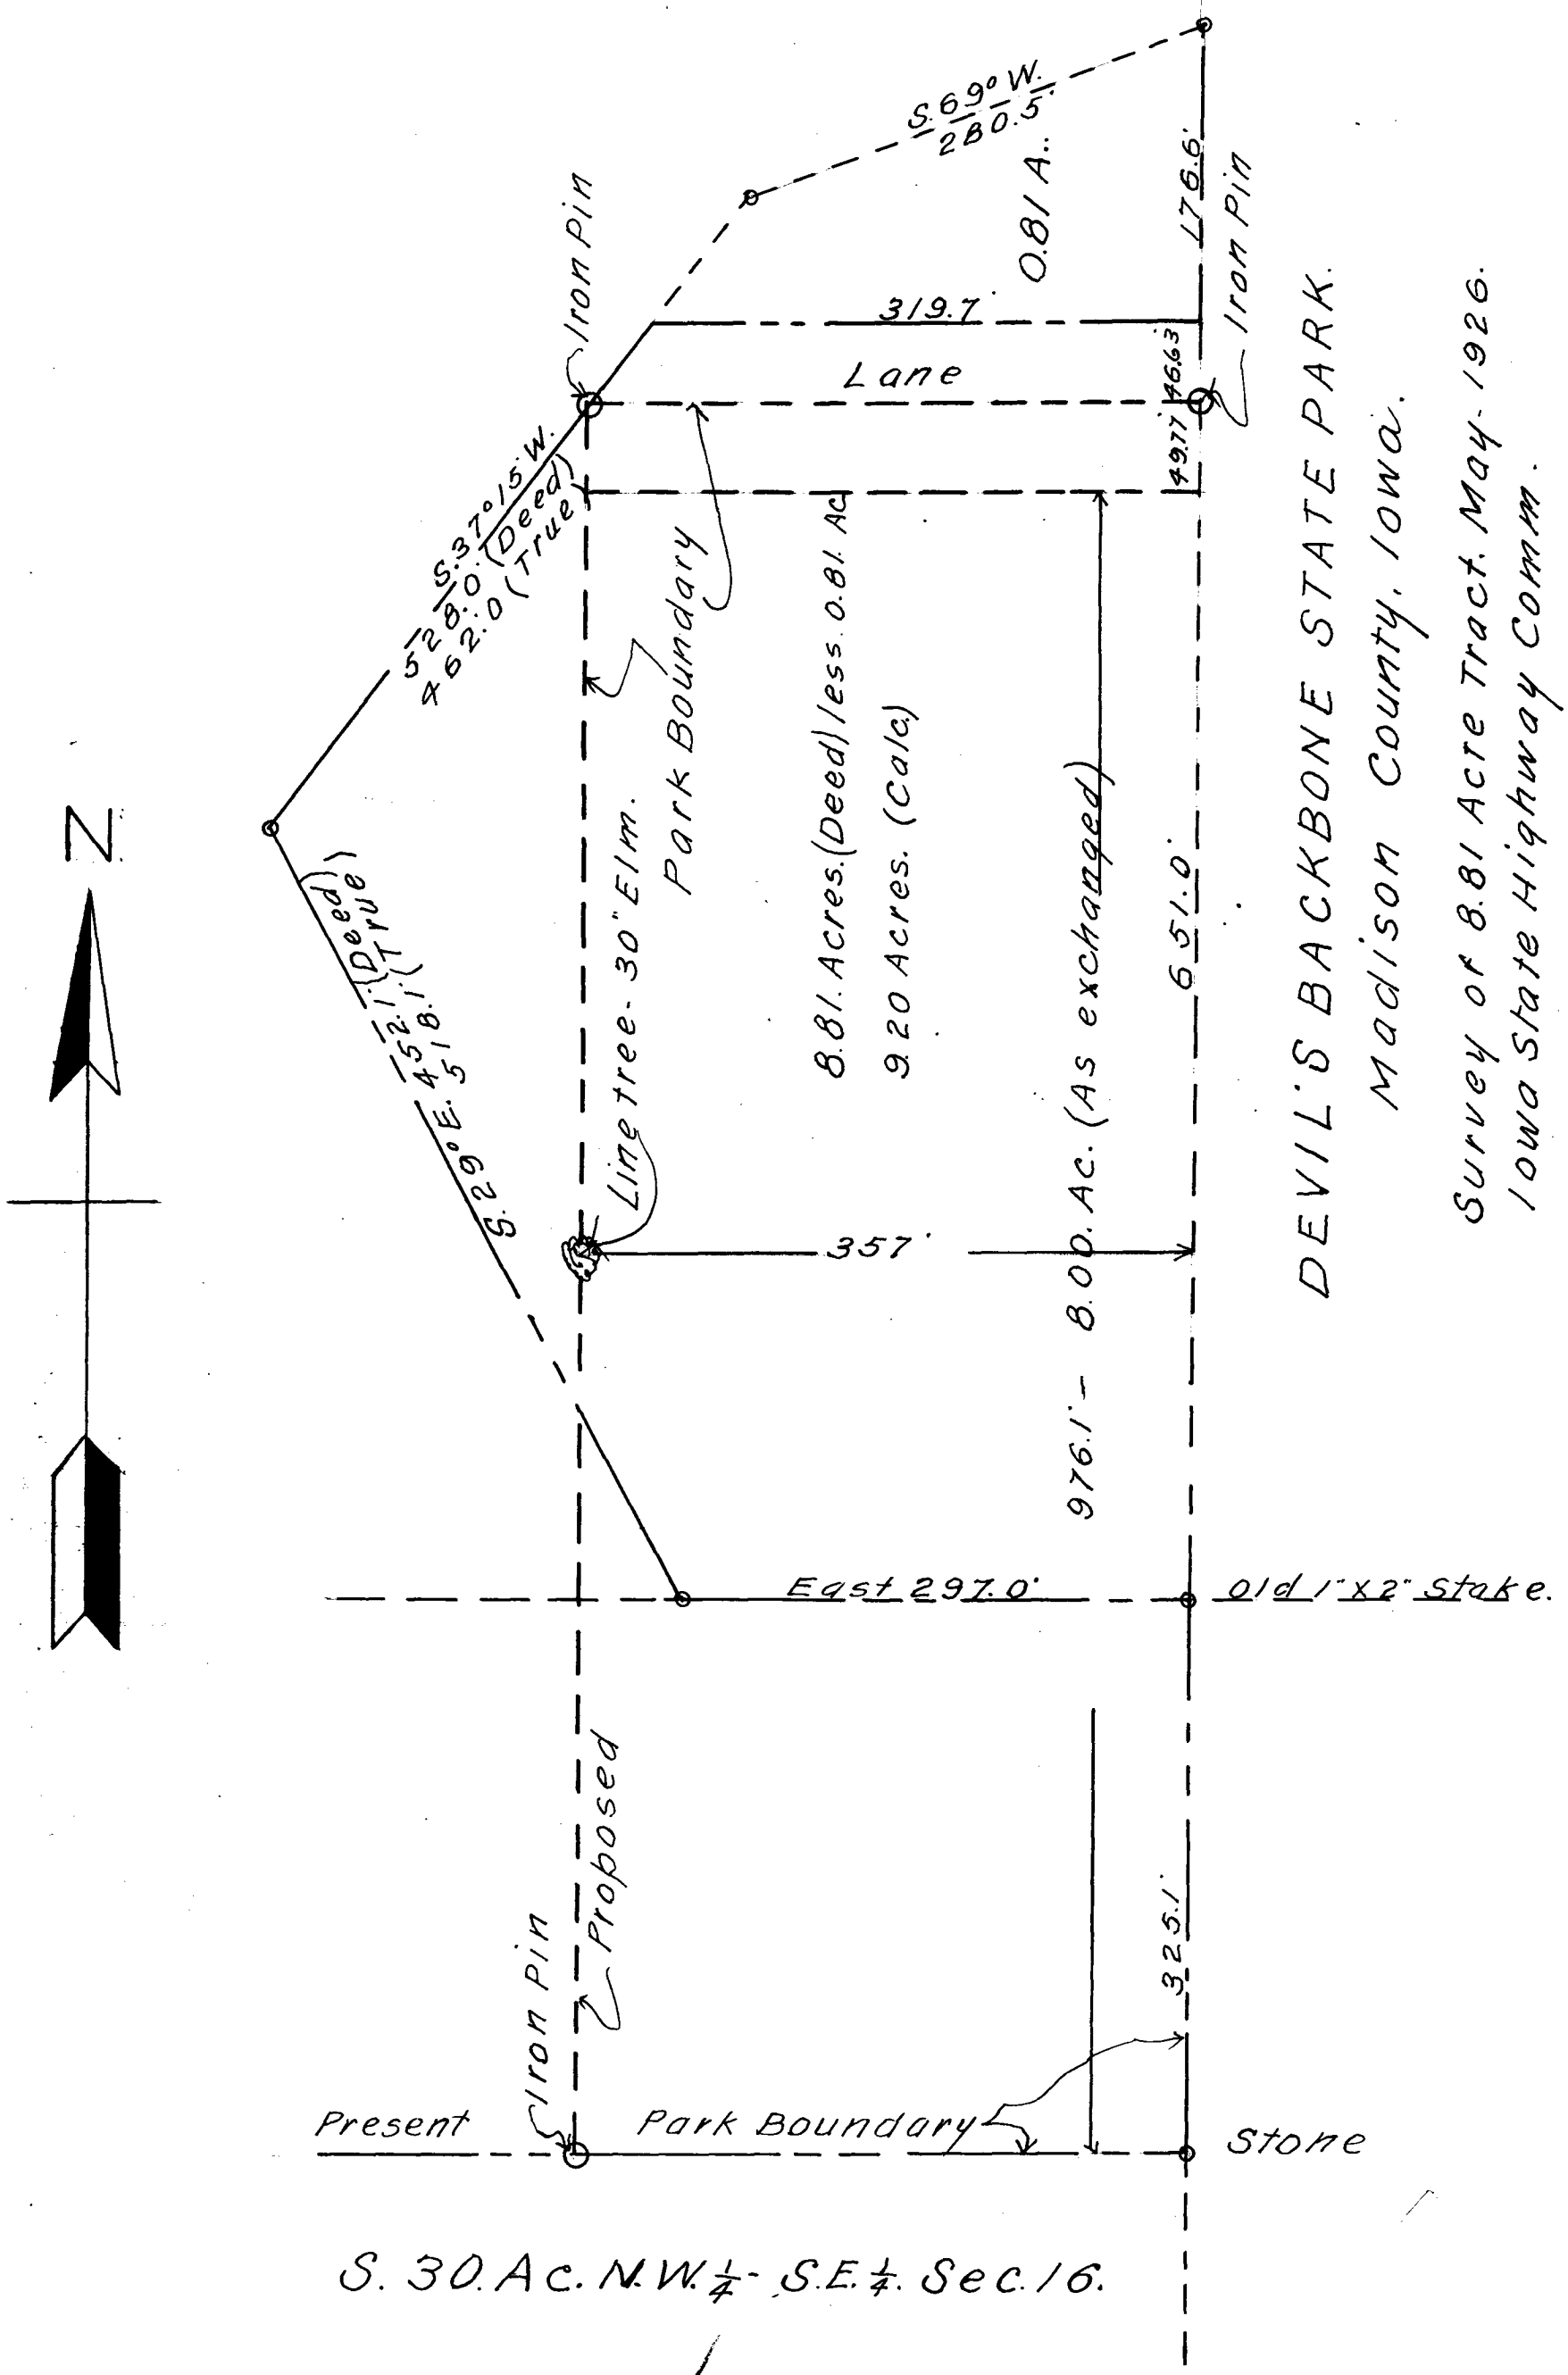


S. 30 Ac. N.W. 1/4 - S.E. 1/4. Sec. 16.

✓

#2676
Filed for record this 28th day of December, A.D. 1927, at 11:50 o'clock A.M.
Gladys B. DeVault Recorder,
By Excell M. Knott Deputy.