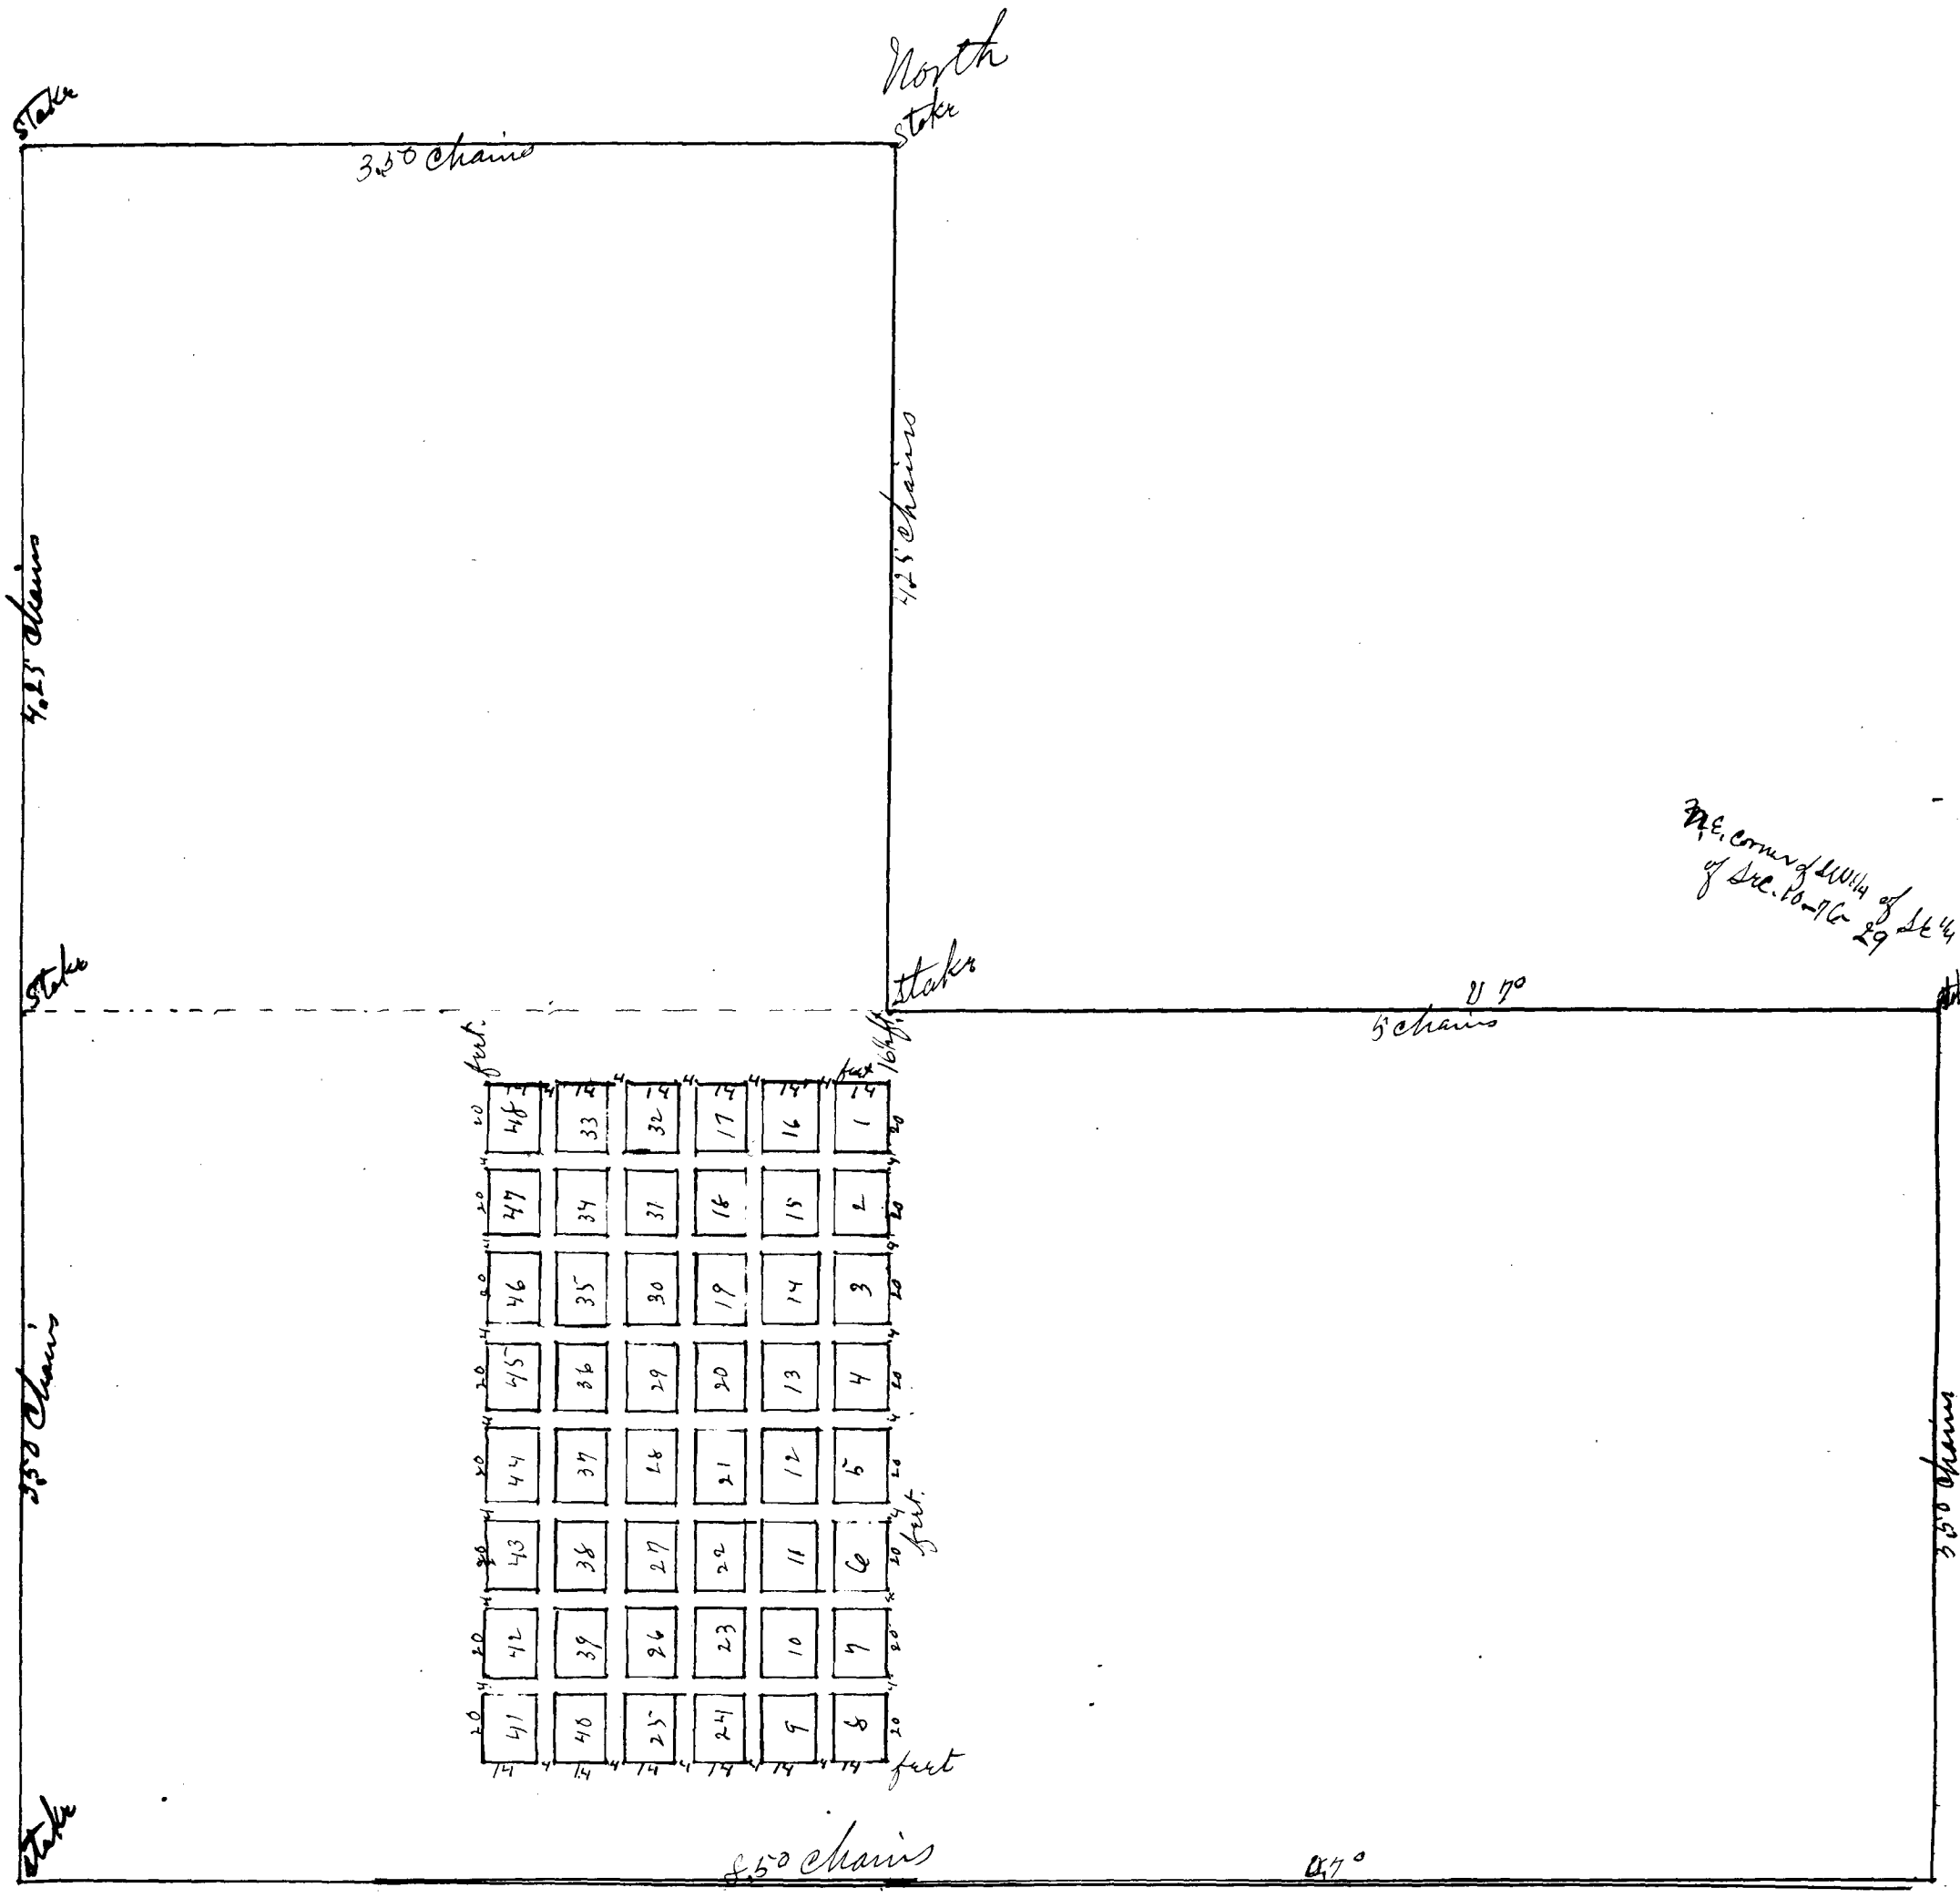


I hereby certify that the above plat is correct of a cemetery surveyed by me on the 25 day of May 1894 and is located as follows. Beginning at the NE corner of the SW¼ of the SE¼ of Section No. 10 in Township 7G North, Range 29 West of the 6th Principal Meridian, Thence West 5 chains, Thence North 4 25/100 chains, Thence West 3.50 chains, Thence South 7.75 chains Thence East 8.50 Chains, Thence North 3.50 chains to place of beginning.

A part of the ground beginning 5 chains West and 16½ feet South of the place of beginning the survey is laid off into lots. The space occupied by lots extending 188 feet South and 184 feet West. The lots are each 20 feet long North and South and 14' wide East and West with alleys 4 feet wide both North & South and East & West between them. There are 48 lots numbered in the order given in the plat above.

K. A Patterson
Co. Surveyor.

Filed for record July 21st A.D. 1904 at 9 45/100 o'clock A.M.

A. W. Vance
Recorder

#2445 - Eppard Cemetery -