

PLAT NO. 6


MADISON & DALLAS COUNTIES I-IG-01-2(6)


259


#2963 Filed for record on August 28, 1957 at 11:30 A.M. Recorded in book 1 on page 259. Mary E. Welty, Recorder

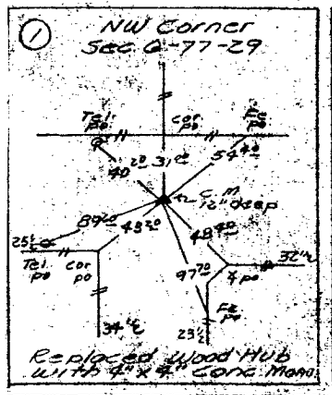


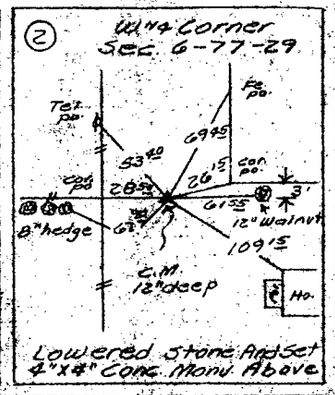


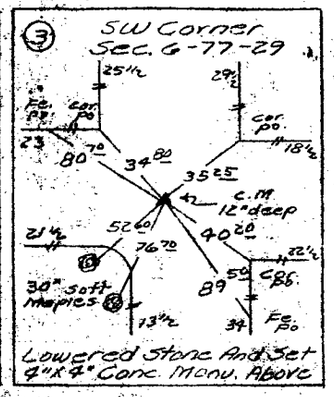

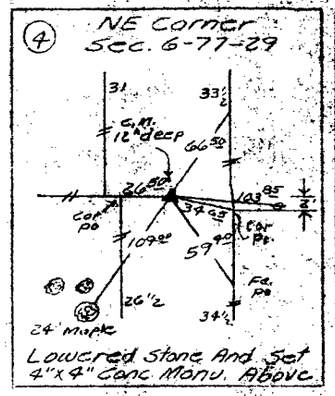

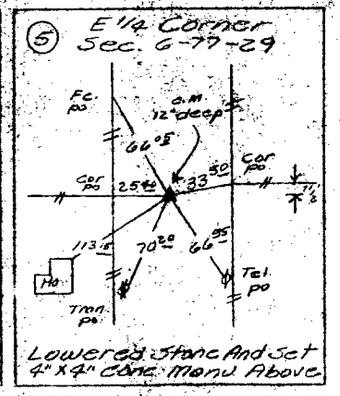

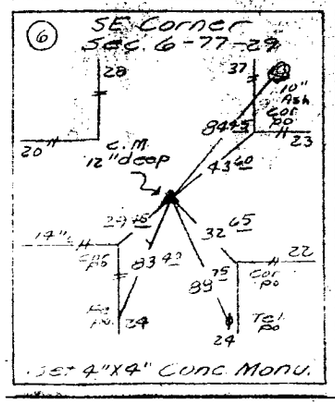

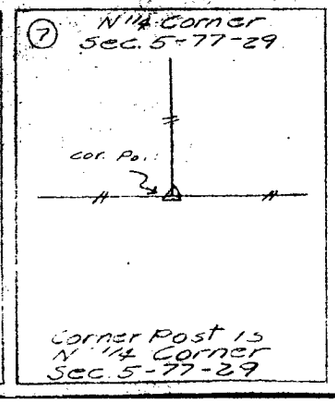

2963
STATE OF IOWA
MADISON COUNTY
Filed for record the 28 day of August
A.D. 19 57 at 11:30 o'clock A M.
Recorded in book 1 page 259
Mary E. Welty Recorder

LAND CORNER SURVEY

MADISON & DALLAS COUNTIES
PROJ NO. I-IG-01-2(6)
T-77N & T-78N R-29W.

MADE FOR

IOWA STATE HIGHWAY COMMISSION

FOR PURPOSE OF R.O.W. DESCRIPTION ON PROPOSED INTERSTATE HIGHWAY (US 6) IN MADISON AND DALLAS COUNTIES

BY

D.A. SPARKS R.L.S. NO. 3436

JULY 1957

All distances were measured carefully and may not agree with road survey stationing. For complete information on this survey see field notes filed in Ames office

I hereby certify that this plat is a true representation of a survey made by me assisted by M.L. Miller, G.D. Needham, D.E. Houston, J.W. Peterson, and Wm. J. Staebler all duly sworn, and is correct to the best of my knowledge.

Signed: August 15, 1957

D. A. Sparks

D.A. Sparks R.L.S. No. 3436

