MADISON COUNTY

F-1067

260

R-26W.

R-25W.

CO. CO.

(1) (2) (3) (4) (5) (6) (7) (8) (A)

2697.53

2664.93

83° 59½' to CO.

Cor. is 29 56' Lt. of Sta. 57+47 62

Cor. is 28 49 Rt. of Sta. 84+46 13

1319.3'

1313.9'

TOWN OF ST. CHARLES

Cor. is 66 30' Lt. of Sta 13+07 43

Cor. is 72 25' Rt. of Sta. 0+00 89

T 75 N

24

19

US #69

SEE PLAT NO. 2 ON WARREN CO. PROJ. NO. IN-ING 853

R-26W.


R-25W.

MADISON


WARREN

Filed for record Oct. 7, 1957 at 1:00 P.M.
Recorded in book 1 on page 260
Mary E. Welty, Recorder


#3319

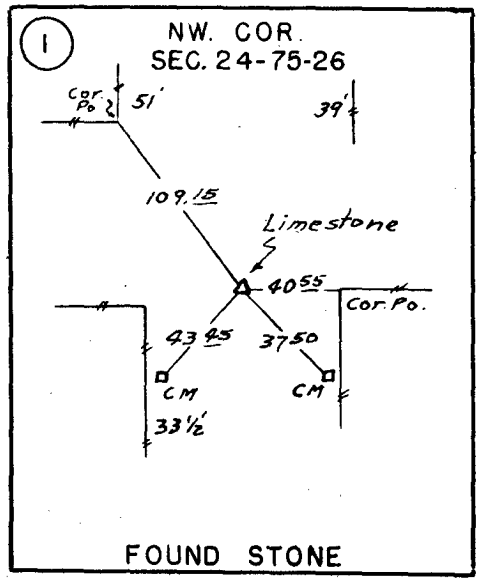


FOUND STONE

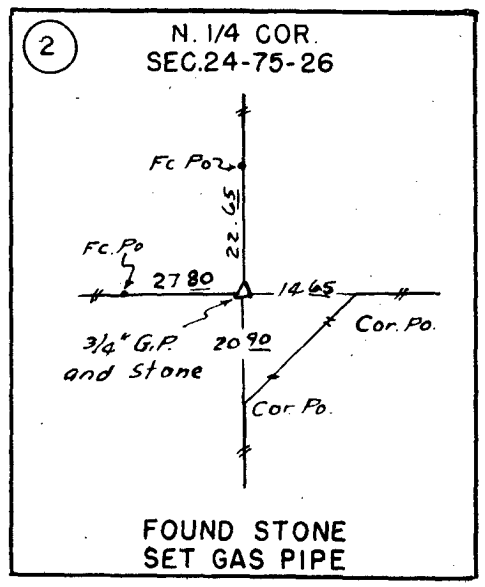


FOUND STONE
SET GAS PIPE

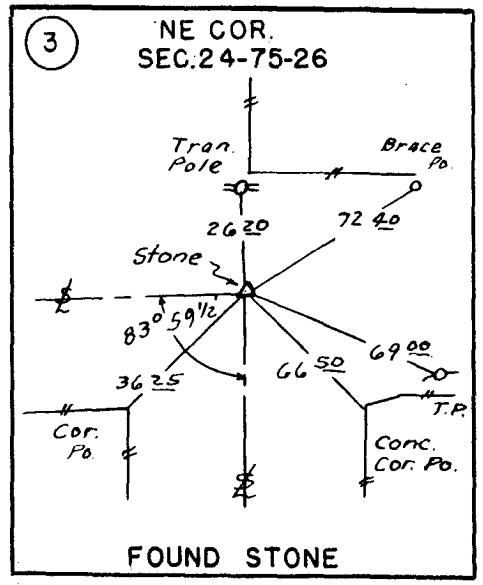


FOUND STONE

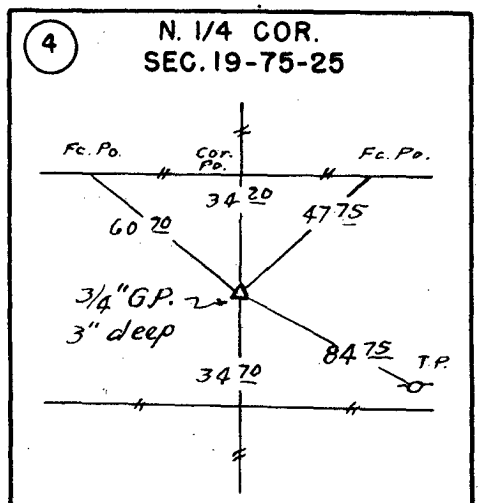


SET GAS PIPE

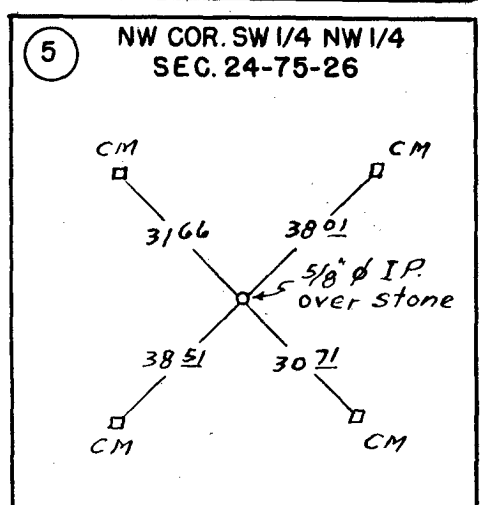


FOUND IRON PIN
OVER STONE

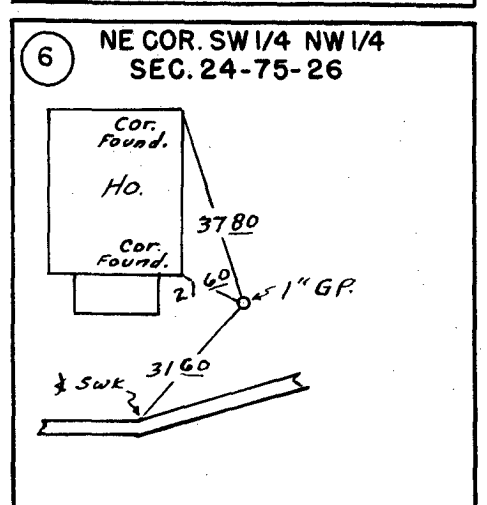


FOUND GAS PIPE

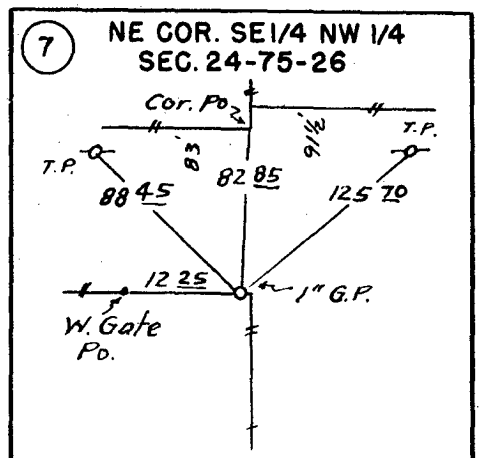

FOUND GAS PIPE

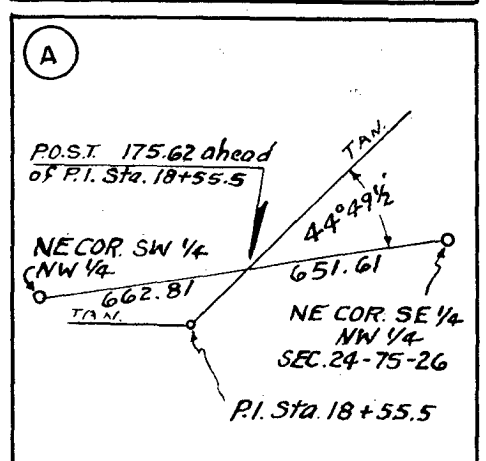

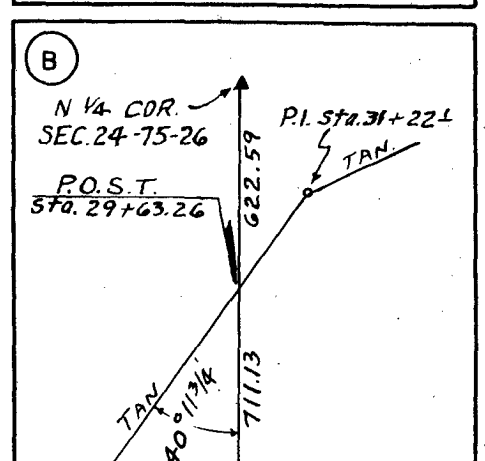

FOUND GAS PIPE

LAND CORNER SURVEY

MADISON COUNTY
PROJ. NO. F-1067
T-75N. R-26W.

MADE FOR
IOWA STATE HIGHWAY COMMISSION
FOR PURPOSE OF R.O.W. DESCRIPTION
ON ST. CHARLES STUB

BY
D. A. SPARKS R. L. S. NO. 3436
MARCH 1957

ALL DISTANCES WERE MEASURED CAREFULLY AND MAY NOT AGREE WITH ROAD SURVEY STATIONING

FOR COMPLETE INFORMATION ON THIS SURVEY SEE FIELD NOTES FILED IN AMES OFFICE.

CERTIFICATION

I HEREBY CERTIFY THAT THIS PLAT IS A TRUE REPRESENTATION OF A SURVEY MADE BY ME ASSISTED BY M. L. MILLER, W. J. STAEBLER AND DAN HOUSTON ALL DULY SWORN AND IS CORRECT TO THE BEST OF MY KNOWLEDGE.

SIGNED: April 3, 1957

D. A. SPARKS R. L. S. 3436

D. A. SPARKS REGISTERED 3436 IOWA LAND SURVEYOR

D.A.S.