
SECTION 1 - 77- 29

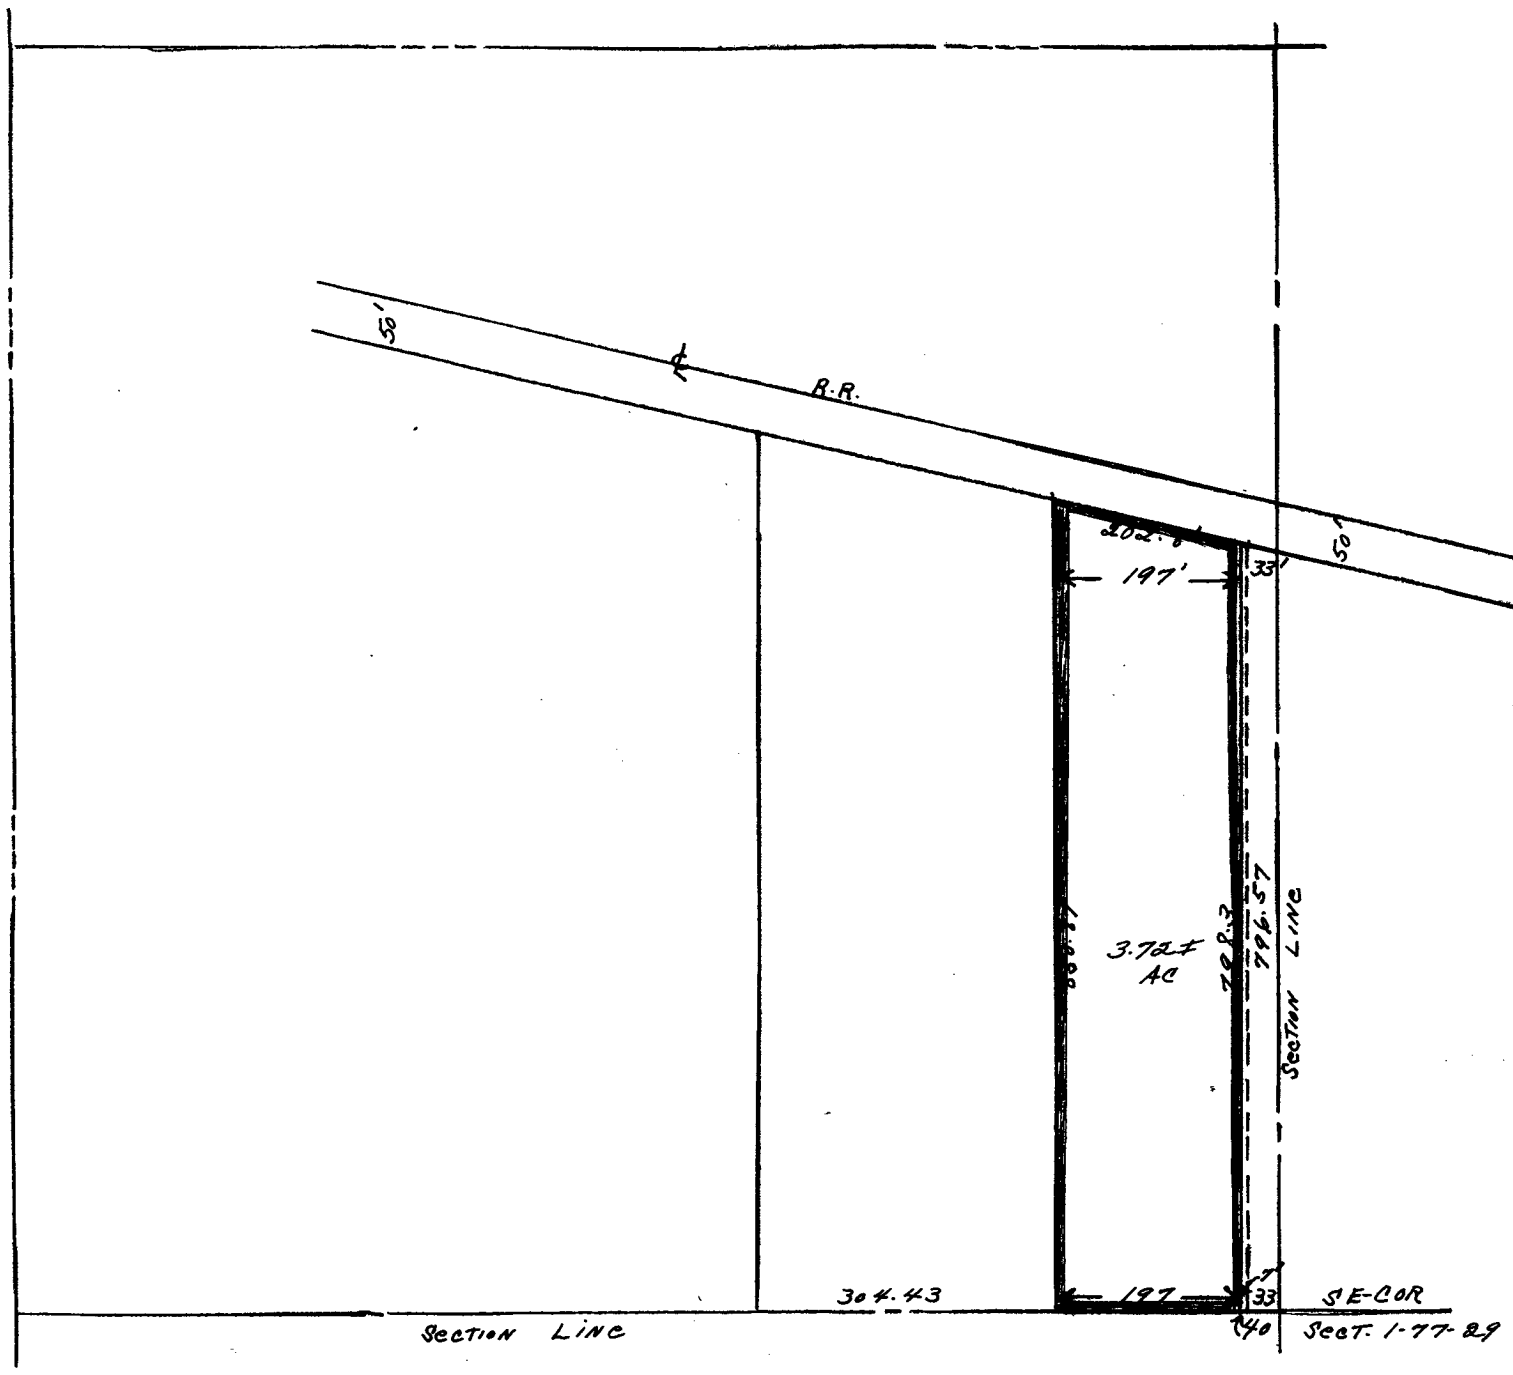

N

- Certificate -

I, R.C. Lutze a Registered Prof. Engr. and Land Surveyor of Perry, Dallas County, Iowa, hereby certify that I, surveyed the land shown on the above plat, and described as follows:-

Commencing at the Southeast Corner of Section 1 TWP, 77 N. R. 29 W. of the 5th P.M. Madison County, Iowa, thence West 40 feet, to the point of beginning, thence north 798.3 feet to the South Right of way line of Rail Road, thence northwesterly along said Right of way Line 202.8 feet, thence South, parallel with the East section line of said Section 1, 850.87 feet, to the South line of said Section, thence East 197 feet, to the point of beginning. Containing 3.72 ± acres.

April 1955 Scale 1" - 200'

R. C. Lutze
PROF. ENGR & L.S.

SE¼ - SE¼ SECTION 1-77-29
MADISON COUNTY IOWA

Filed for record July 7, 1959 at 4:30 O'clock P.M.
in Farm Plat Book 1, Page 262.

2690 Fee $ 1.00

Mary E. Welty, Recorder