
Plat of a Survey made for Mr. William Nelson Bond, in the NE¼ SE¼ Section 14-T77N-R29W of the 5th P.M., Madison County, Iowa.

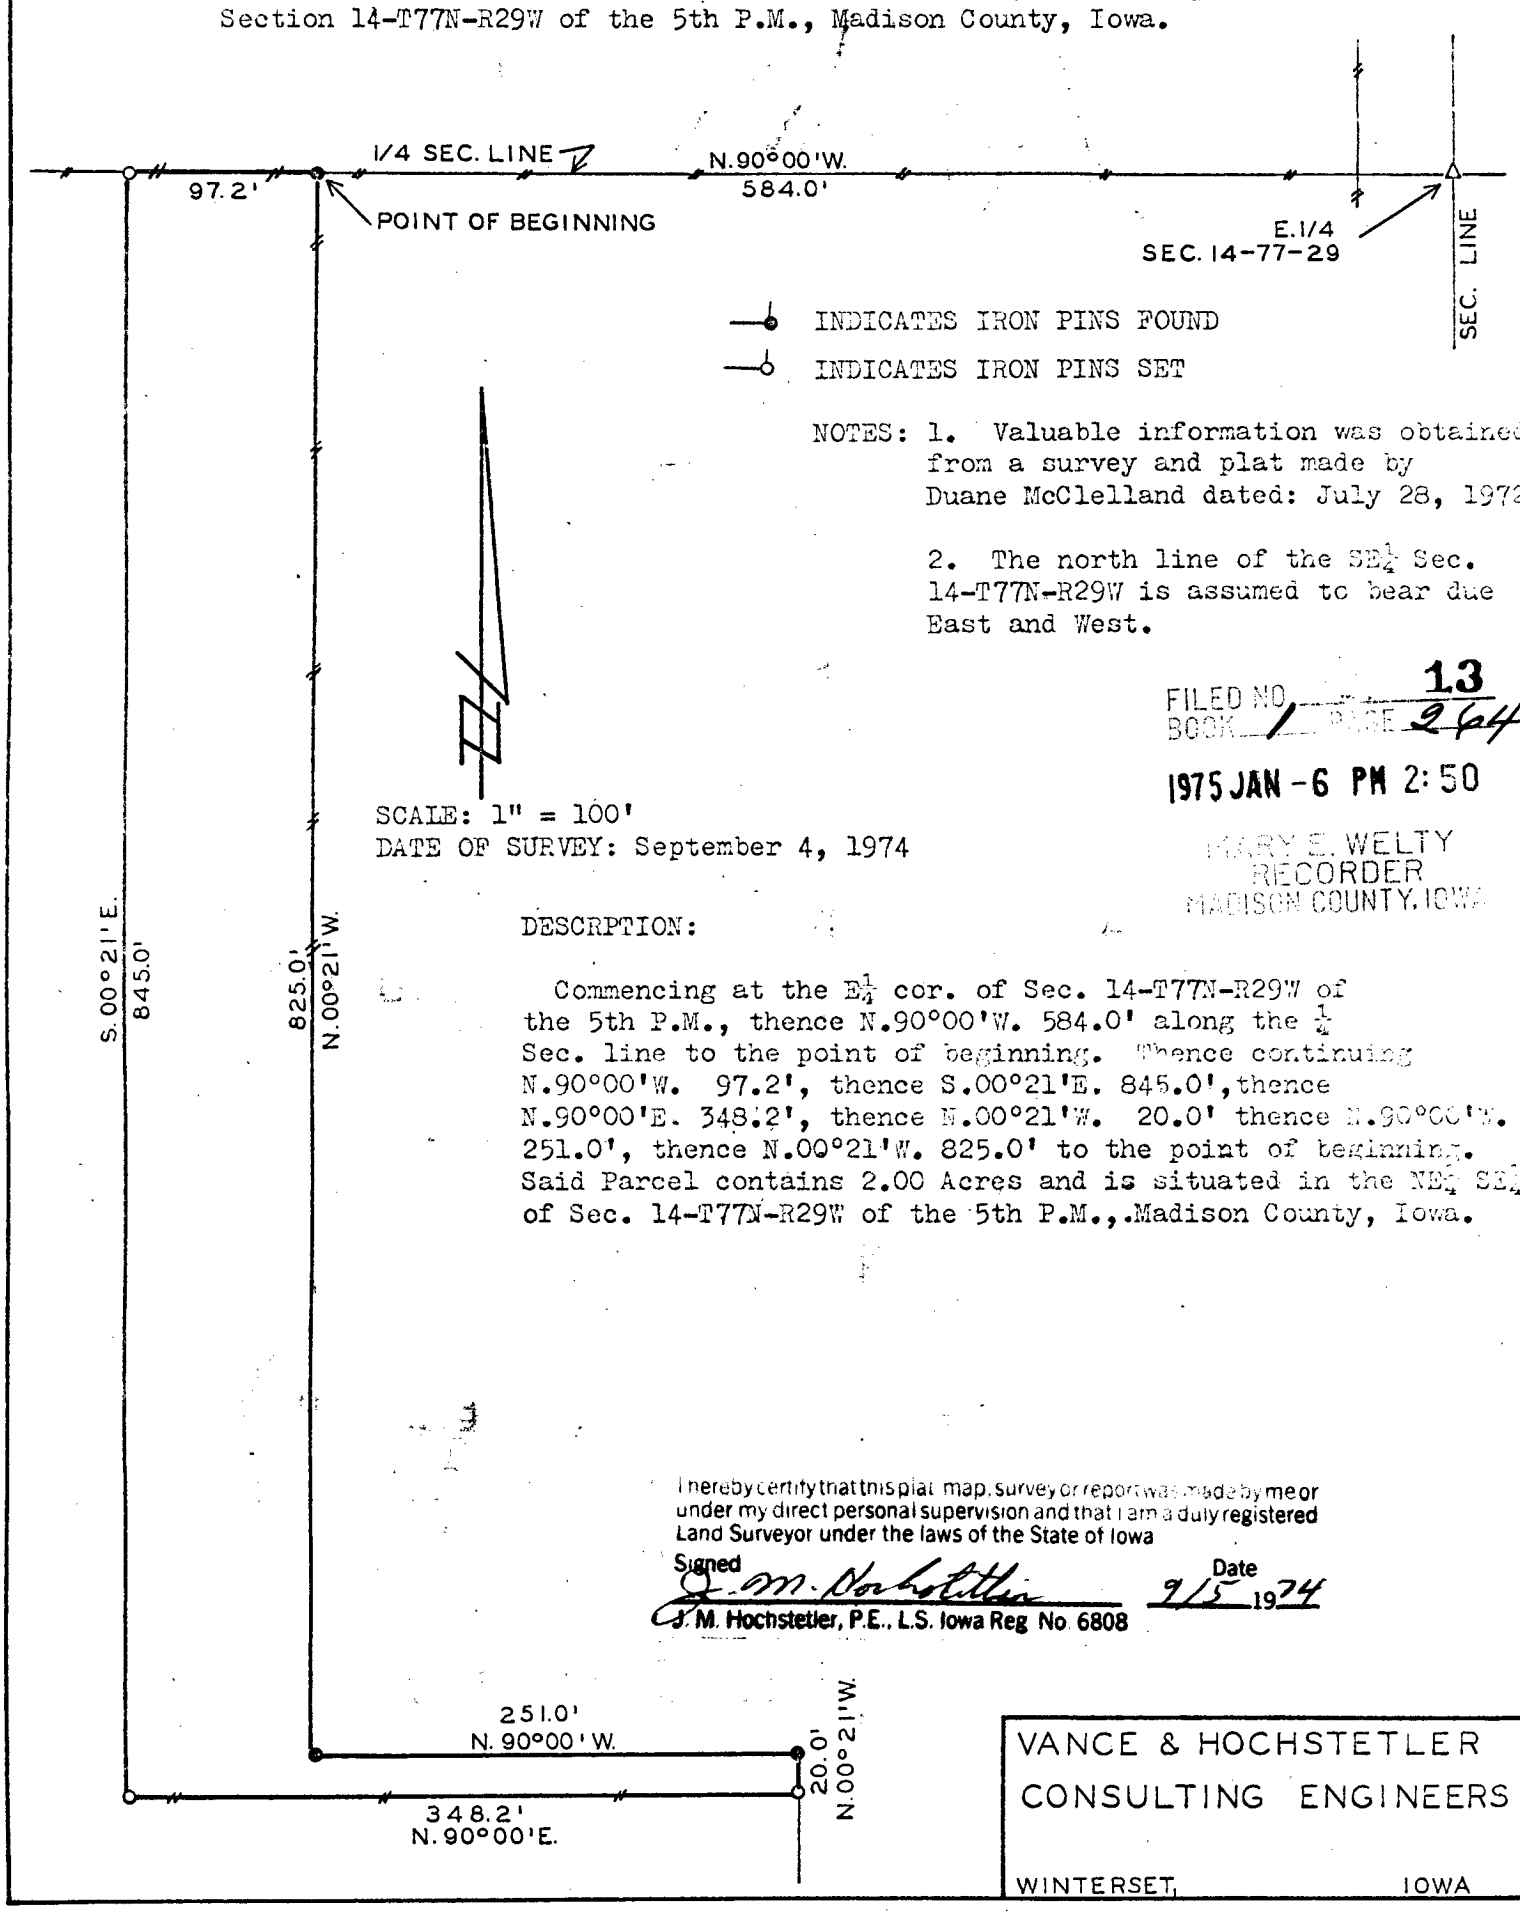

INDICATES IRON PINS FOUND

INDICATES IRON PINS SET

NOTES: 1. Valuable information was obtained from a survey and plat made by Duane McClelland dated: July 28, 1972

2. The north line of the SE¼ Sec. 14-T77N-R29W is assumed to bear due East and West.

FILED NO 13
BOOK 1 PAGE 264
1975 JAN -6 PM 2:50
MARY E. WELTY
RECORDER
MADISON COUNTY, IOWA

SCALE: 1" = 100'
DATE OF SURVEY: September 4, 1974

DESCRPTION:

Commencing at the E¼ cor. of Sec. 14-T77N-R29W of the 5th P.M., thence N.90°00'W. 584.0' along the ¼ Sec. line to the point of beginning. Thence continuing N.90°00'W. 97.2', thence S.00°21'E. 845.0', thence N.90°00'E. 348.2', thence N.00°21'W. 20.0' thence N.90°00'W. 251.0', thence N.00°21'W. 825.0' to the point of beginning. Said Parcel contains 2.00 Acres and is situated in the NE¼ SE¼ of Sec. 14-T77N-R29W of the 5th P.M.,.Madison County, Iowa.

I hereby certify that this plat, map, survey or report was made by me or under my direct personal supervision and that I am a duly registered Land Surveyor under the laws of the State of Iowa

Signed J. M. Hochstetler Date 9/5 1974

J. M. Hochstetler, P.E., L.S. Iowa Reg. No. 6808

VANCE & HOCHSTETLER
CONSULTING ENGINEERS

WINTERSET, IOWA