
#804 S
Filed Oct. 19, 1977
at 1:23 P.M.
Deed Rec. 107, page 160

Plat of a Survey made for Mr. & Mrs. Jim Ross in the South Half ($S\frac{1}{2}$) of the Northeast Quarter ($NE\frac{1}{4}$) of Section 9, Township 77 North, Range 29 West of the 5th P.M., Madison County, Iowa

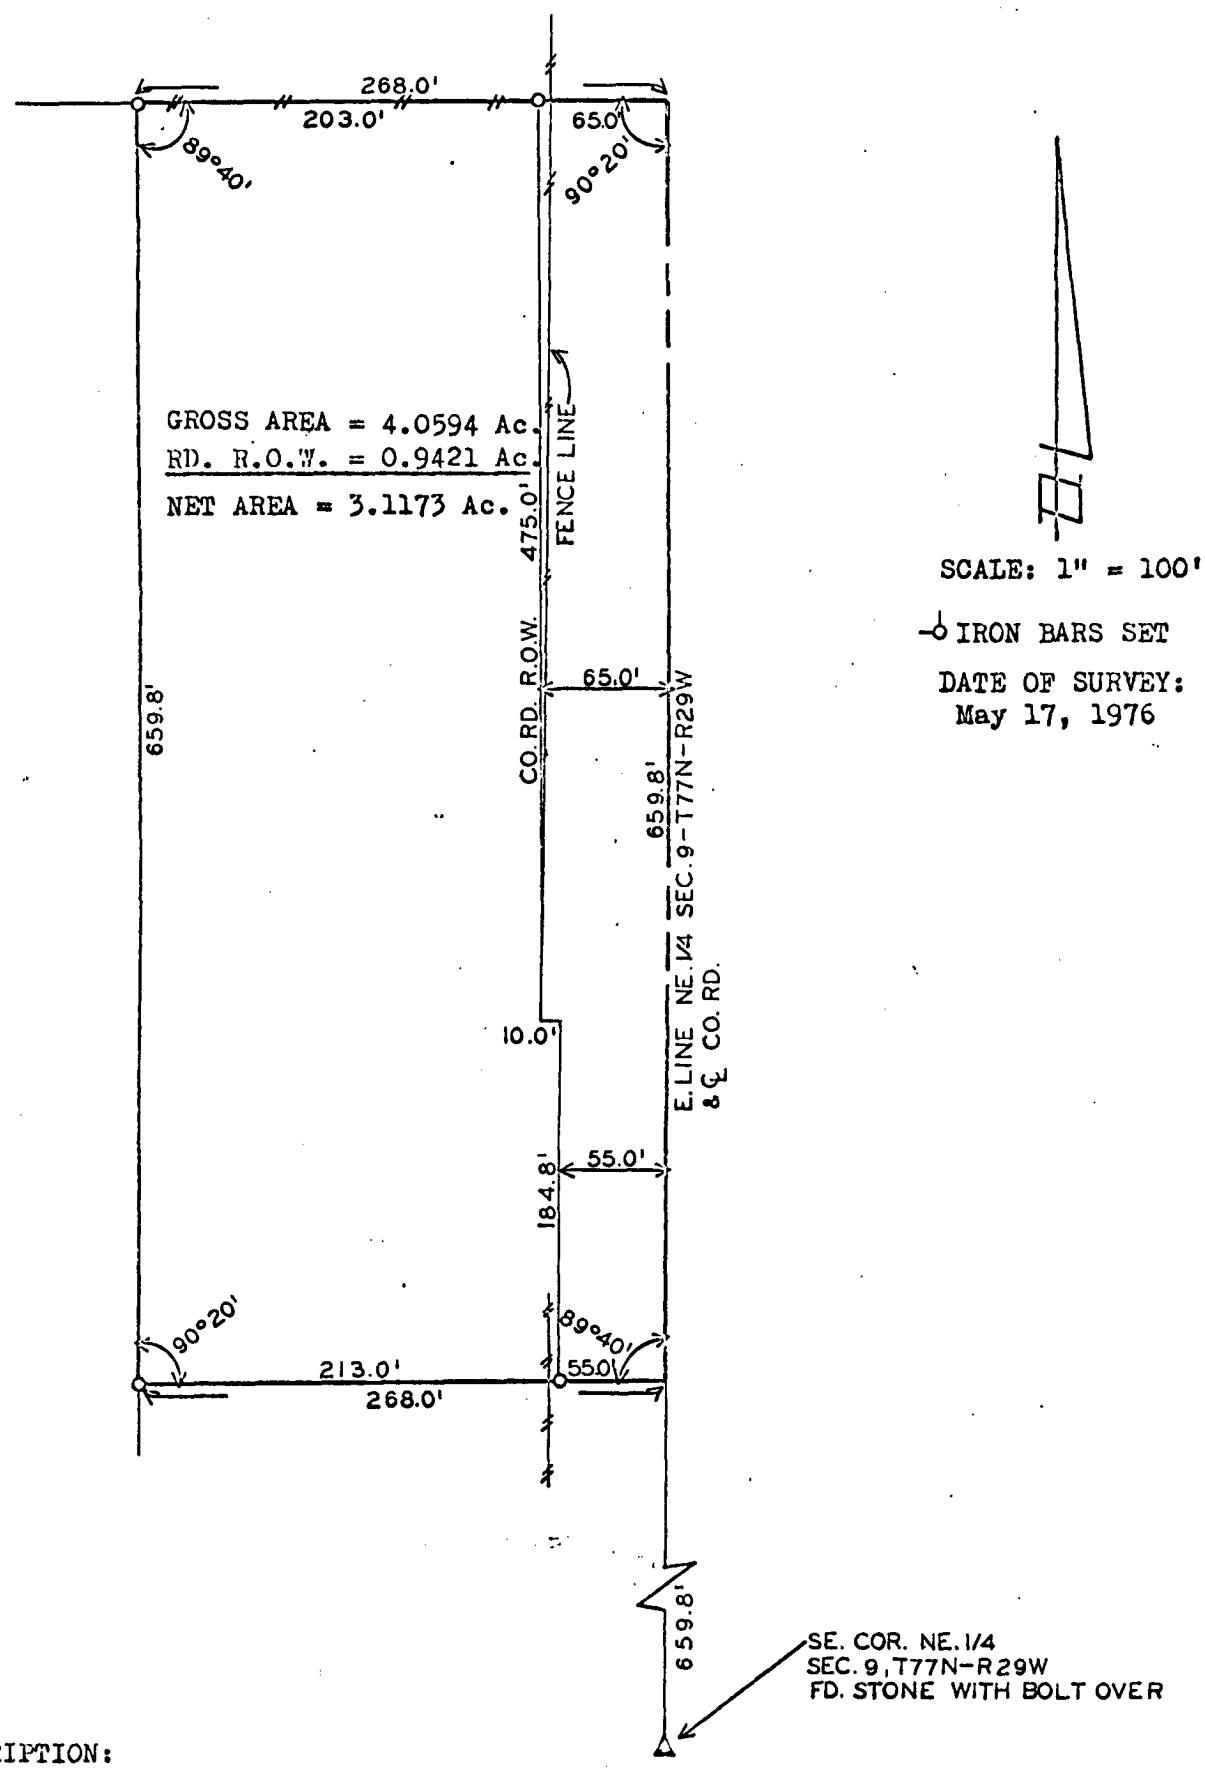

SCALE: 1" = 100'

IRON BARS SET

DATE OF SURVEY:
May 17, 1976

DESCRIPTION:

A parcel of land described as the East 268.0 feet of the North 659.8 feet of the South half ($S\frac{1}{2}$) of the Northeast Quarter ($NE\frac{1}{4}$) of Section 9, Township 77 North, Range 29 West of the 5th P.M., Madison County, Iowa containing 4.0594 Acres including 0.9421 Acres of County Road Right-of-Way.

I hereby certify that this plat, map, survey or report was made by me or under my direct personal supervision and that I am a duly registered Land Surveyor under the laws of the State of Iowa

Signed L. M. Hochstetler Date May 18 76
L.M. Hochstetler P.E.

VANCE & HOCHSTETLER
CONSULTING ENGINEERS
WINTERSET, IOWA