
Filed for record January 10, 1980 at 2:03 PM
Recorded in Book 1 at page 269.
1180 S
Mary E. Wefty, Recorder.

See Also Deed Rec 109 page 579.

PLAT OF A SURVEY MADE FOR GARY LOEST IN THE SOUTH HALF (S½) OF THE NORTHWEST QUARTER (NW¼) OF SECTION 22, TOWNSHIP 74 NORTH, RANGE 26 WEST OF THE 5TH P.M., MADISON COUNTY, IOWA.

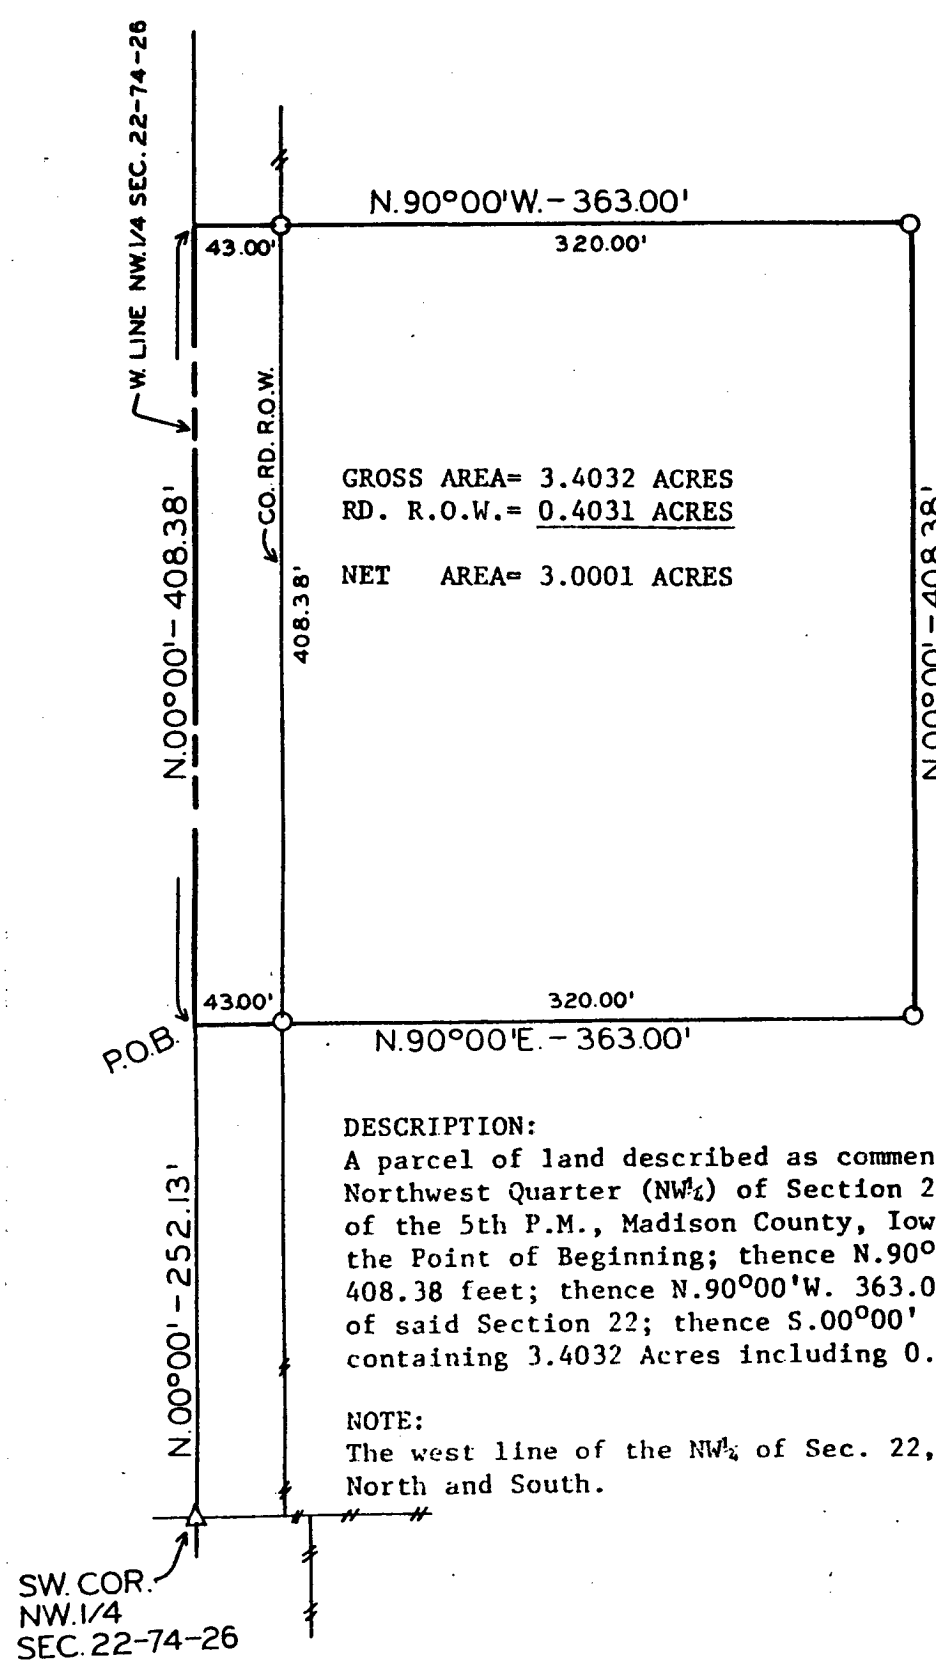

SCALE: 1"=100'

½" IRON PINS W/CAPS SET

DATE OF SURVEY:
8-17-79

DESCRIPTION:
A parcel of land described as commencing at the southwest corner of the Northwest Quarter (NW¼) of Section 22, Township 74 North, Range 26 West of the 5th P.M., Madison County, Iowa, thence N.00°00' 252.13 feet to the Point of Beginning; thence N.90°00'E. 363.00 feet; thence N.00°00' 408.38 feet; thence N.90°00'W. 363.00 feet to the west line of the NW¼ of said Section 22; thence S.00°00' 408.38 feet to the Point of Beginning containing 3.4032 Acres including 0.4031 Acres of County Road Right-of-way

NOTE:
The west line of the NW¼ of Sec. 22, T74N-R26W is assumed to bear due North and South.

There [illegible] under my direct personal supervision and that I am a duly licensed Land Surveyor under the laws of the State of Iowa

Signed [signature] Date Aug. 22 19 79

VANCE & HOCHSTETLER, P.C.
CONSULTING ENGINEERS