
293 13-77-27

PLAT OF SURVEY FOR CAROLD RINARD
IN THE NW¼ OF THE NE¼ OF
SECTION 13, T77N, R27W,
OF THE 5TH P.M.,
MADISON COUNTY, IOWA

FILED NO. 210
BOOK 1 PAGE 293
FARM PLAT
1983 JUL 28 PM 2:45

MARY E. WELTY
RECORDER
MADISON COUNTY, IOWA
Fee
$3.00

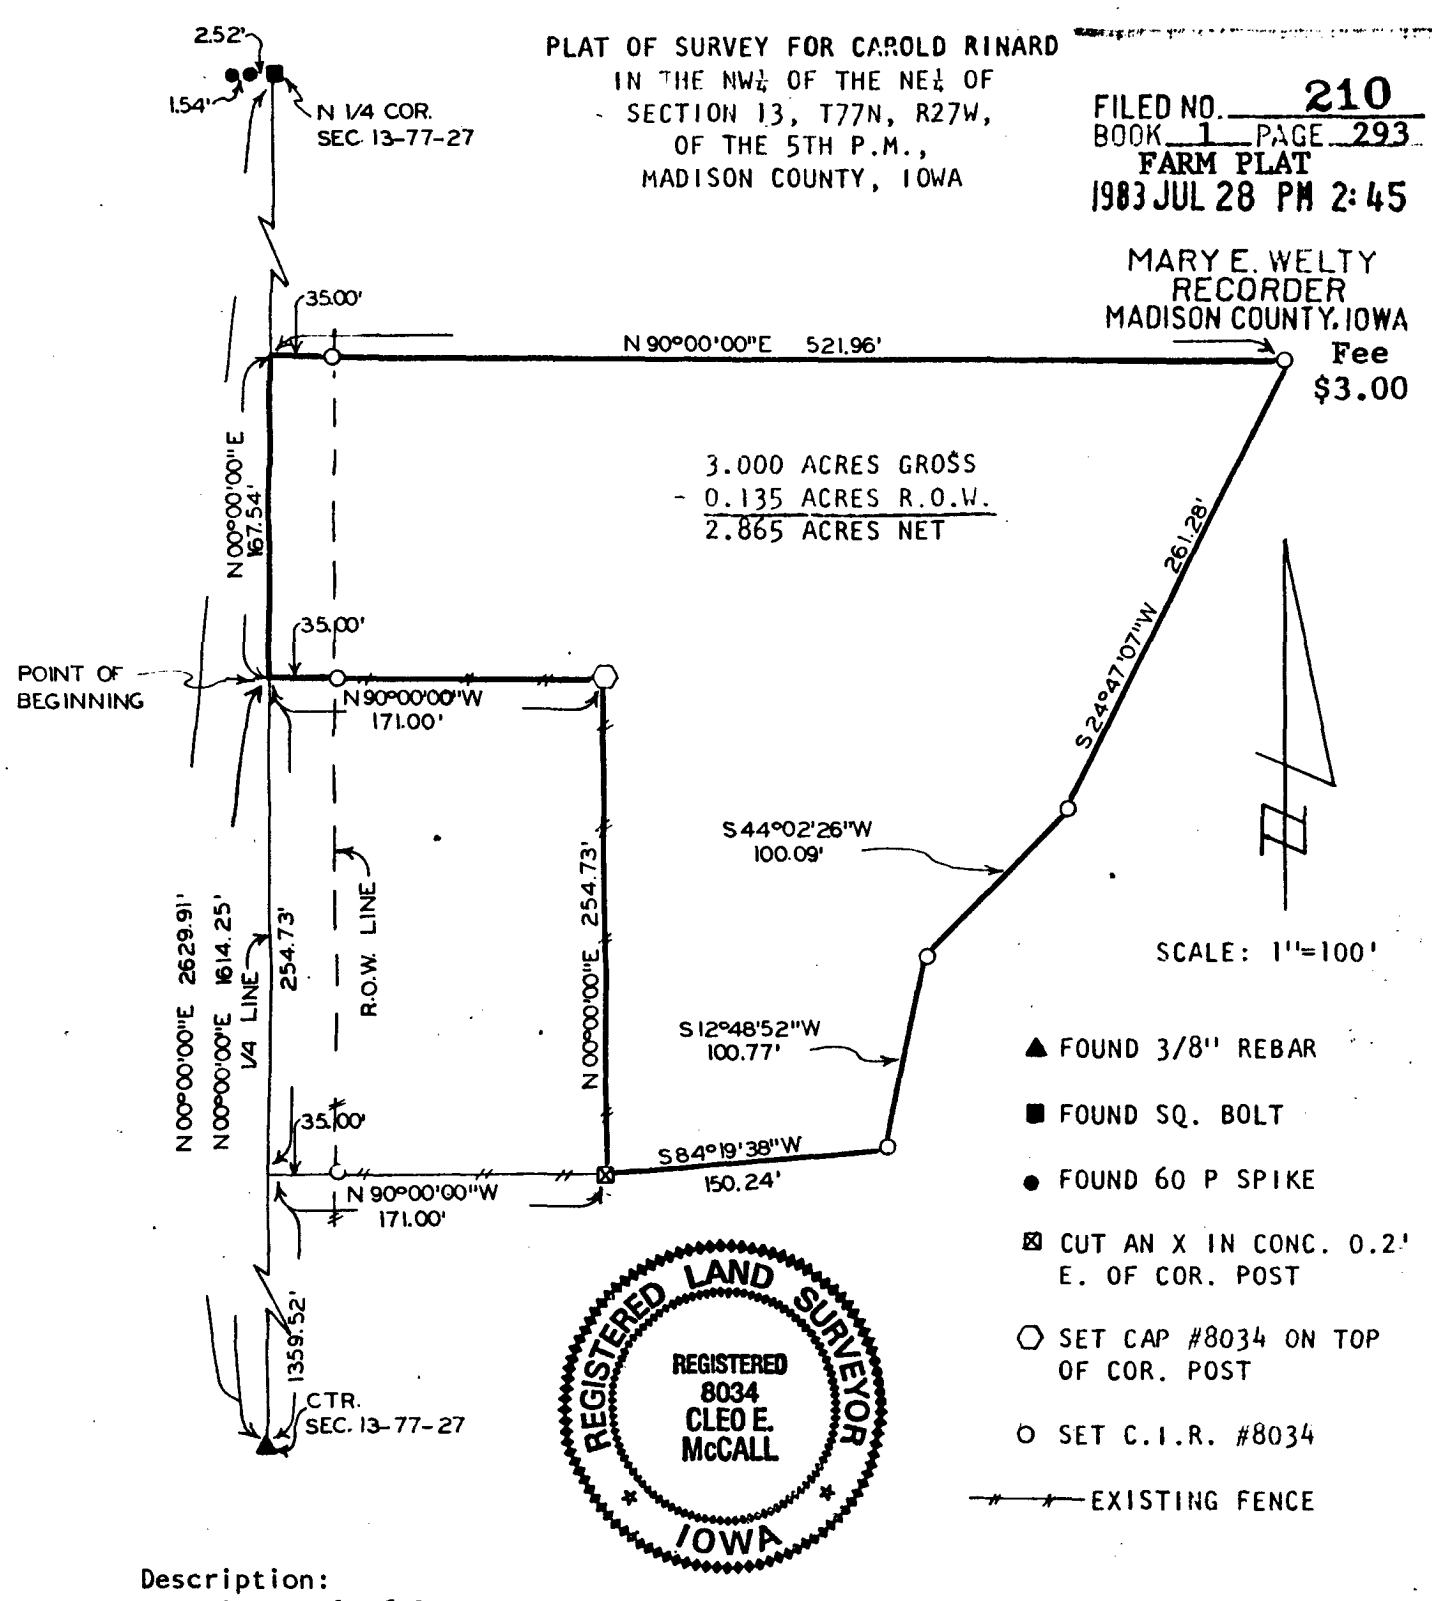

REGISTERED LAND SURVEYOR
REGISTERED
8034
CLEO E.
McCALL
IOWA

Description:

A parcel of land in the Northwest Quarter of the Northeast Quarter of Section 13, Township 77 North, Range 27 West of the 5th Principal Meridian, Madison County, Iowa, more particularly described as:

Commencing at the Southwest corner of the Northeast Quarter of Section 13, Township 77 North, Range 27 West of the 5th Principal Meridian, Madison County, Iowa; thence along the west line of said Northeast Quarter on an assumed bearing of North 00°00'00" East a distance of 1614.25 feet to the Point of Beginning; thence continuing North 00°00'00" East 167.54 feet; thence North 90°00'00" East 521.96 feet; thence South 24°47'07" West 261.28 feet; thence South 44°02'26" West 100.09 feet; thence South 12°48'52" West 100.77 feet; thence South 84°19'38" West 150.24 feet; thence North 00°00'00" East 254.73 feet; thence North 90°00'00" West 171.00 feet to the Point of Beginning, containing 3.000 acres, more or less, including public road, and 2.865 acres, more or less, excluding public road.

I hereby certify that this plat, map, survey or report was made by me or under my direct personal supervision and that I am a duly registered Land Surveyor under the laws of the State of Iowa.

Signed Cleo E. McCall Date 7-1 19 83

CLEO E. McCALL, R.L.S. IOWA REG. NO. 8034

VANCE & HOCHSTETLER, P.C.
CONSULTING ENGINEERS
WINTERSET, IOWA 50273