283

9-75-29


...e Southwest ... the Fifth P... Madison County, ... 75 ... South ... quarter of ... Section ... th, ... beginning ... assumed ...

SURVEY FOR EDNA DOLSON

JANUARY 8, 1983

LEGEND

- PROPERTY LINE - SURVEY
- △ SECTION CORNER - I.P. Fd.
- ○ P.K. NAIL SET
- ● 1/2" ϕ x 30" REBAR W/ CAP - SET
- EXISTING FENCE
- SECTION LINE
- NEW FENCE - UNDER CONSTRUCTION

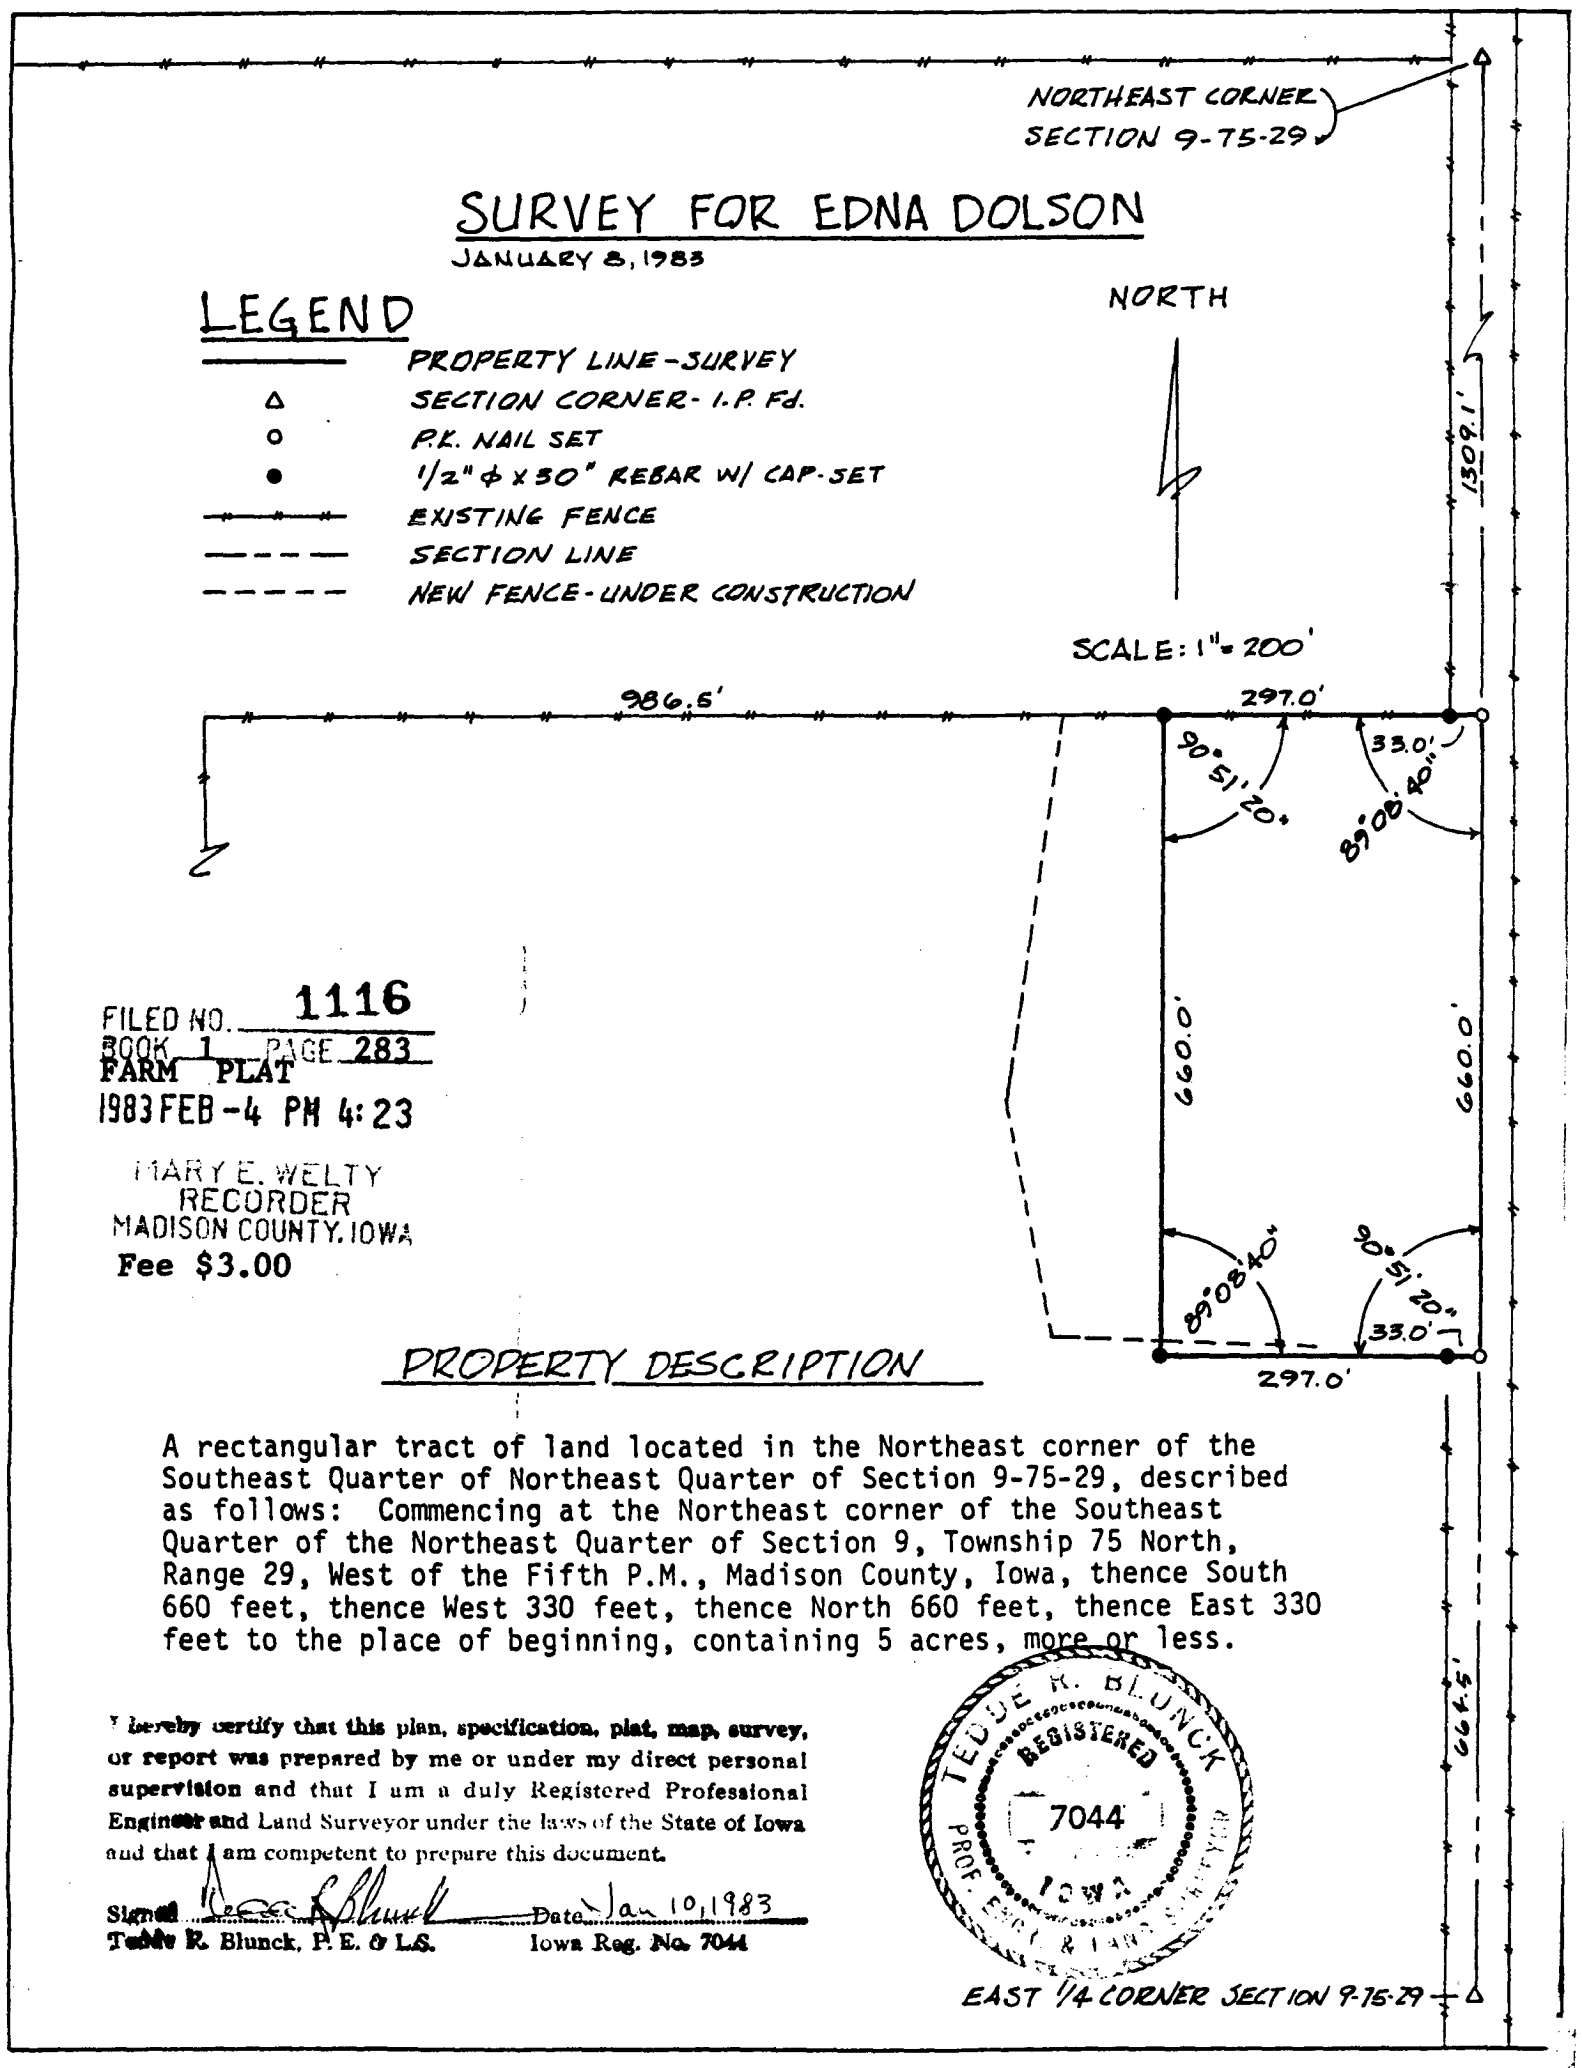

FILED NO. 1116
BOOK 1 PAGE 283
FARM PLAT
1983 FEB -4 PM 4:23

MARY E. WELTY
RECORDER
MADISON COUNTY, IOWA
Fee $3.00

PROPERTY DESCRIPTION

A rectangular tract of land located in the Northeast corner of the Southeast Quarter of Northeast Quarter of Section 9-75-29, described as follows: Commencing at the Northeast corner of the Southeast Quarter of the Northeast Quarter of Section 9, Township 75 North, Range 29, West of the Fifth P.M., Madison County, Iowa, thence South 660 feet, thence West 330 feet, thence North 660 feet, thence East 330 feet to the place of beginning, containing 5 acres, more or less.

I hereby certify that this plan, specification, plat, map, survey, or report was prepared by me or under my direct personal supervision and that I am a duly Registered Professional Engineer and Land Surveyor under the laws of the State of Iowa and that I am competent to prepare this document.

Signed Teddie R. Blunck Date Jan 10, 1983

Teddie R. Blunck, P.E. & L.S. Iowa Reg. No. 7044

TEDDIE R. BLUNCK REGISTERED 7044 IOWA PROF. ENGR. & LAND SURVEYOR