7-76-29


28

IND. ✓
SEC. ✓
PAGE ✓

PLAT OF SURVEY FOR ROBERT BOYLE
IN THE SE¼-SE¼ OF SECTION 7, T76N, R29W
OF THE 5TH P.M.
MADISON COUNTY, IOWA

FILED NO. 1323
BOOK 1 PAGE 284
FARM PLAT
1983 MAR -8 PM 2:37

MARY E. WELTY
RECORDER
MADISON COUNTY, IOWA
Fee $3.00

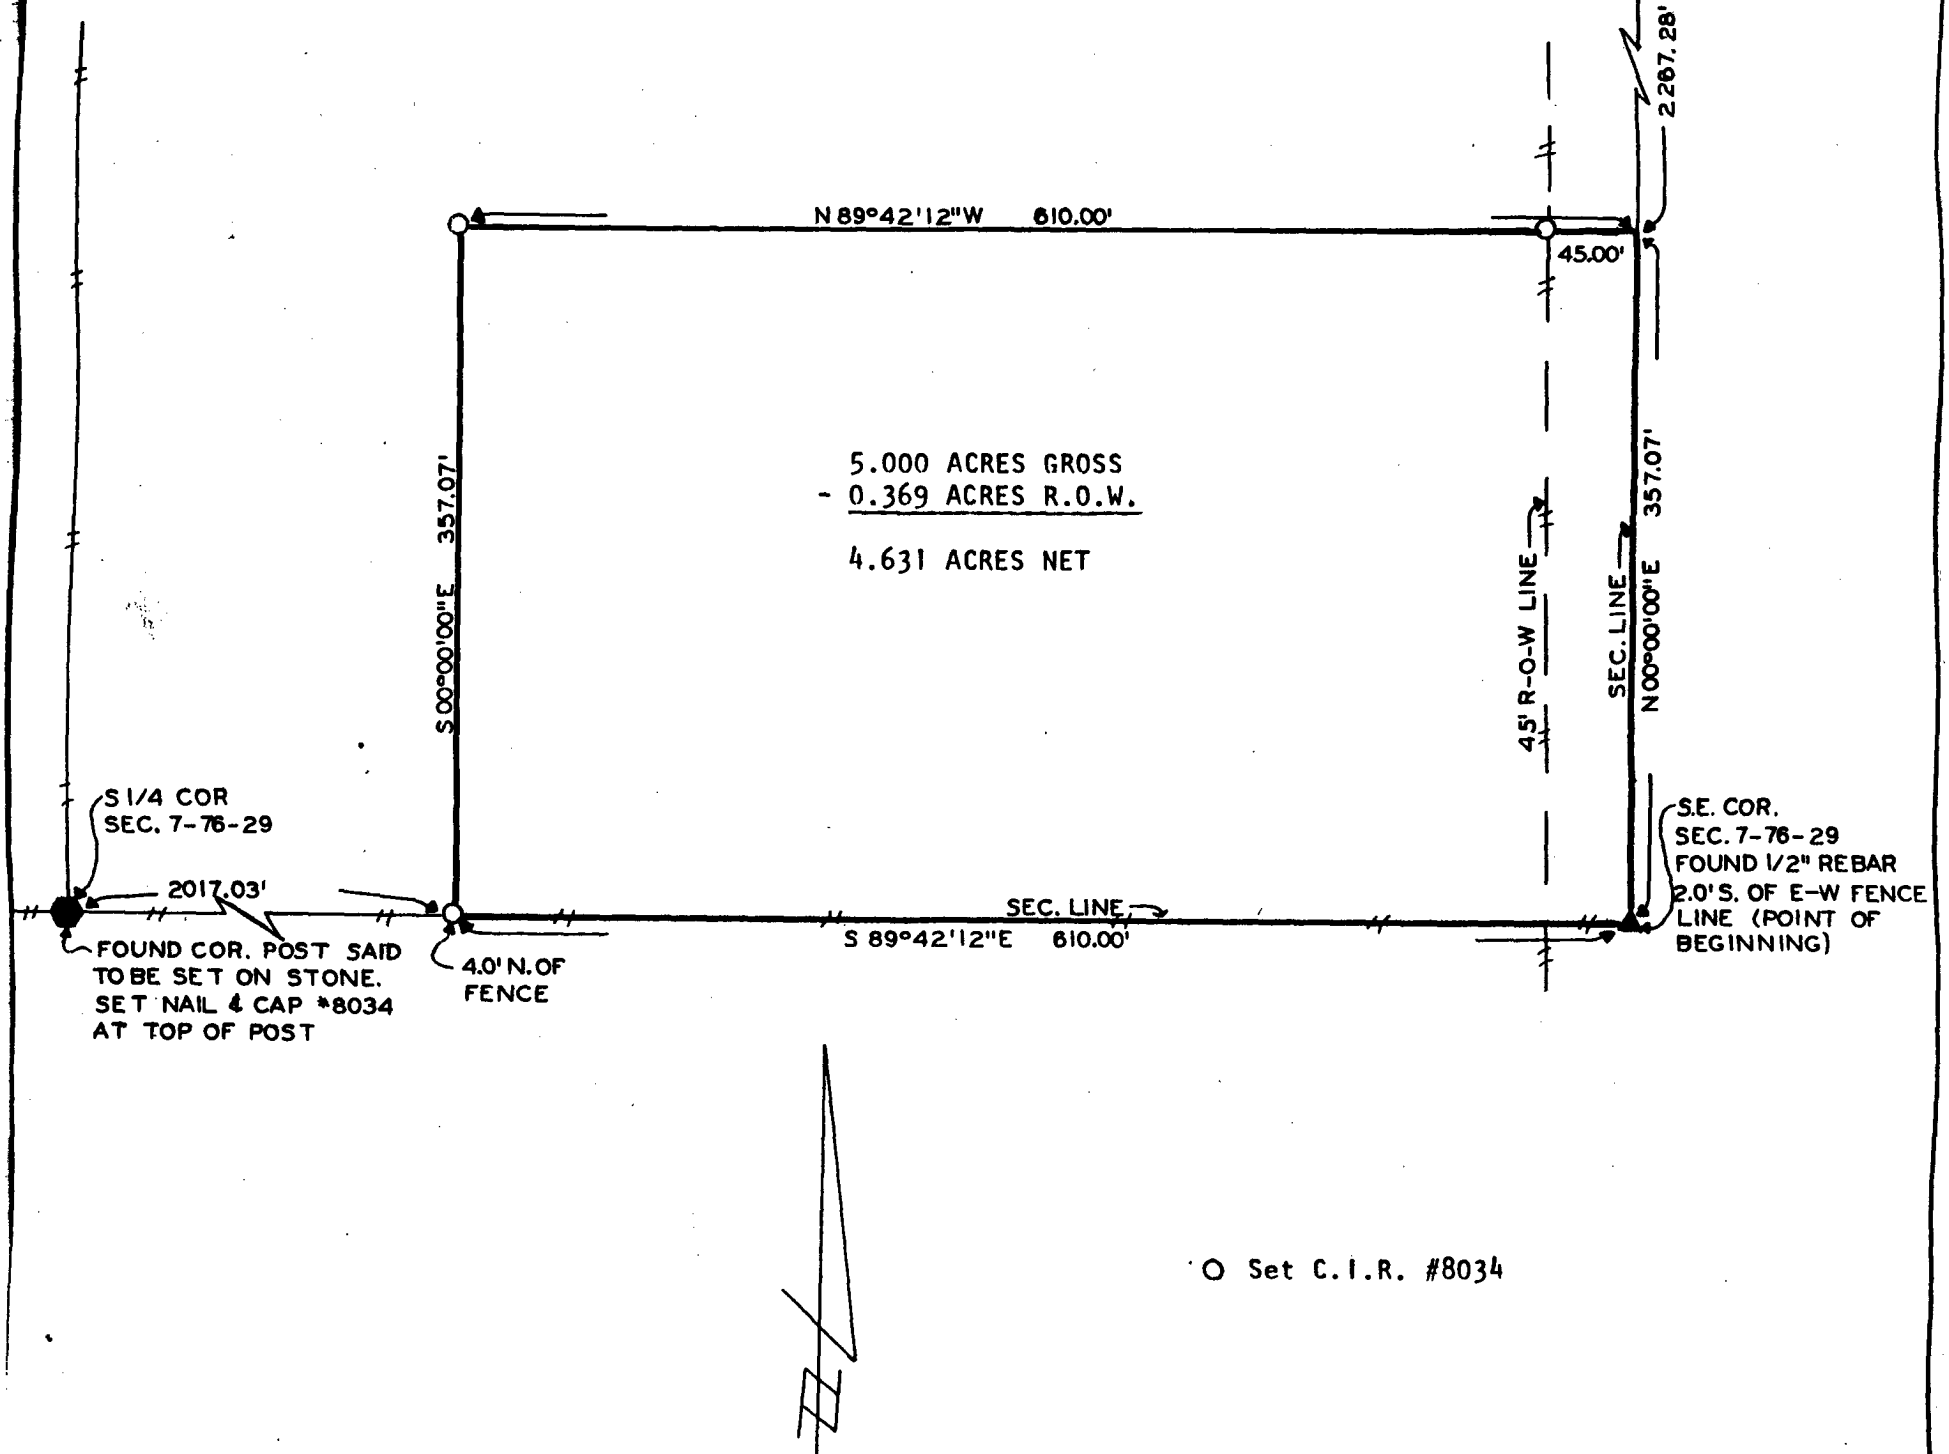

SCALE: 1" = 100'

Boyle Description:

A parcel of land in the Southeast Quarter of the Southeast Quarter of Section 7, Township 76 North, Range 29 West of the 5th Principal Meridian, Madison County, Iowa, more particularly described as:

Beginning at the Southeast corner of Section 7, Township 76 North, Range 29 West of the 5th P.M., Madison County, Iowa; thence along the east line of the Southeast Quarter of said section, on an assumed bearing of North 00°00'00" East a distance of 357.07 feet; thence North 89°42'12" West 610.00 feet; thence South 00°00'00" East 357.07 feet to the south line of said Southeast Quarter; thence South 89°42'12" East 610.00 feet to the Point of Beginning, containing 5.000 acres, more or less including public road, and 4.631 acres, more or less, excluding public road.

REGISTERED LAND SURVEYOR
REGISTERED
8034
CLEO E.
McCALL
IOWA

I hereby certify that this land survey report was made by me or under my direct personal supervision and that I am a duly registered Land Surveyor under the laws of the State of Iowa.

Signed Cleo E. McCall Date 1-28 19 83

CLEO E. McCALL, R.L.S. IOWA REG. NO. 8034

VANCE & HOCHSTETLER, P.C.
CONSULTING ENGINEERS
WINTERSET, IOWA 50273