
14-75-27

PLAT OF SURVEY MADE FOR MIKE WILDIN IN THE SOUTHWEST QUARTER OF THE NORTHEAST QUARTER OF SECTION 14, TOWNSHIP 75 NORTH, RANGE 27 WEST OF THE 5TH PRINCIPAL MERIDIAN, MADISON COUNTY, IOWA

FILED NO. 591
BOOK 1 PAGE 297
FARM PLAT
1983 SEP 16 PM 12:12
MARY E. WELTY
RECORDER
MADISON COUNTY, IOWA
Fee $3.00

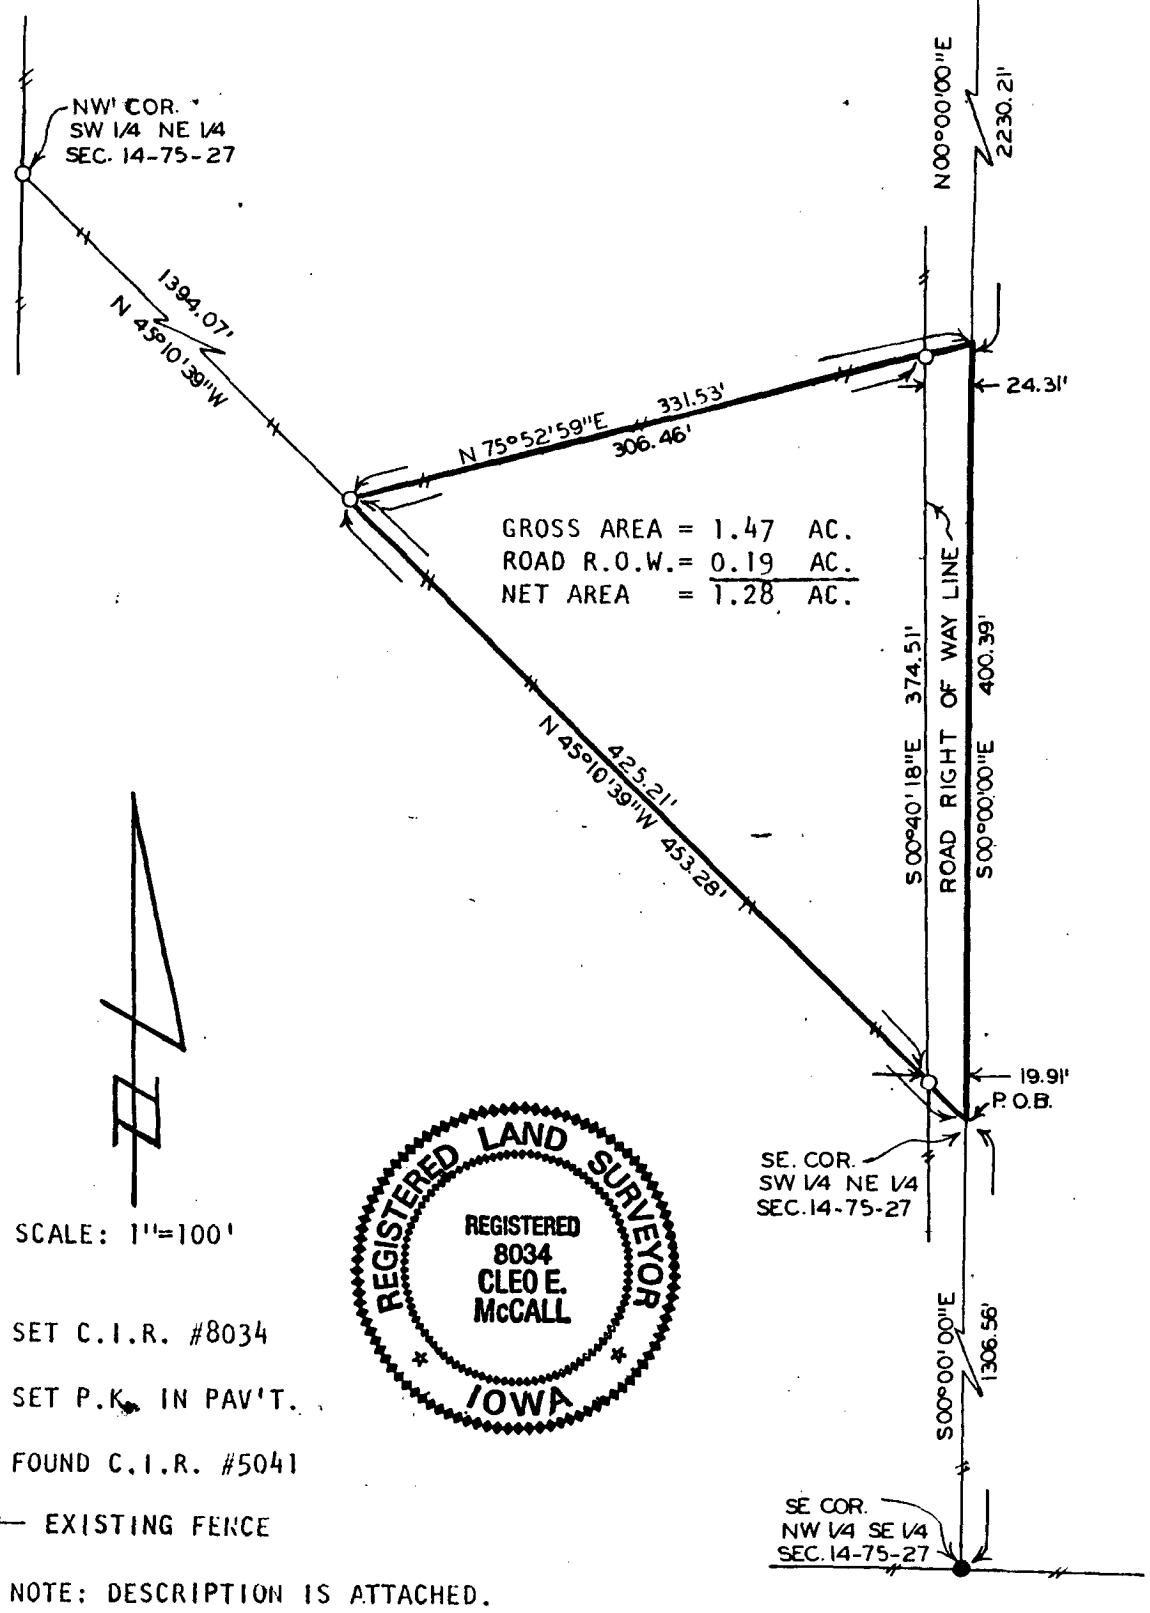

NOTE: DESCRIPTION IS ATTACHED.

I hereby certify that this plat, map, survey or report was made by me or under my direct personal supervision and that I am a duly registered Land Surveyor under the laws of the State of Iowa.

Signed Cleo E. McCall Date 8-31 1983

CLEO E. McCALL, R.L.S. IOWA REG. NO. 8034

VANCE & HOCHSTETLER, P.C.
CONSULTING ENGINEERS
WINTERSET, IOWA 50273

Wildin Description:

A parcel of land in the Southwest Quarter of the Northeast Quarter of Section 14, Township 75 North, Range 27 West of the 5th Principal Meridian, Madison County, Iowa; more particularly described as:

Beginning at the Southeast corner of the Southwest Quarter of the Northeast Quarter of Section 14, Township 75 North, Range 27 West of the 5th P.M., Madison County, Iowa; thence along the diagonal line of said Southwest Quarter of the Northeast Quarter, North 45°10'39" West 453.28 feet; thence North 75°52'59" East 331.53 feet to the east line of said Southwest Quarter of the Northeast Quarter; thence along said east line, 400.39 feet to the Point of Beginning, containing 1.47 acres, more or less including public road, and 1.28 acres, more or less, excluding public road.

Bearings are based on the east line of the Southwest Quarter of the Northeast Quarter of Section 14, T75N, R27W, which is assumed to bear South.