313


36-76-28

PLAT OF A SURVEY MADE FOR BOB LAFOLLETTE IN THE SOUTHEAST QUARTER (SE¼) OF THE SOUTHWEST QUARTER (SW¼) OF SECTION 36, TOWNSHIP 76 NORTH, RANGE 28 WEST OF THE 5TH P.M., MADISON COUNTY, IOWA

#638 638

FILED NO. _____
BOOK 1 PAGE 313
FARM PLAT
1984 NOV -2 AM 7:31

MARY E. WELTY
RECORDER
MADISON COUNTY, IOWA
Fee $5.00

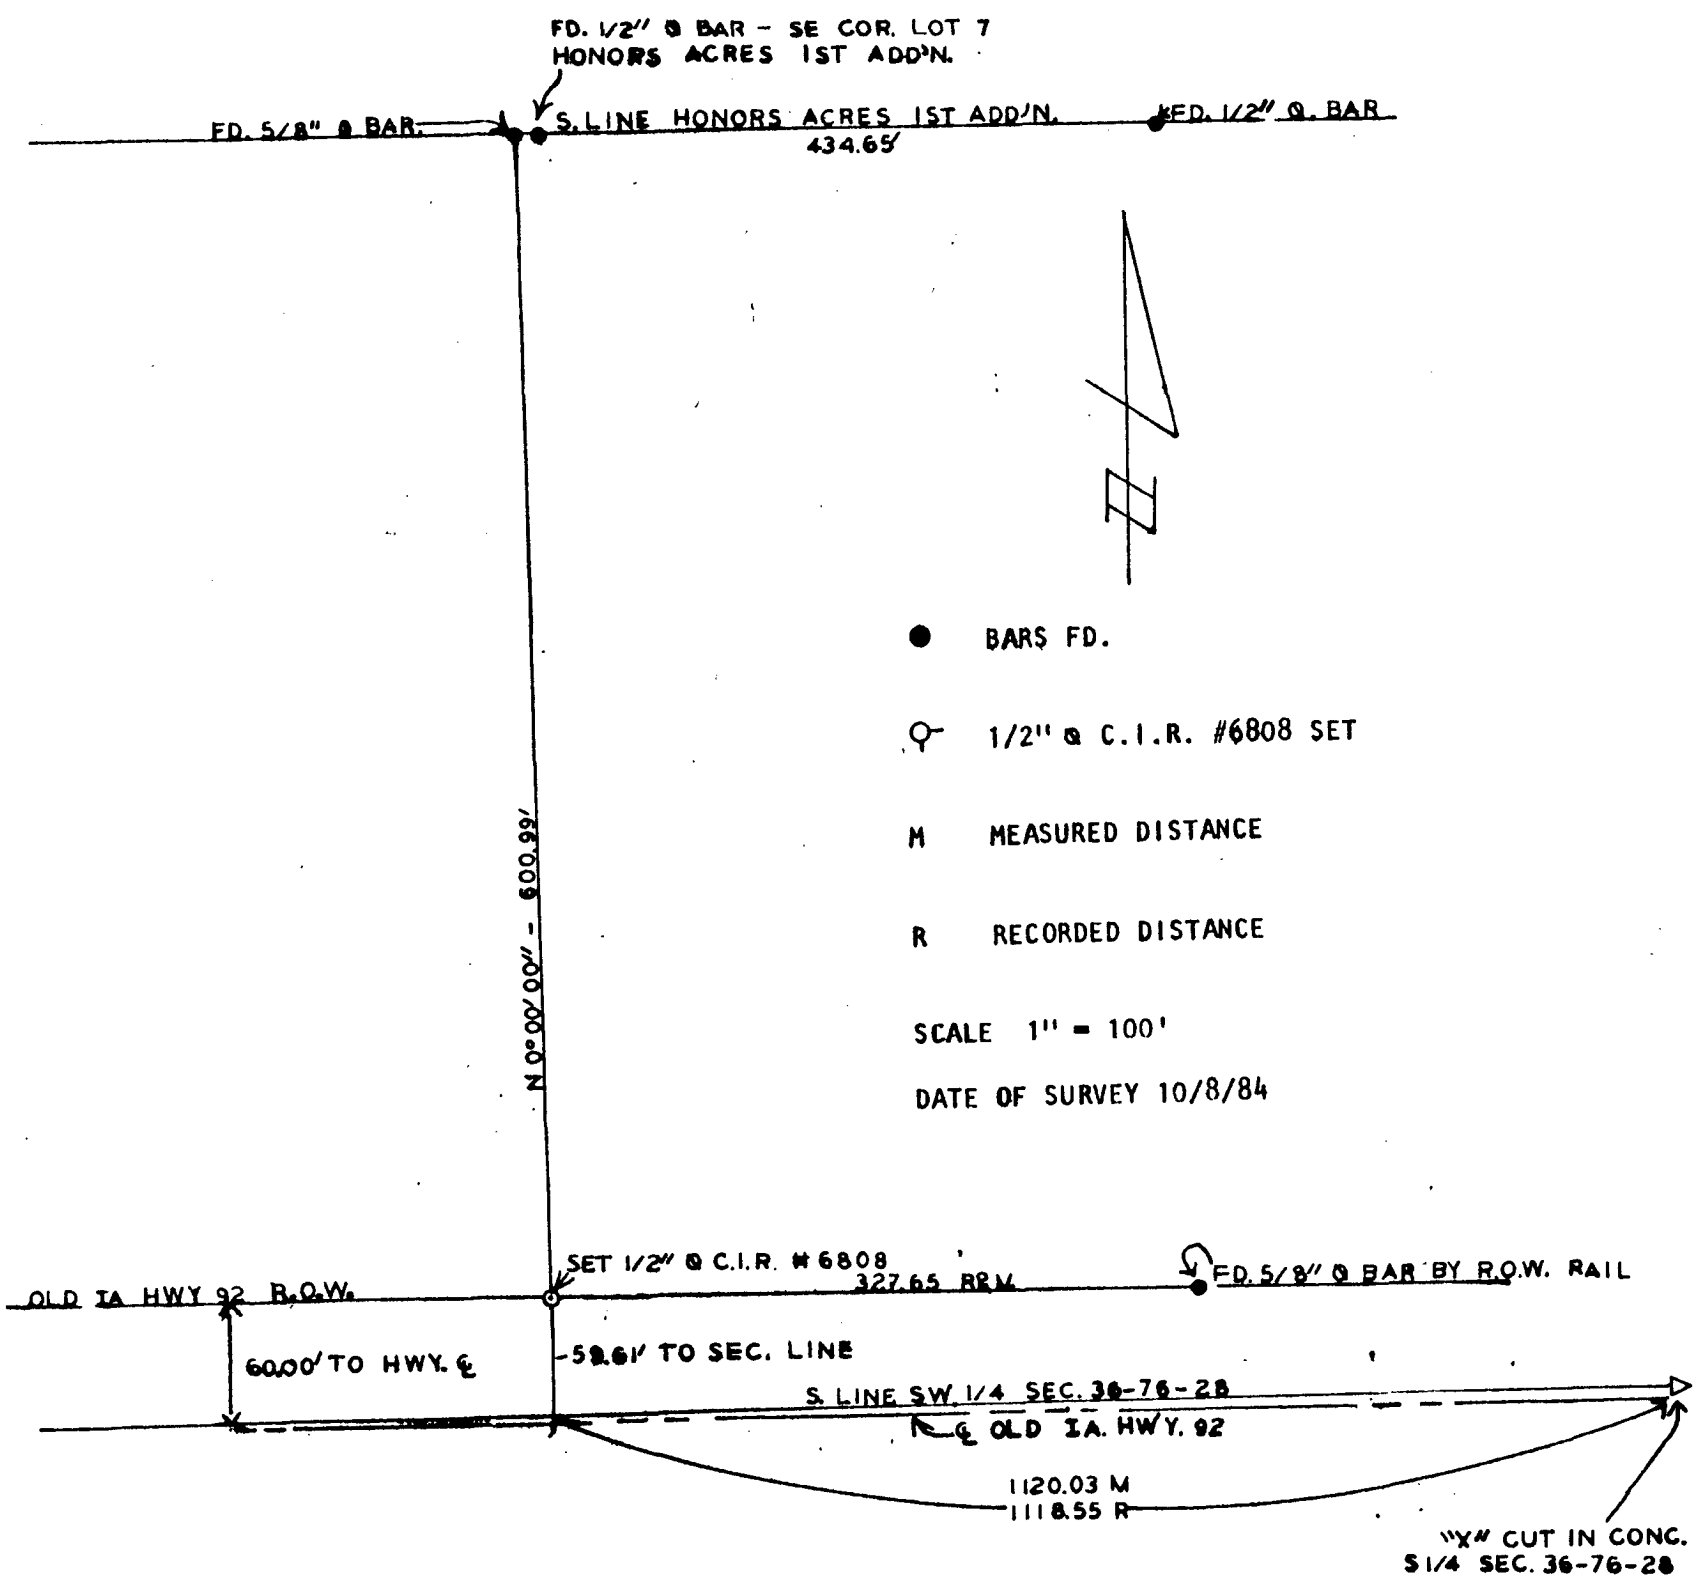

DESCRIPTION:
SURVEY WAS PERFORMED TO RELOCATE THE WEST LINE OF PROPERTY OWNED BY BETHESDA FOUNDATION

I hereby certify that this survey was prepared by me or under my direct personal supervision and that I am a duly registered Land Surveyor under the laws of the State of Iowa

Signed _____ Date 10/19 19 84

J.M. Hochstetler, P.E., L.S. Iowa Reg. No. 6808

VANCE & HOCHSTETLER, P.C.
CONSULTING ENGINEERS
WINTERSET, IOWA 50273