
322

PLAT OF A SURVEY MADE FOR MADISON COUNTY CONSERVATION BOARD IN SECTIONS 20 AND 21, TOWNSHIP 74 NORTH, RANGE 27 WEST OF THE 5TH P.M., MADISON COUNTY, IOWA

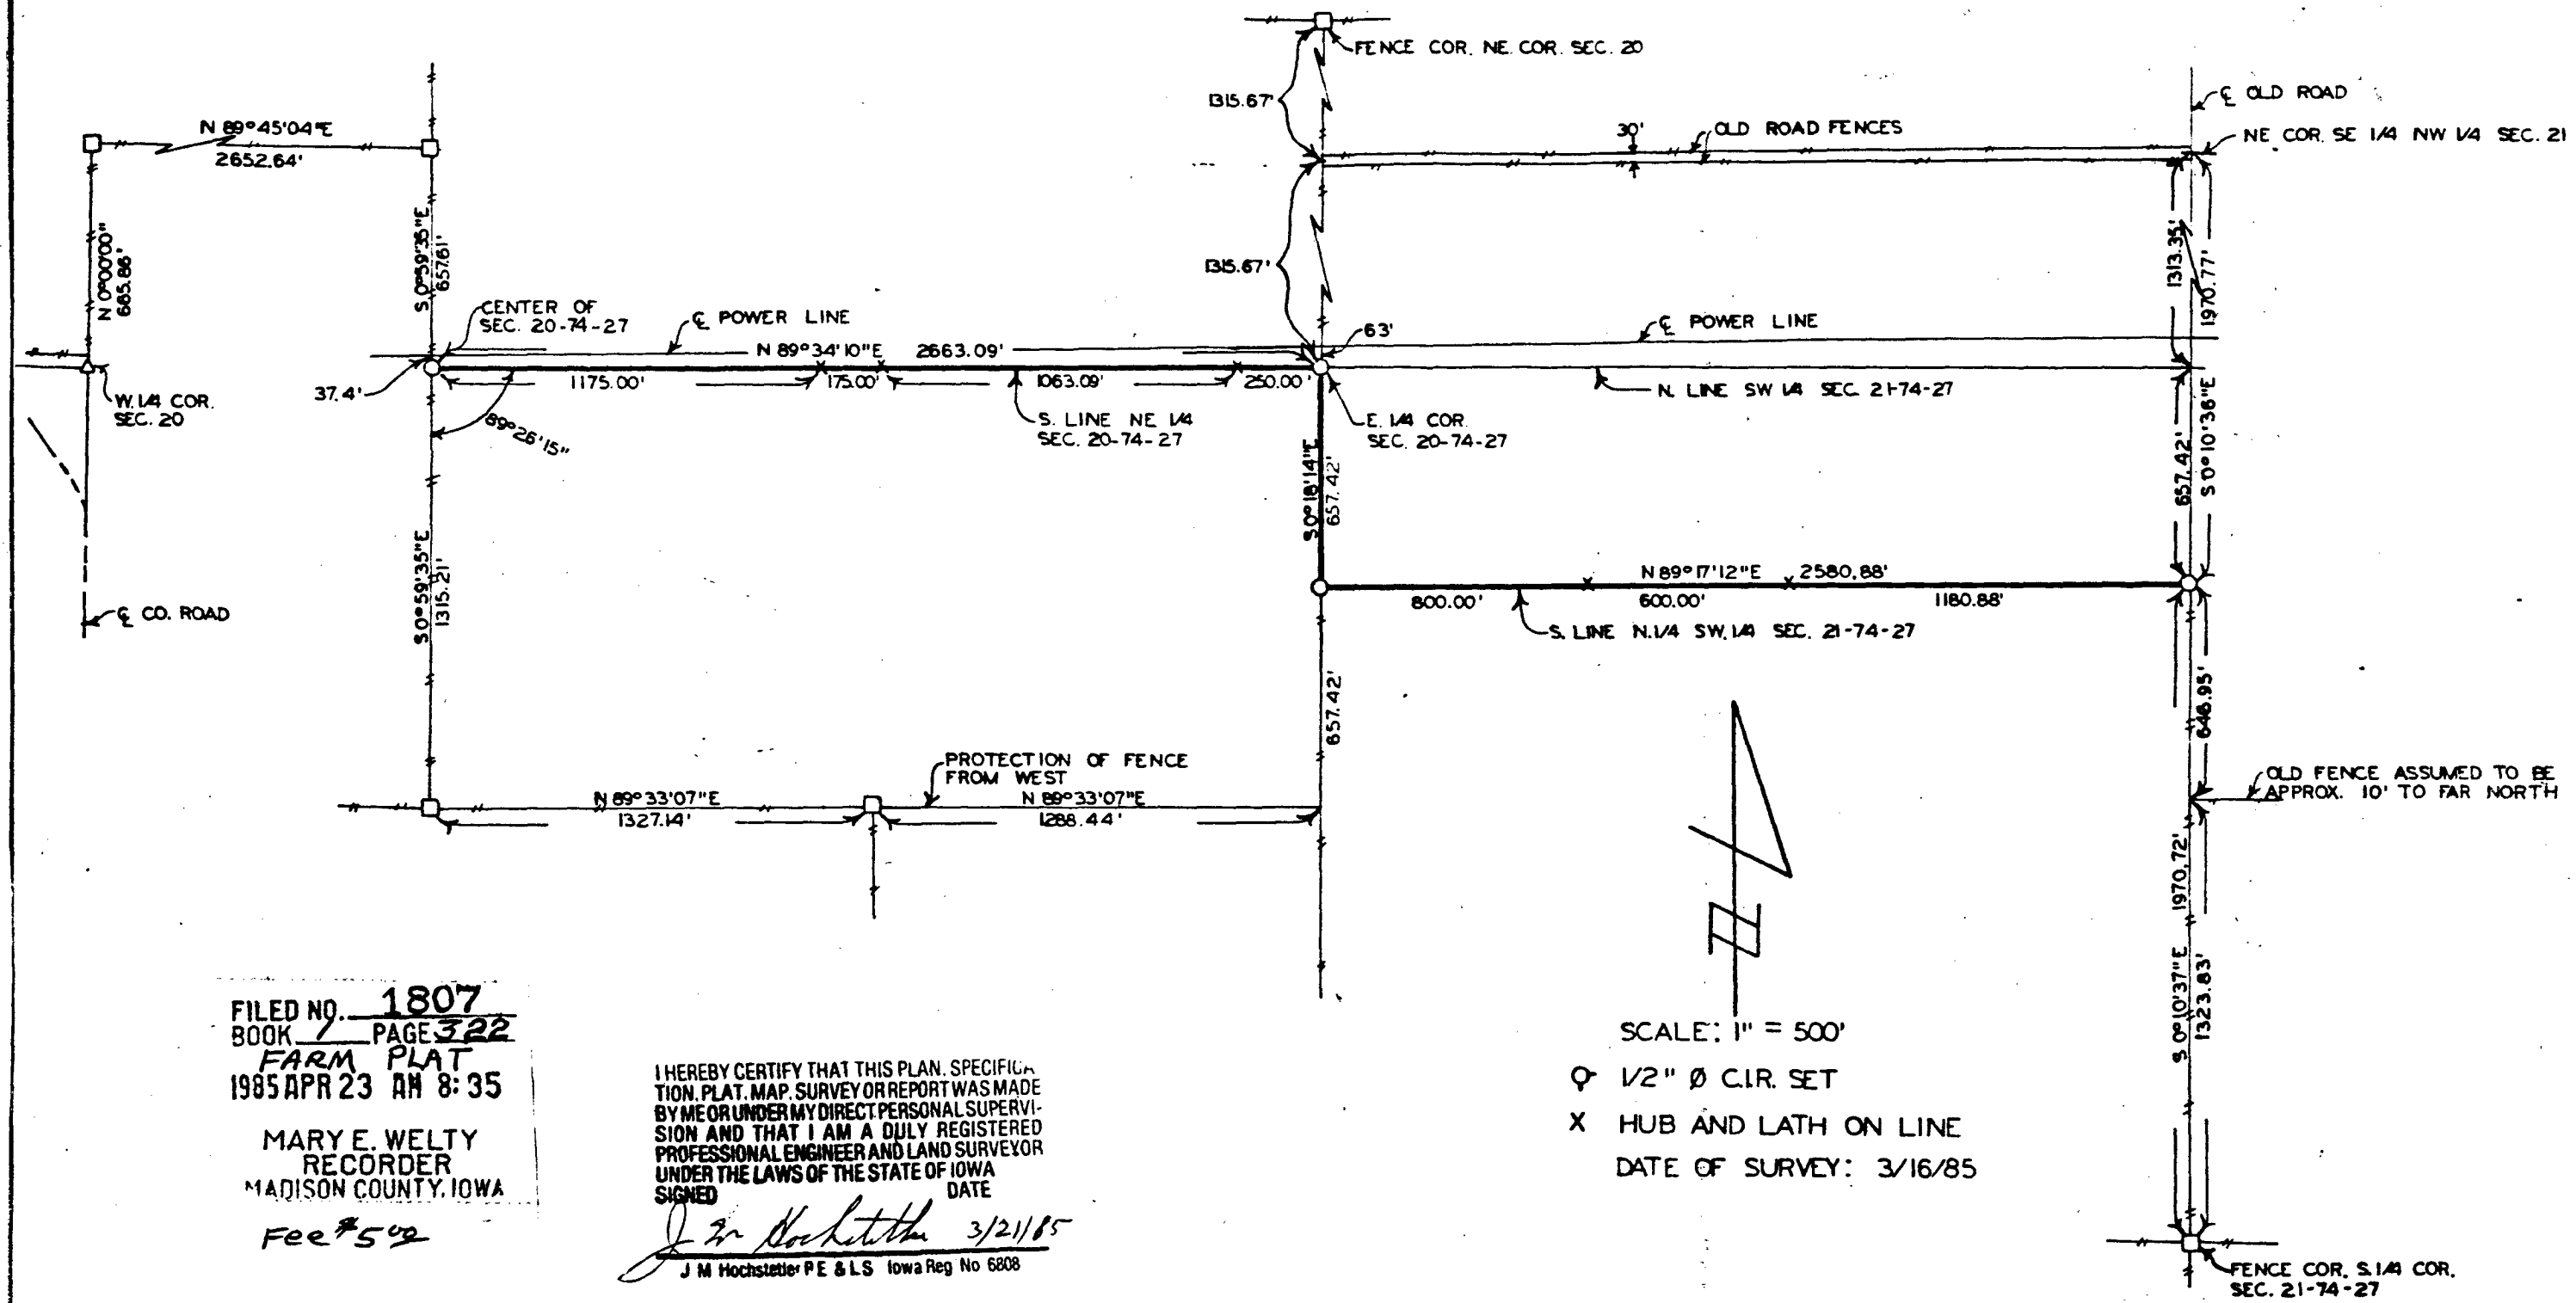

SCALE: 1" = 500'

⚲ 1/2" Ø C.I.R. SET

X HUB AND LATH ON LINE

DATE OF SURVEY: 3/16/85

FILED NO. 1807
BOOK 1 PAGE 322
FARM PLAT
1985 APR 23 AM 8:35

MARY E. WELTY
RECORDER
MADISON COUNTY, IOWA

Fee $5.00

I HEREBY CERTIFY THAT THIS PLAN, SPECIFICATION, PLAT, MAP, SURVEY OR REPORT WAS MADE BY ME OR UNDER MY DIRECT PERSONAL SUPERVISION AND THAT I AM A DULY REGISTERED PROFESSIONAL ENGINEER AND LAND SURVEYOR UNDER THE LAWS OF THE STATE OF IOWA

SIGNED J M Hochstetler DATE 3/21/85

J M Hochstetler P.E. & L.S. Iowa Reg No 6808

VANCE & HOCHSTETLER, P.C.
CONSULTING ENGINEERS
WINTERSET, IOWA 50273