

16-75-28

Filed For Record the 12th day of December
A.D. 1923, at 4 10 P.M. Olive M. Garrison Recorder
Fee $.50 # 2668.

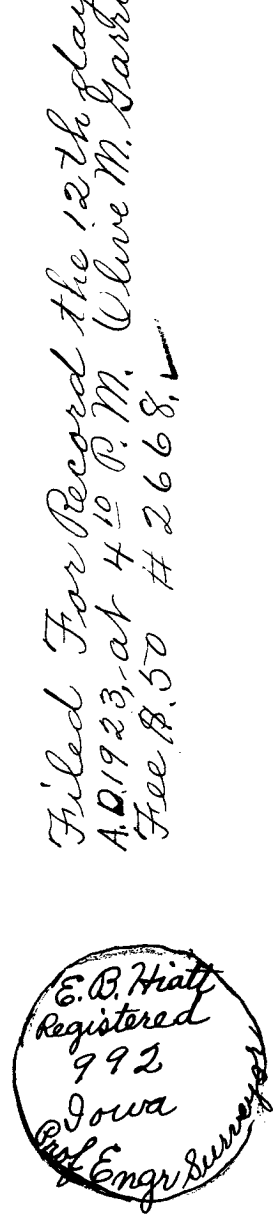

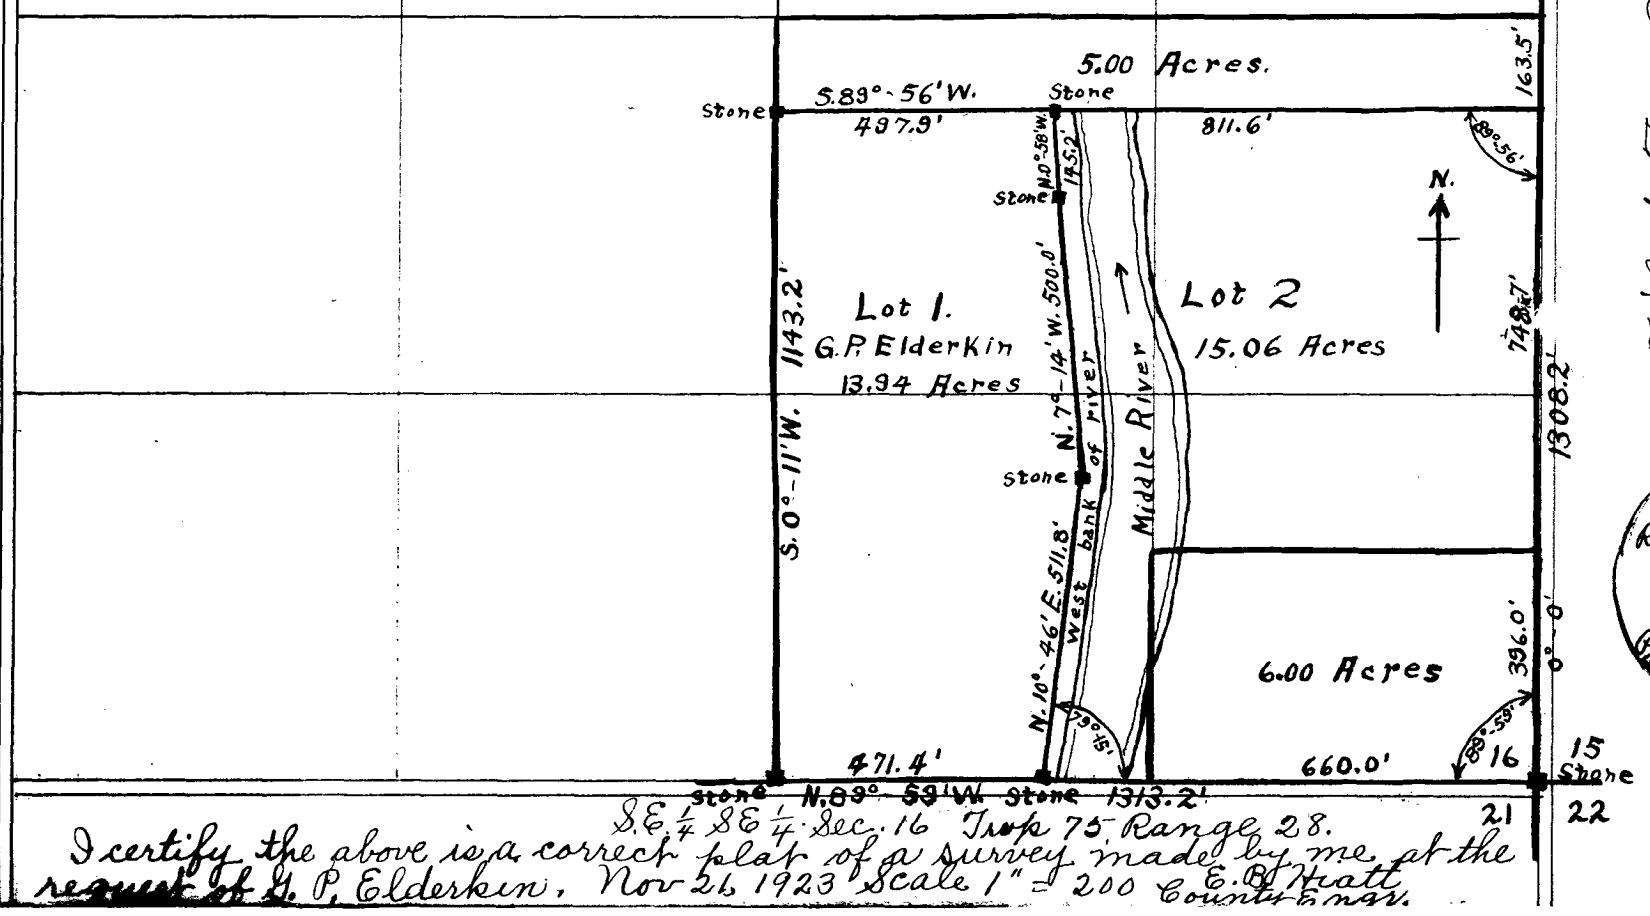

S.E. 1/4 S.E. 1/4 Sec. 16 Twp 75 Range 28.

I certify the above is a correct plat of a survey made by me at the request of G. P. Elderkin. Nov 26, 1923 Scale 1" = 200

E. B. Hiatt
County Engr.