
IRREGULAR SURVEY OF

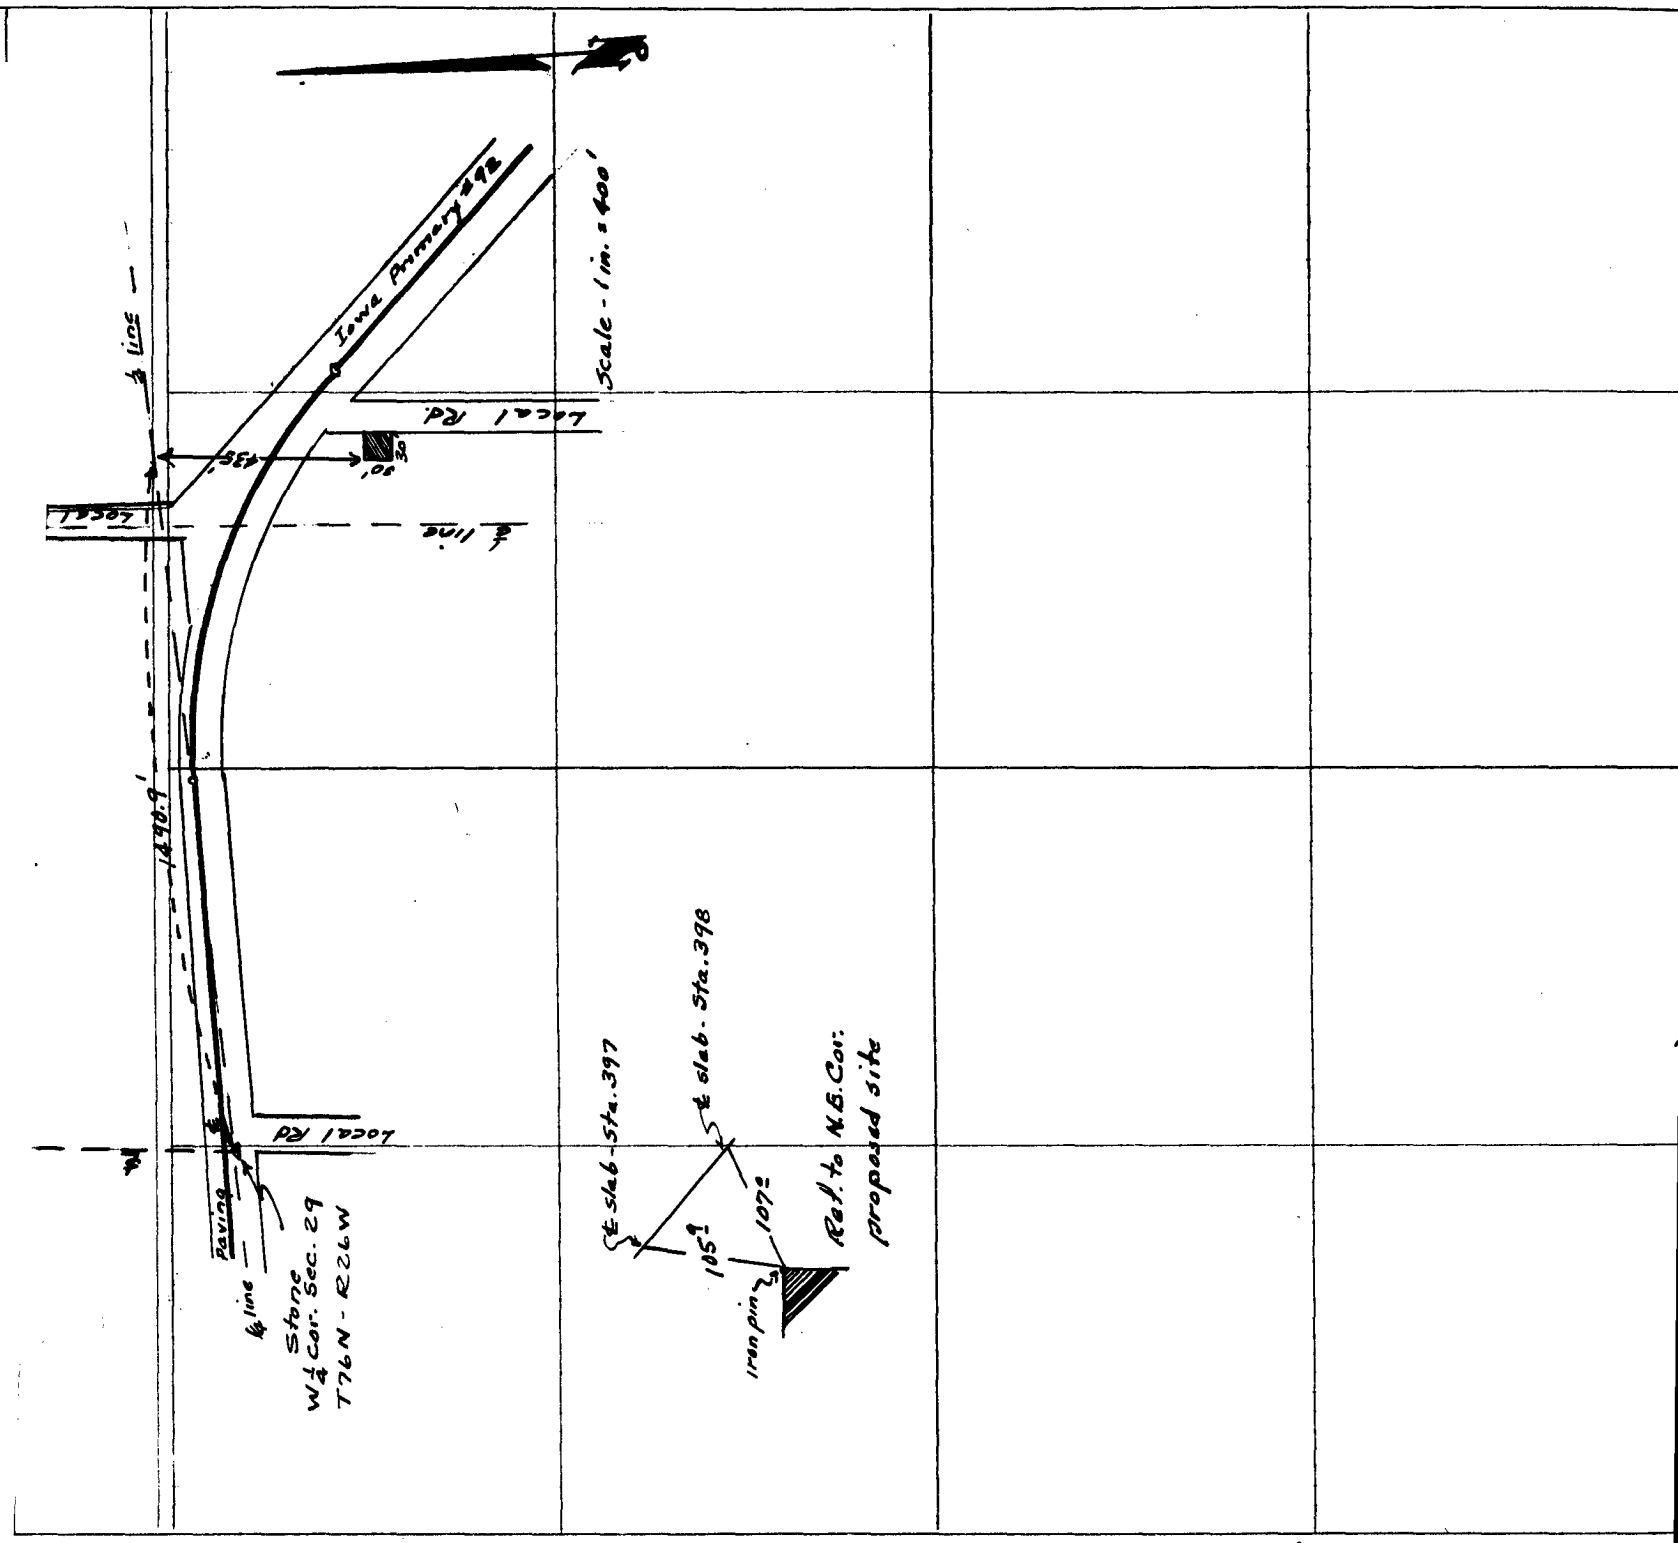

Desc

out
Bell
date

Date

80

COMPARED

Description of Northwestern Bell Telephone Company Site Patterson,
Commencing at the West Quarter corner of Section 29 T76N, R26W; thence
1490.9 feet; thence South 435.0 feet to the point of beginning; thence East 30.0 feet;
South 30.0 feet; thence West 30.0 feet; thence North 30.0 feet to the point of begin
Note: The East-West line through the center of the said section 29
as due East in describing this parcel of land.

Surveyed By:
P. W. McQueen
S. N. McQueen

June 27, 1946
(Surveyors Seal)
3279

Filed for record the 29 day of July A.D. 1946 at 5:00 o'clo

Pearl E. Shetterly, Recorder
Fee $.50

nce
tion,
nning.

eloch P. M.
E. Shetterly, Recorder
ee $.50

COMPARED